

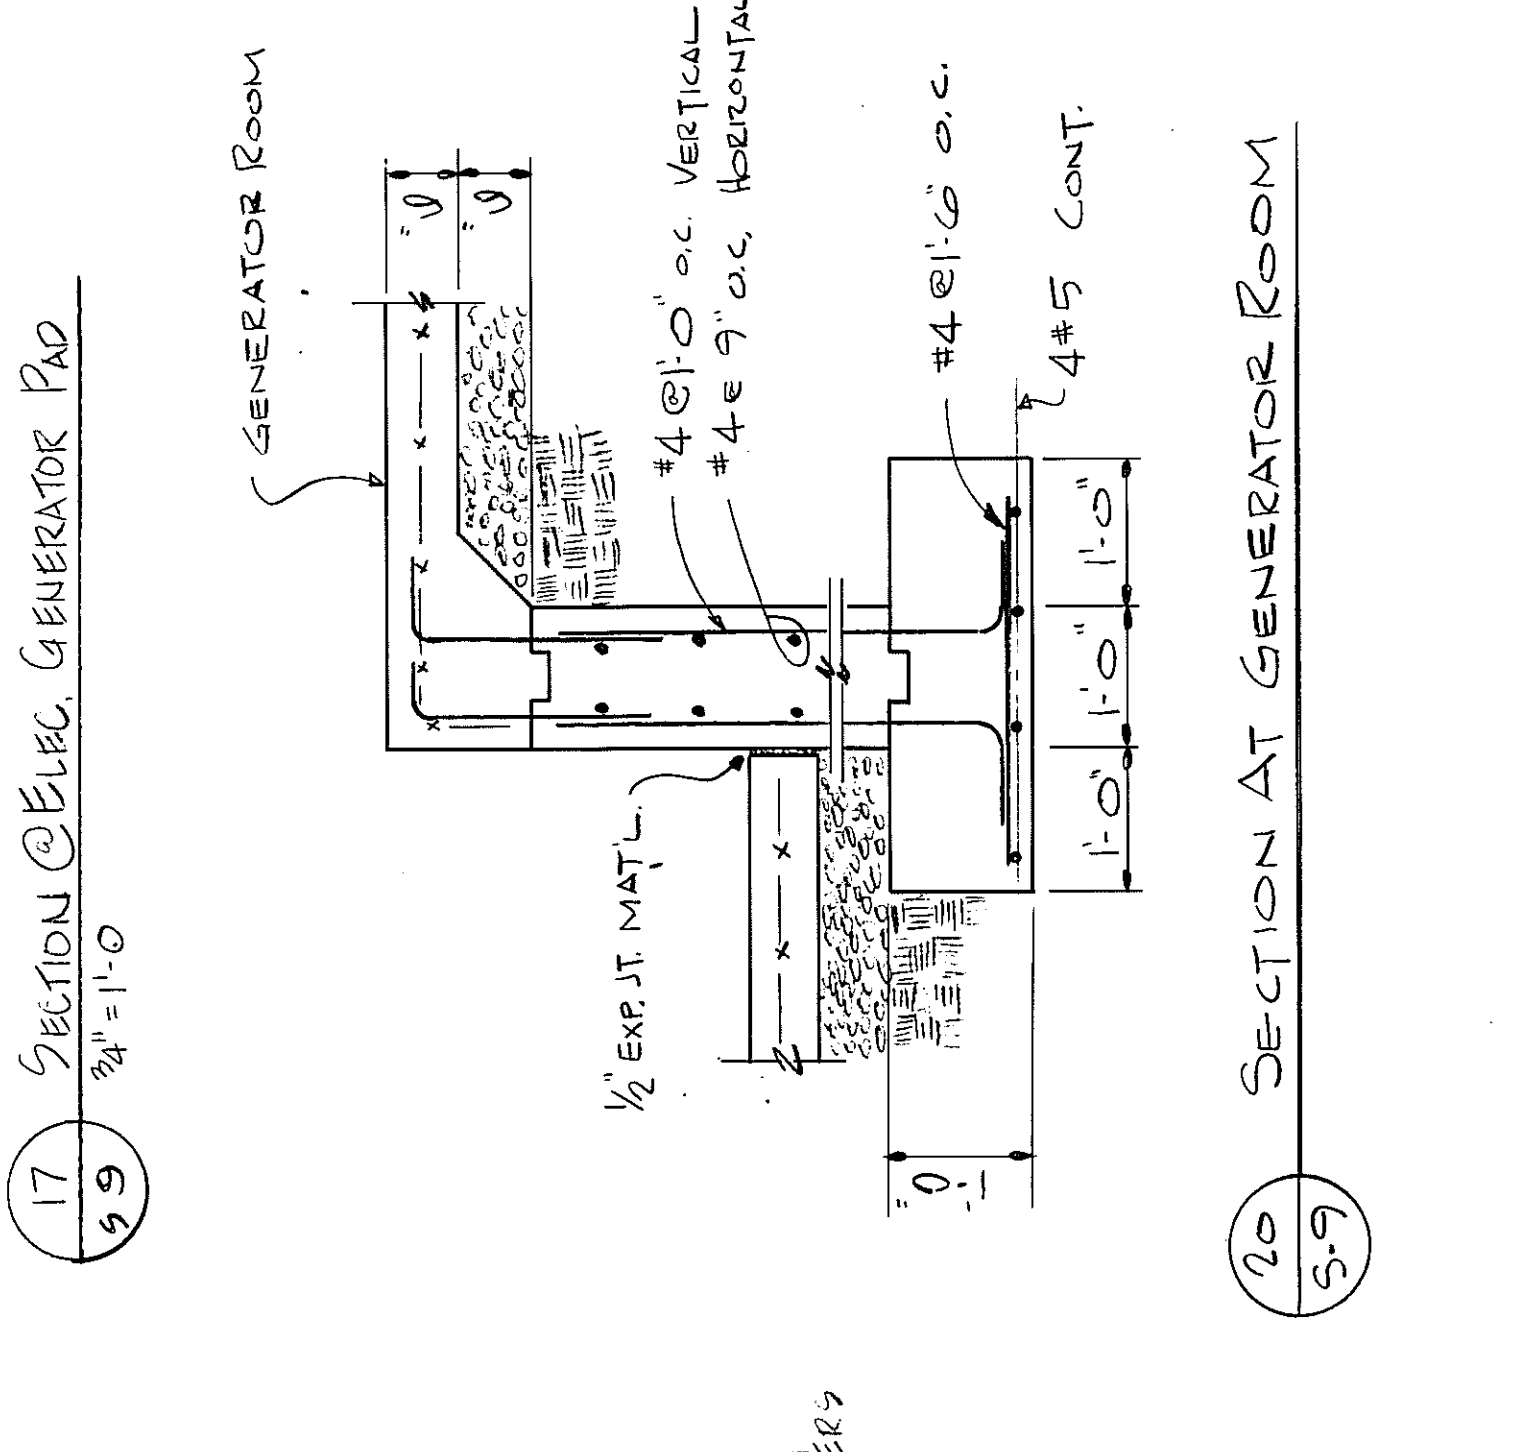
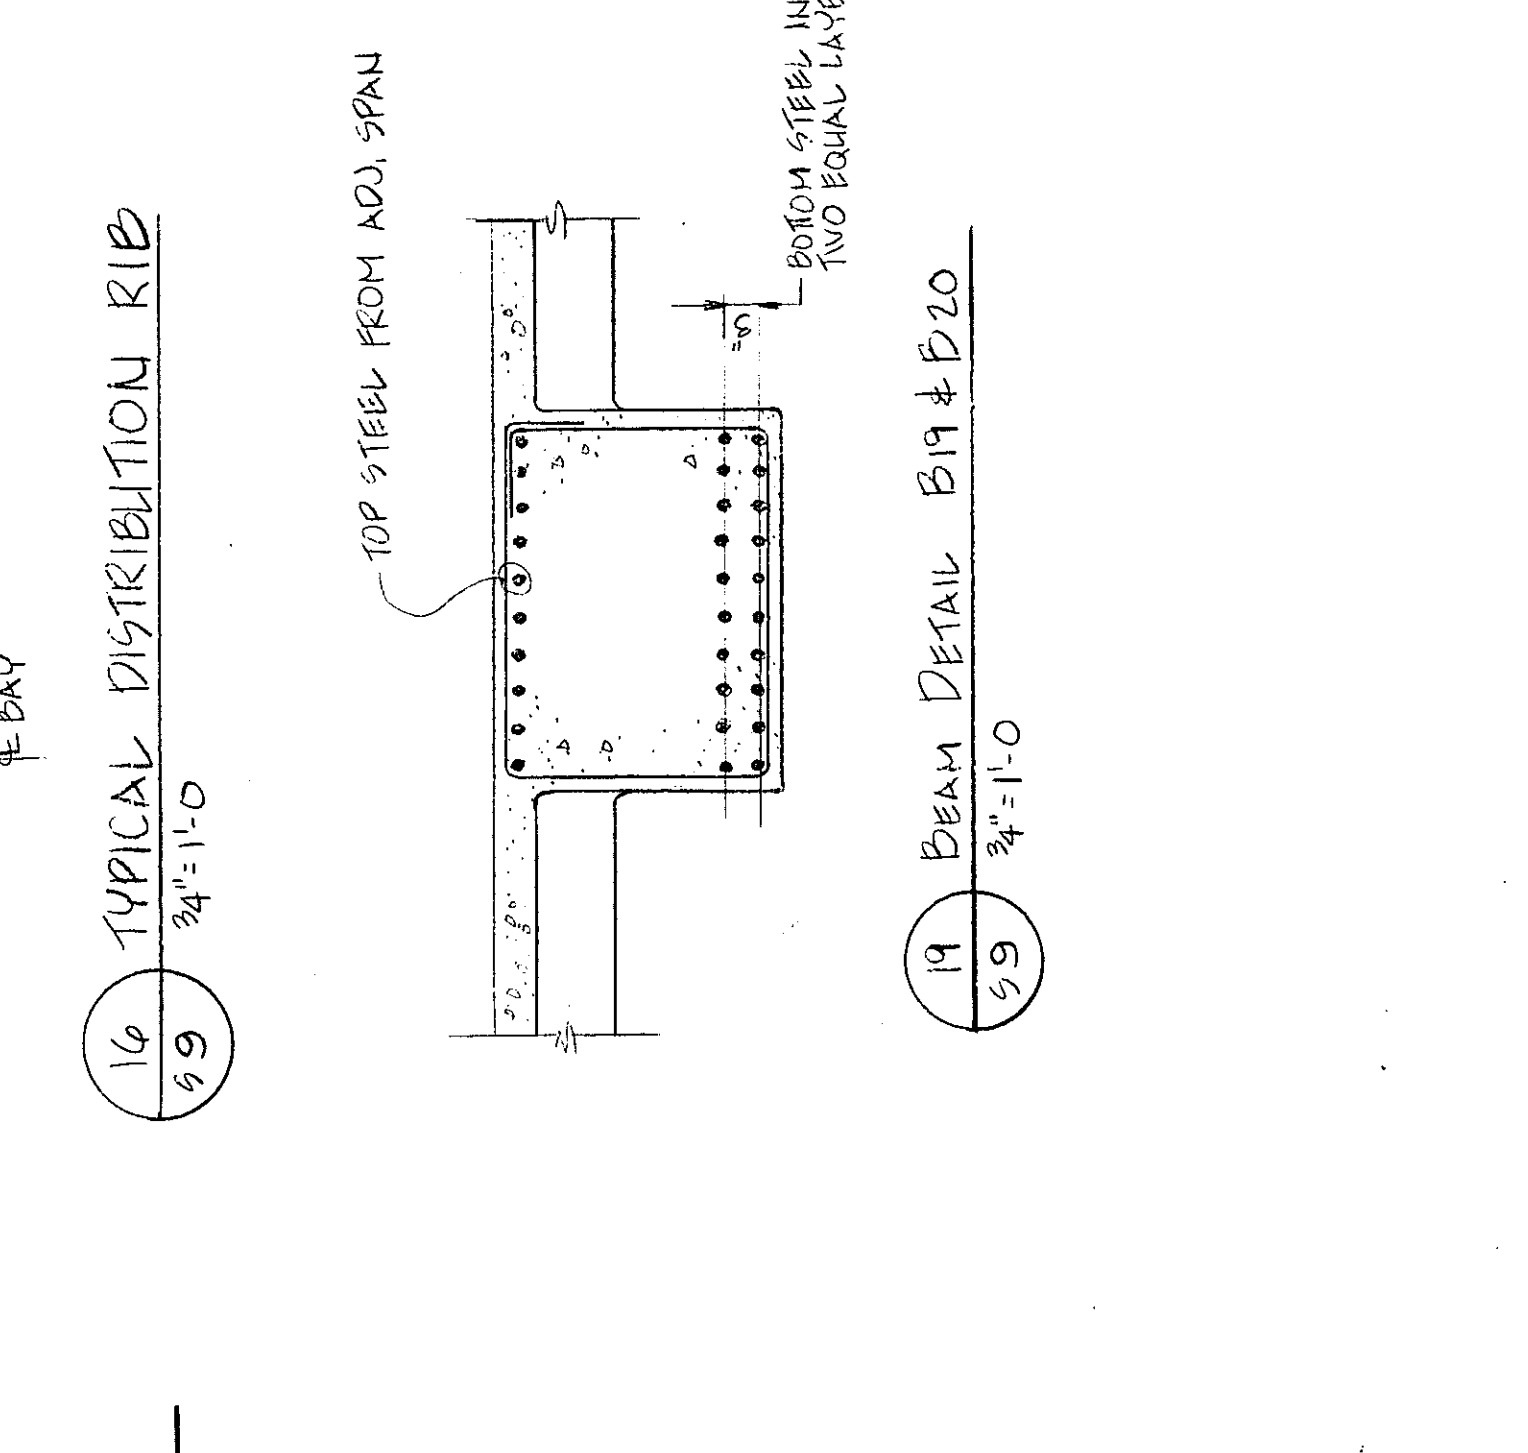
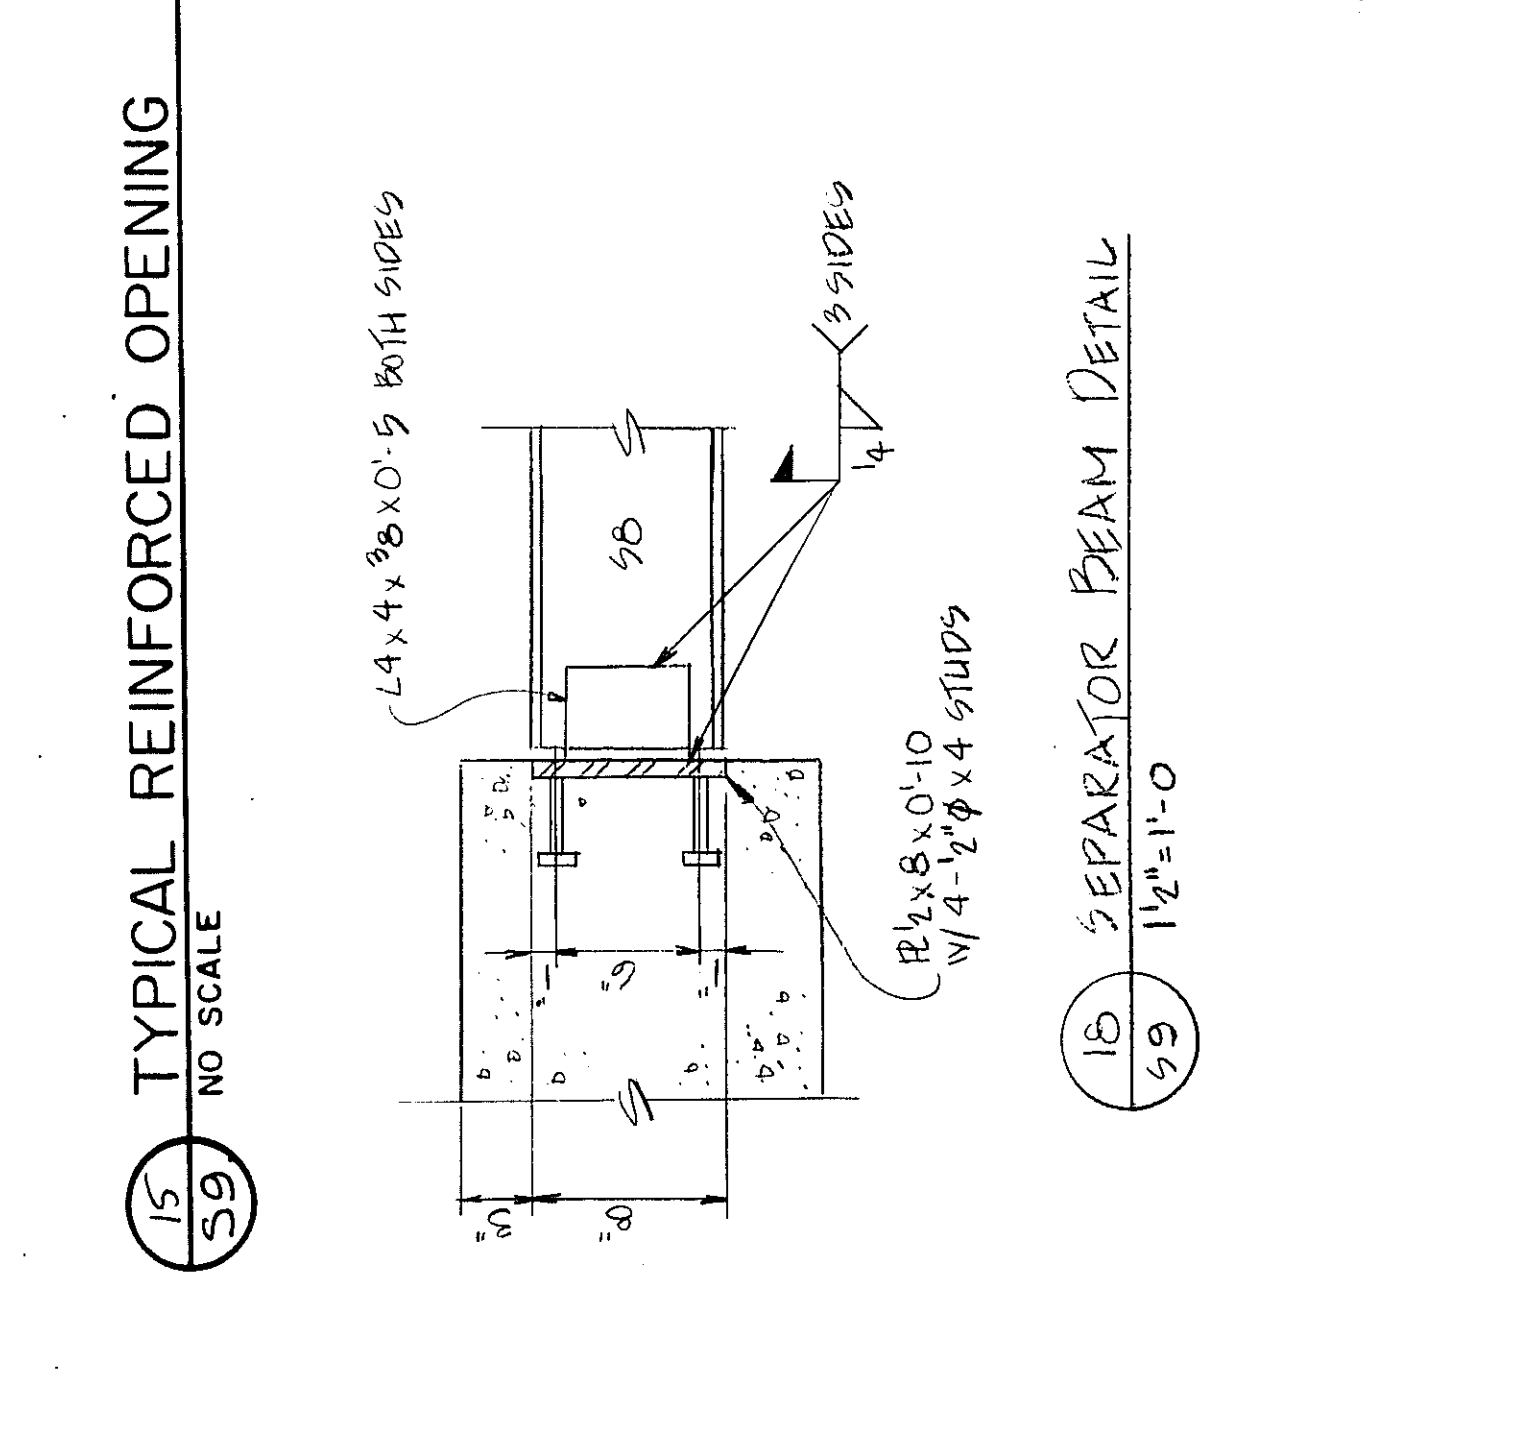
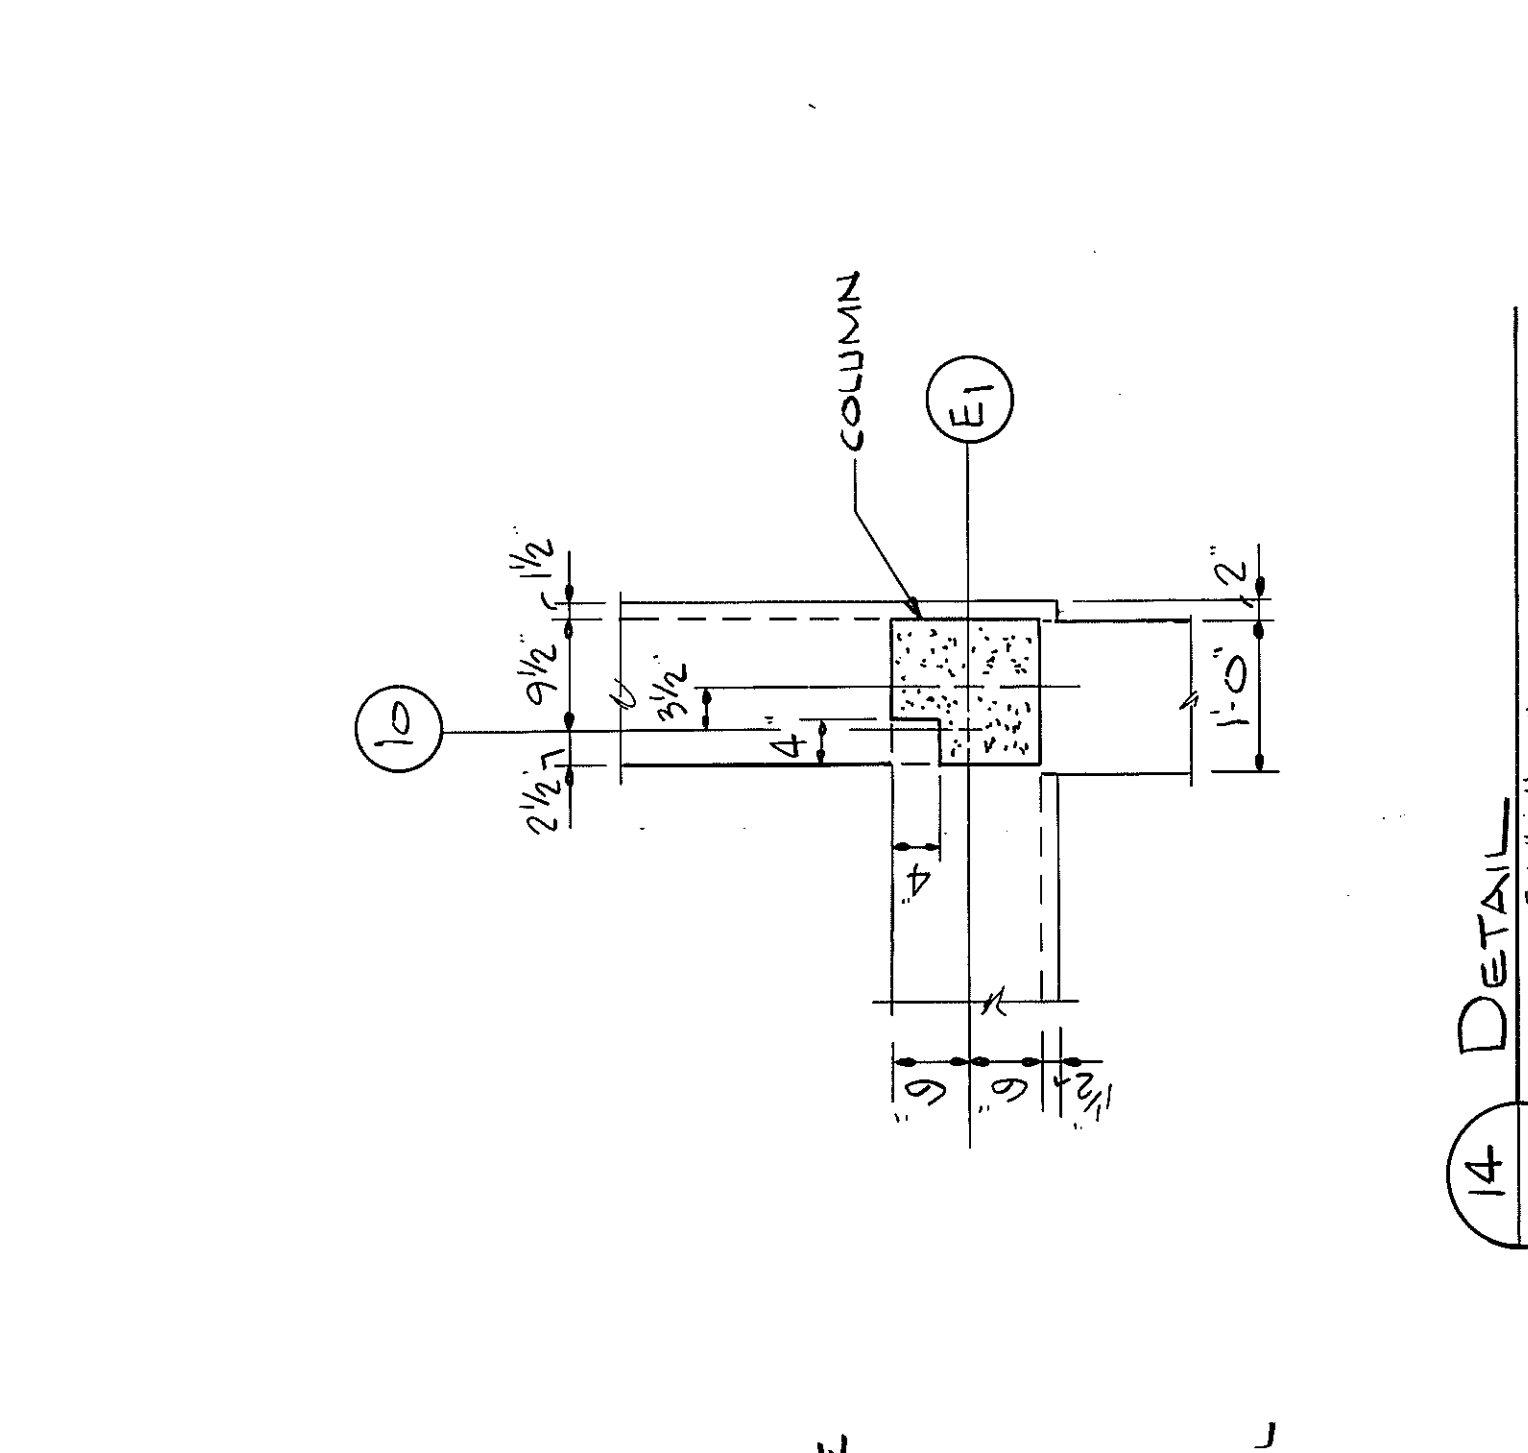
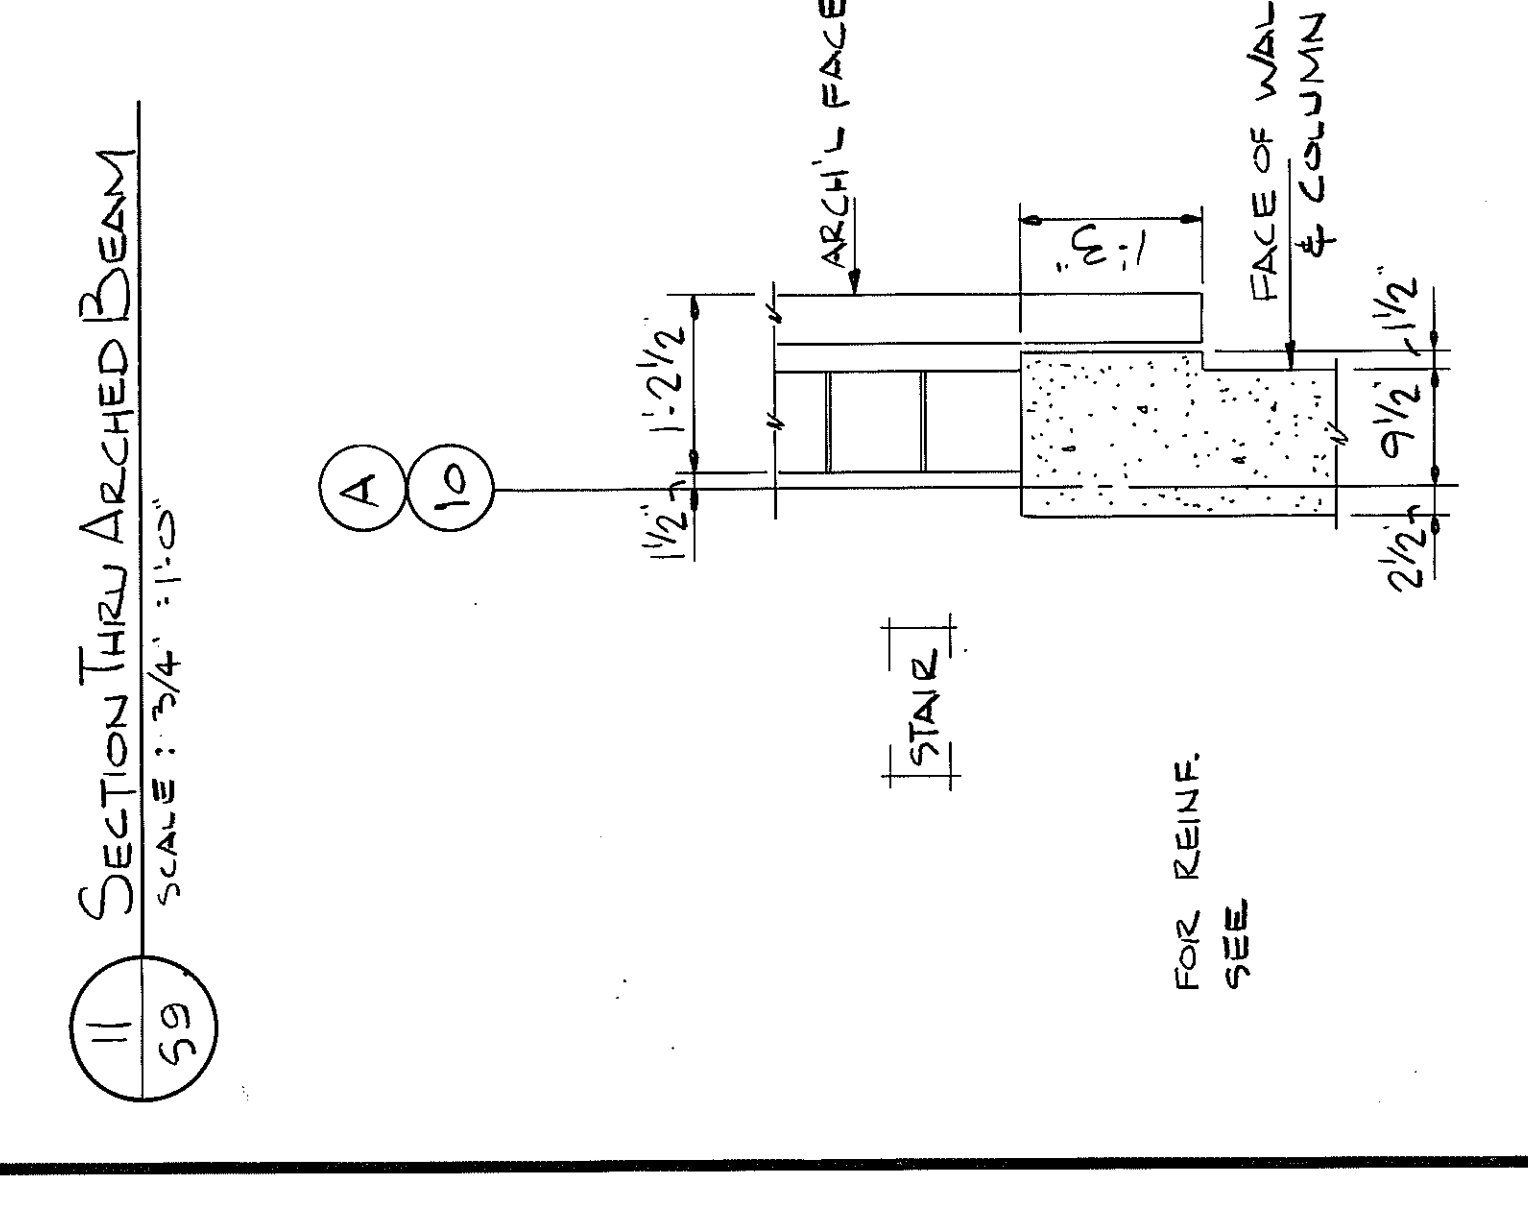
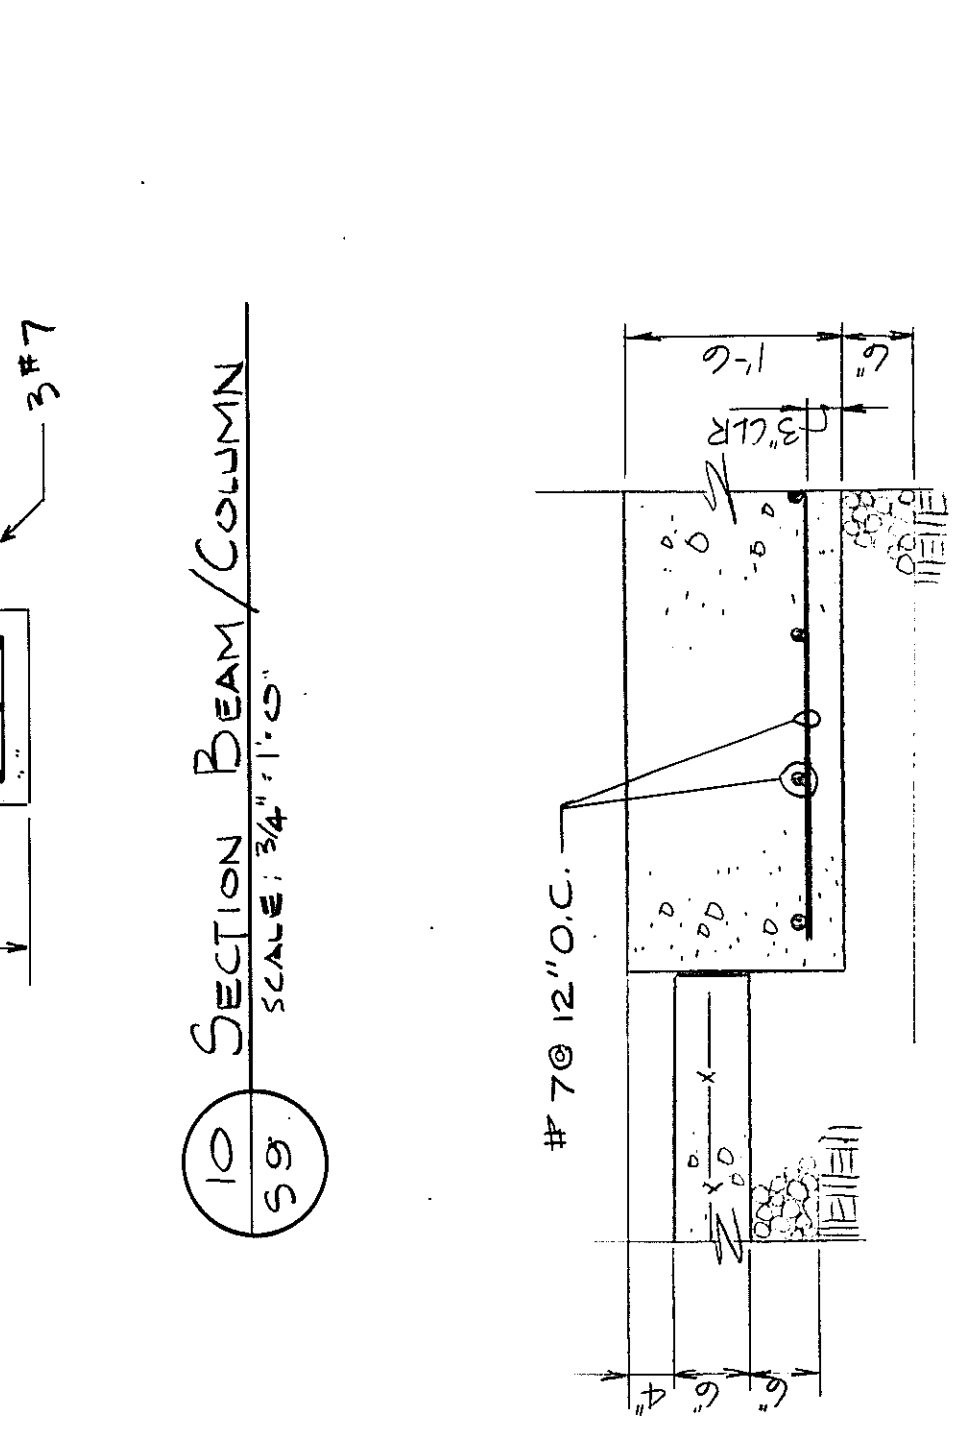
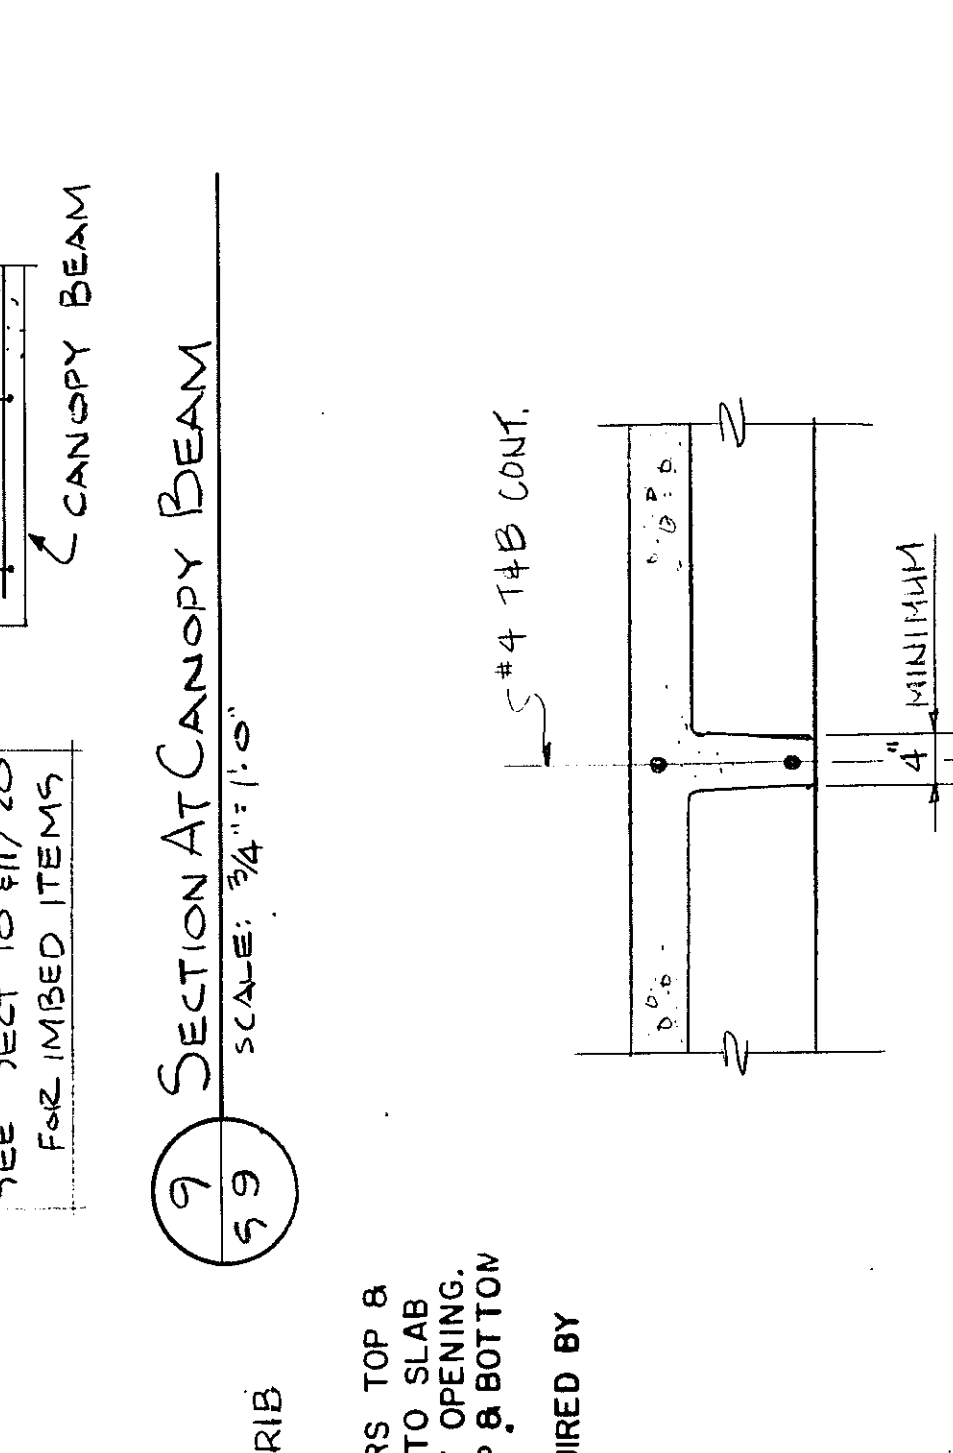
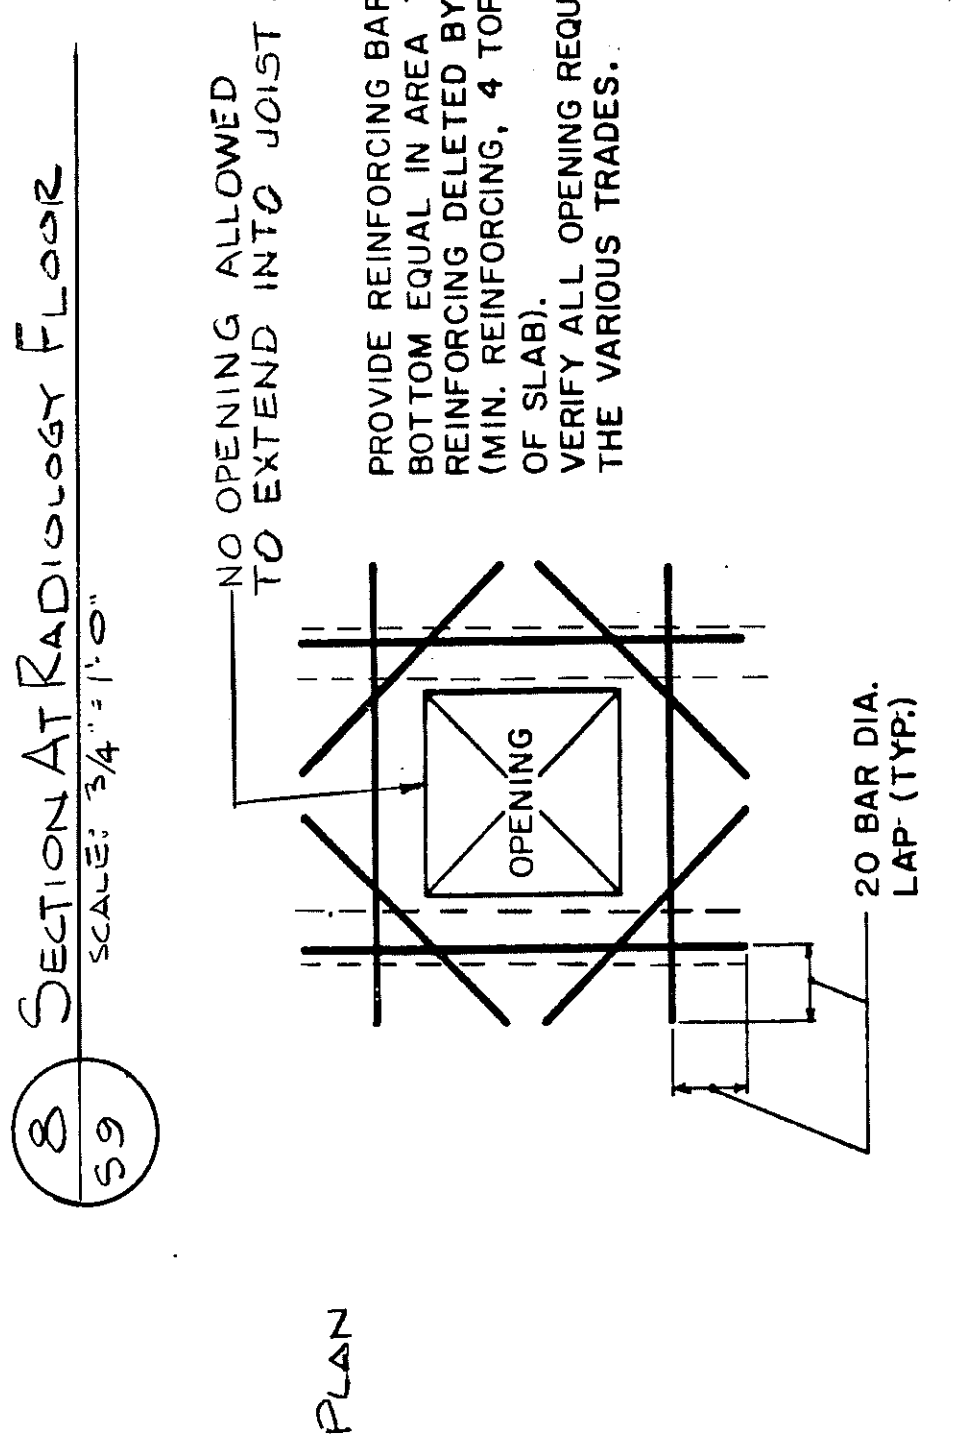
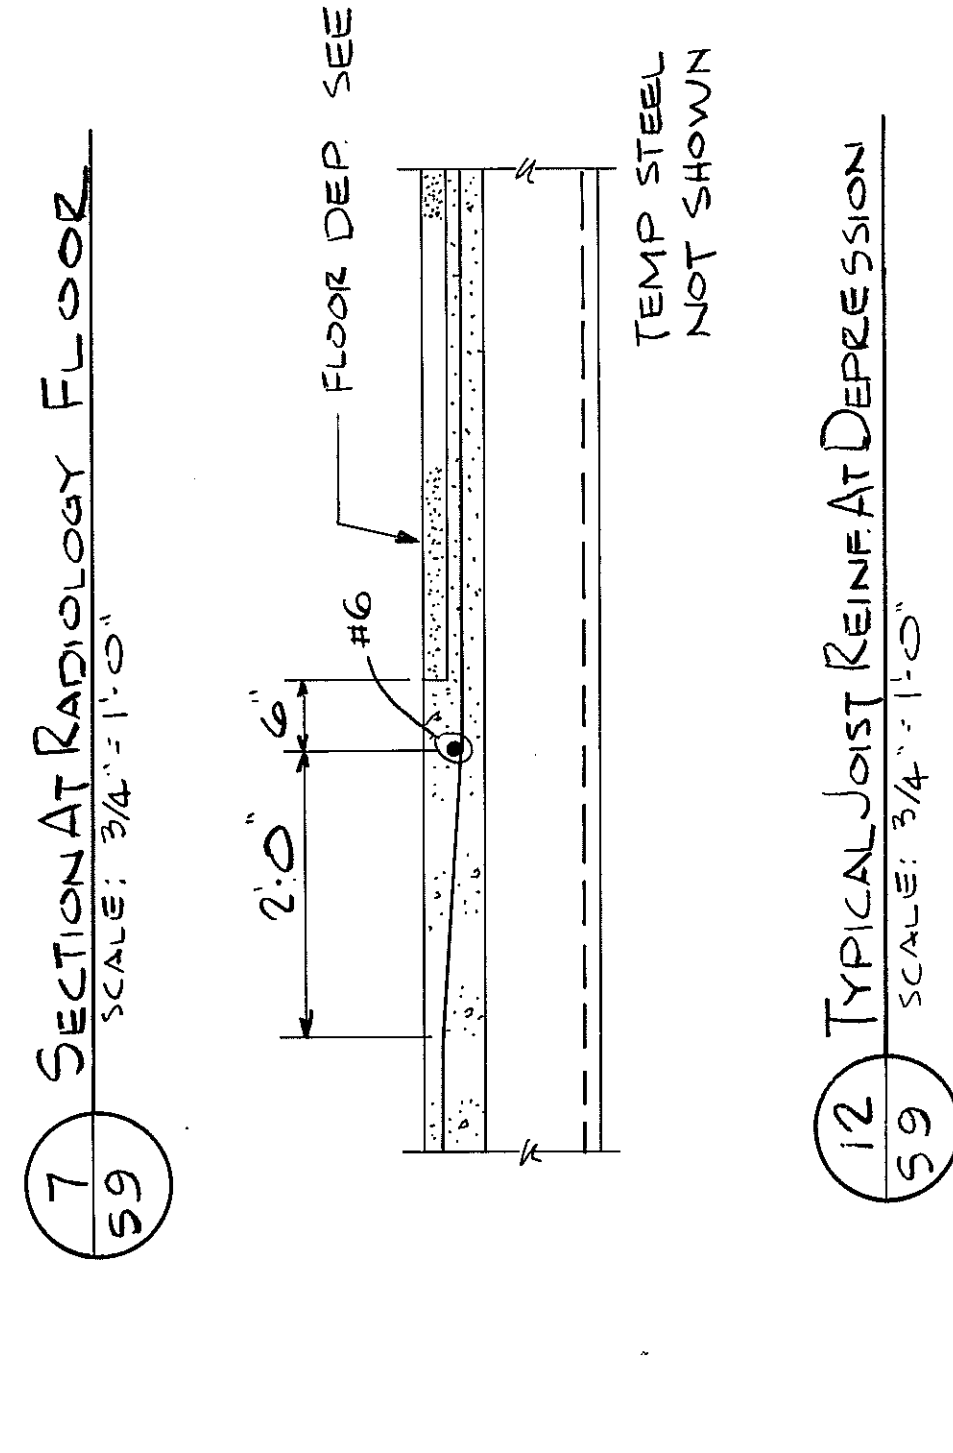
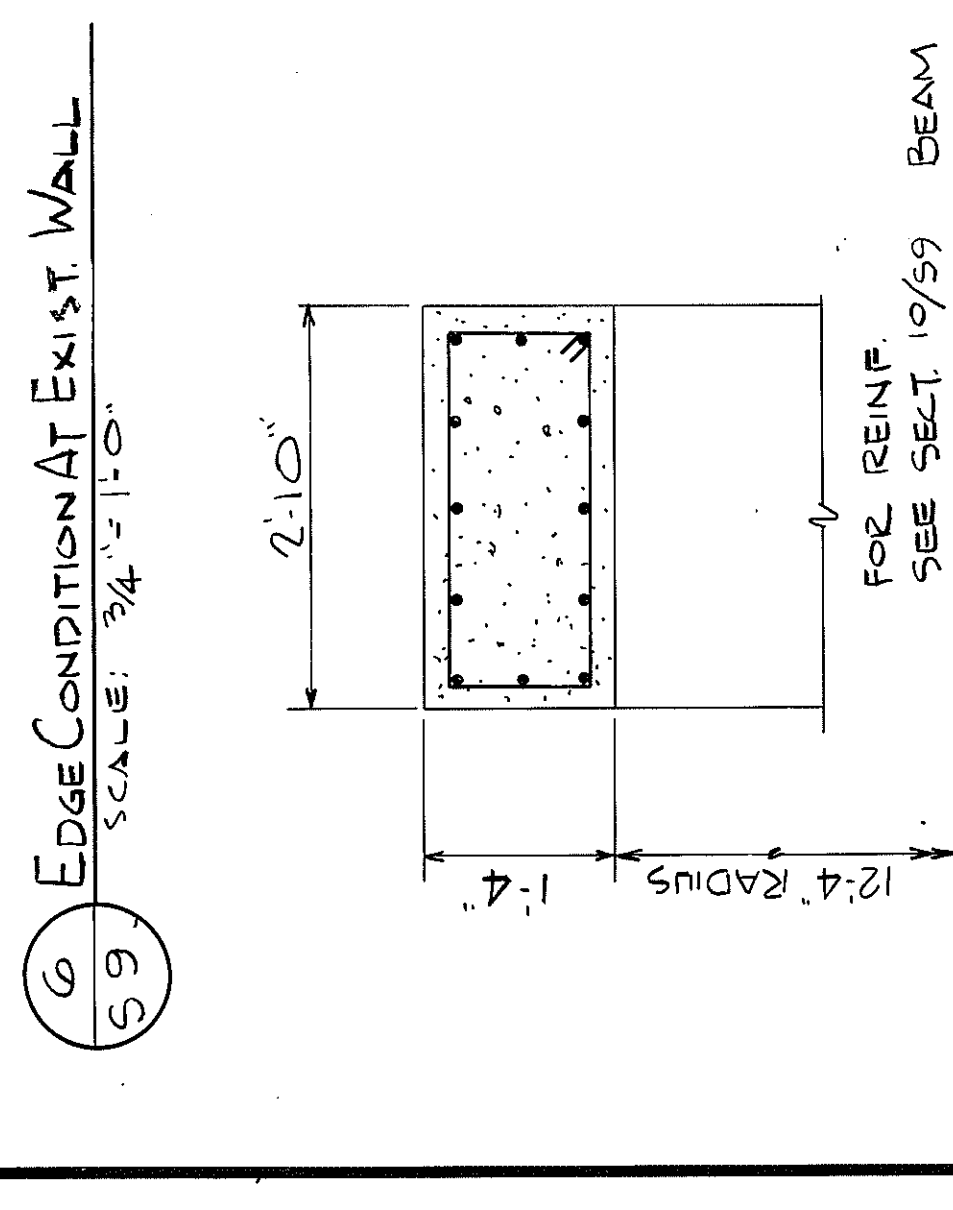
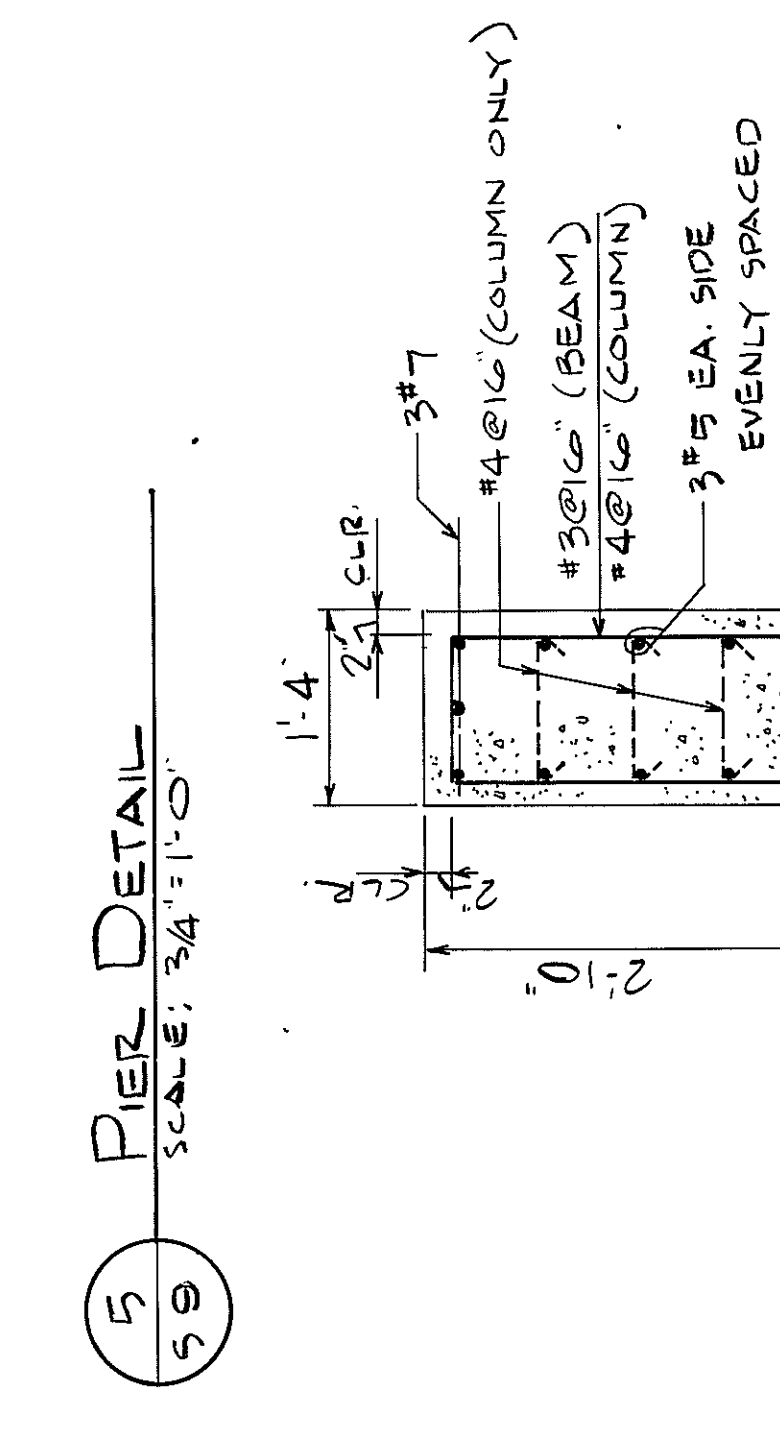
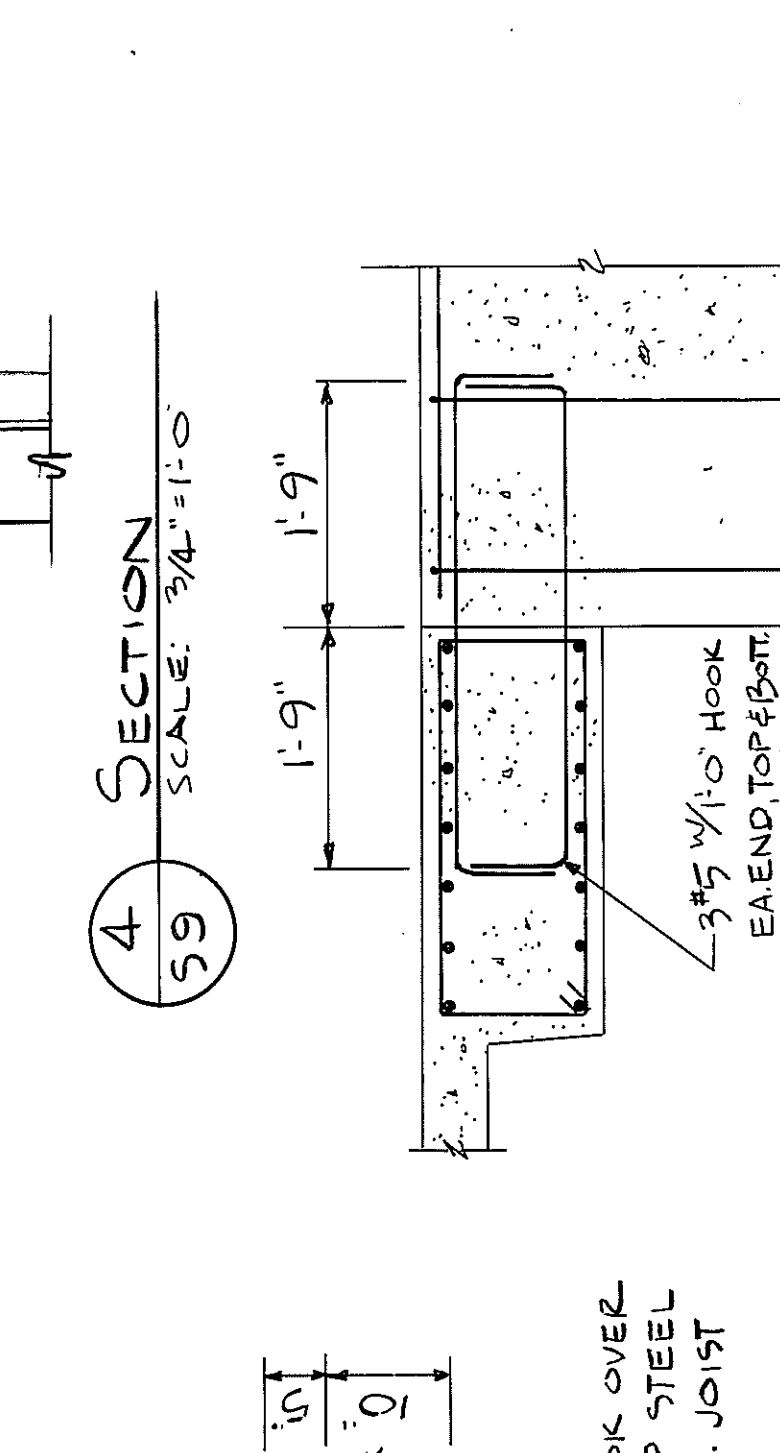
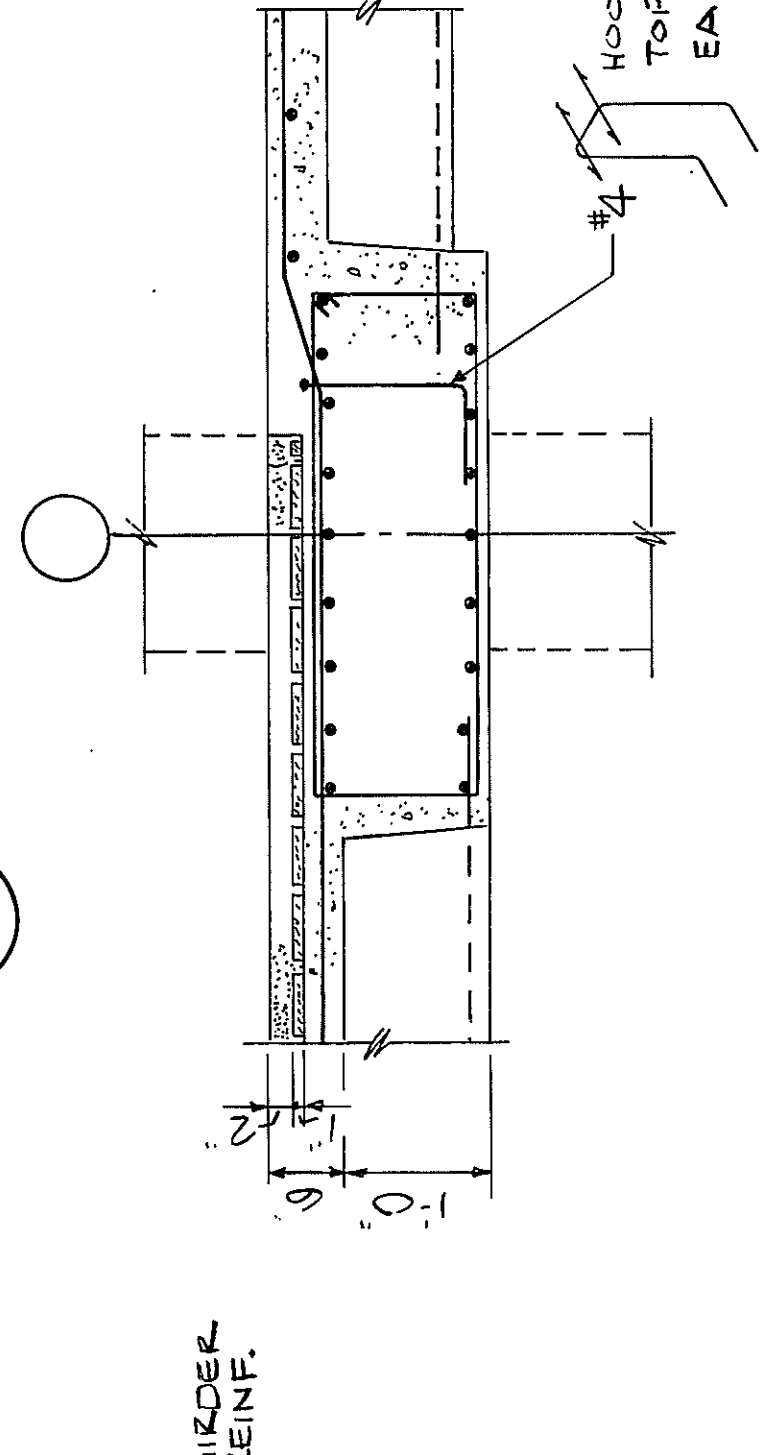
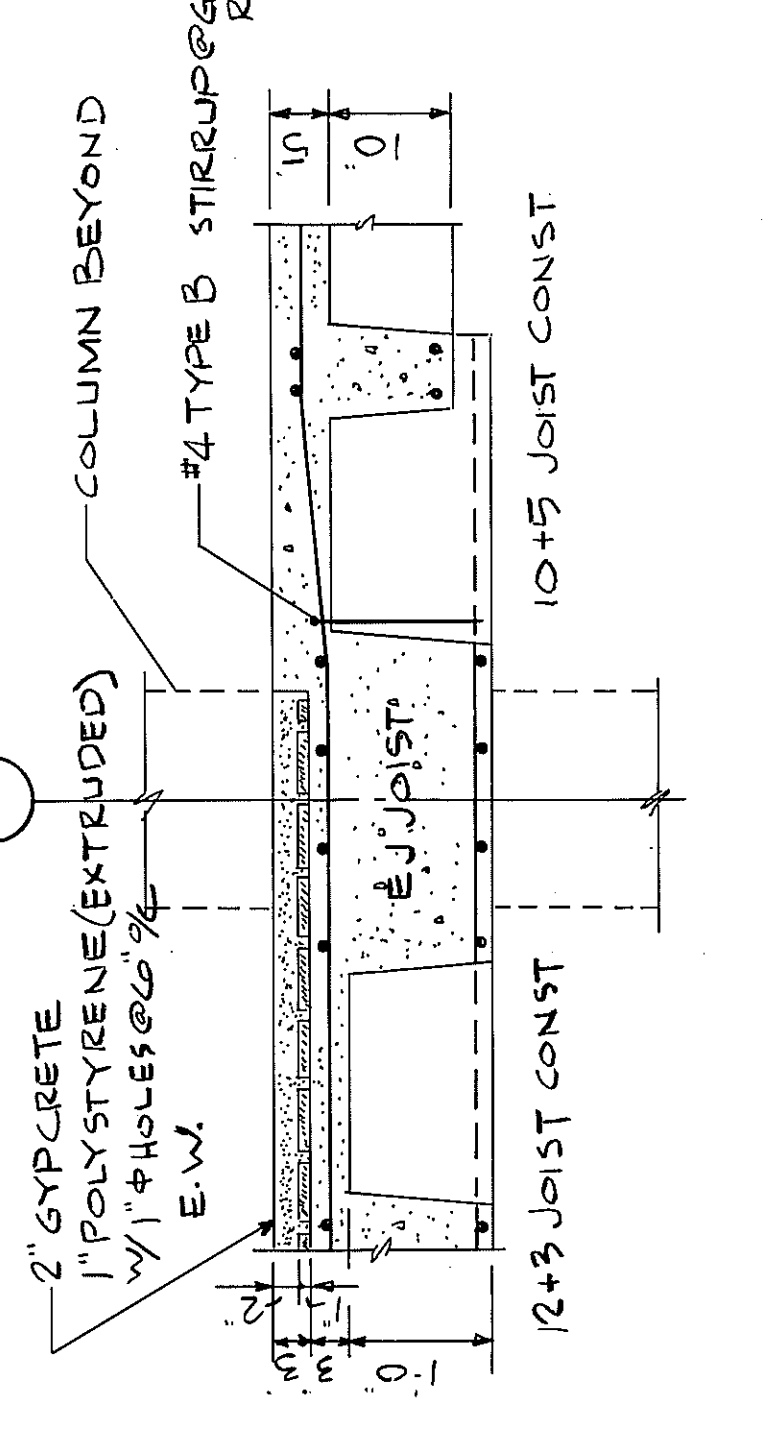
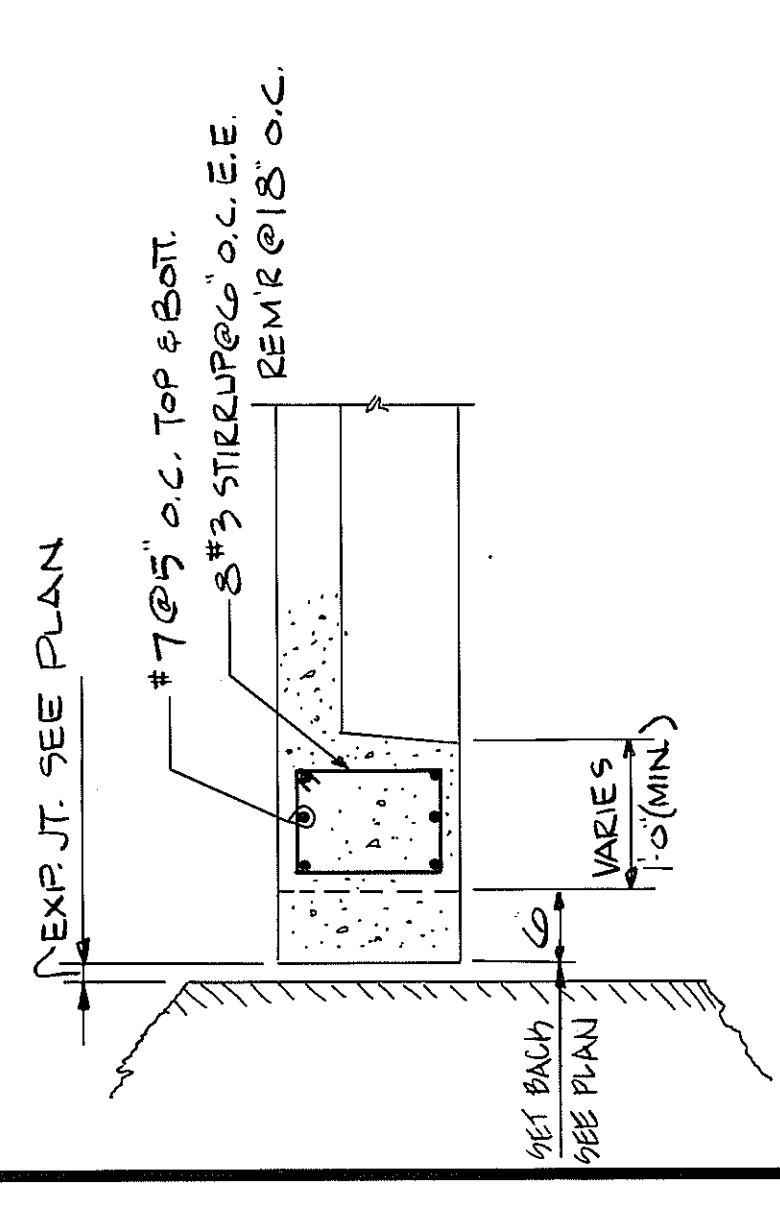
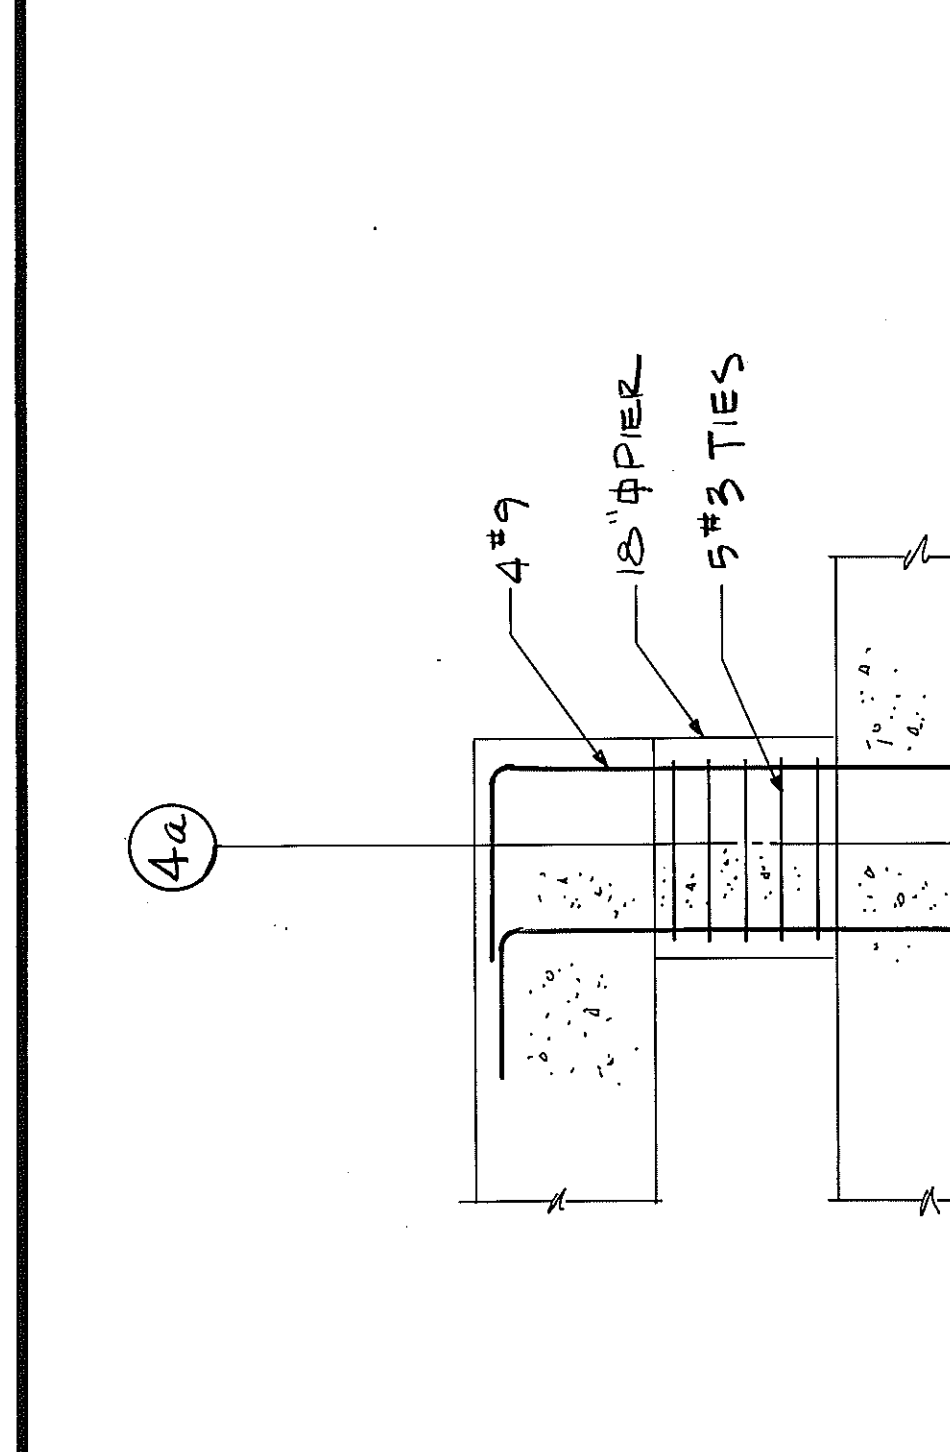
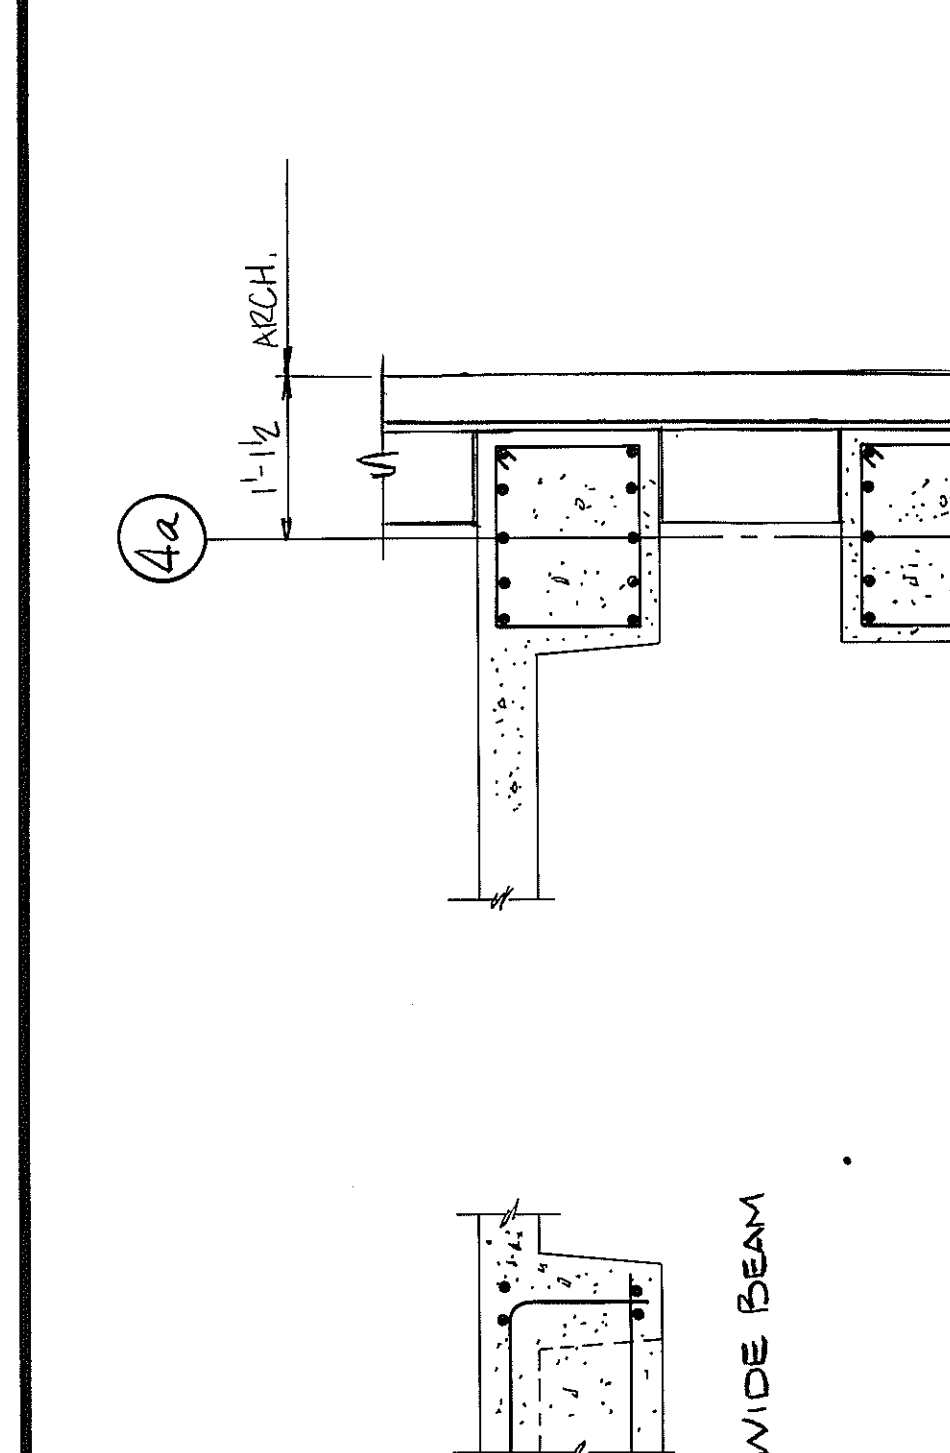
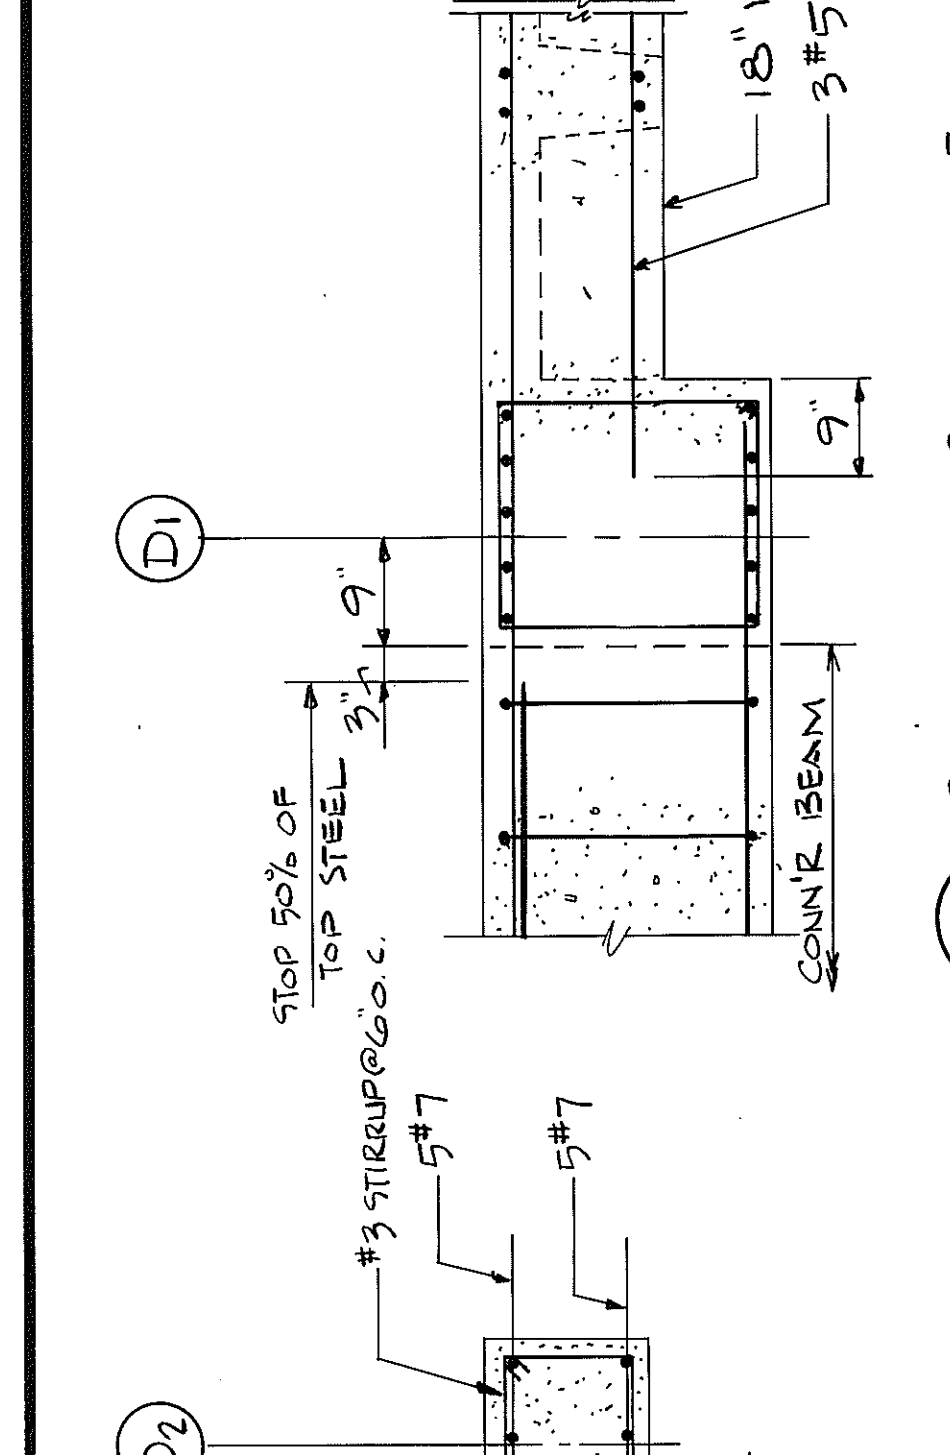
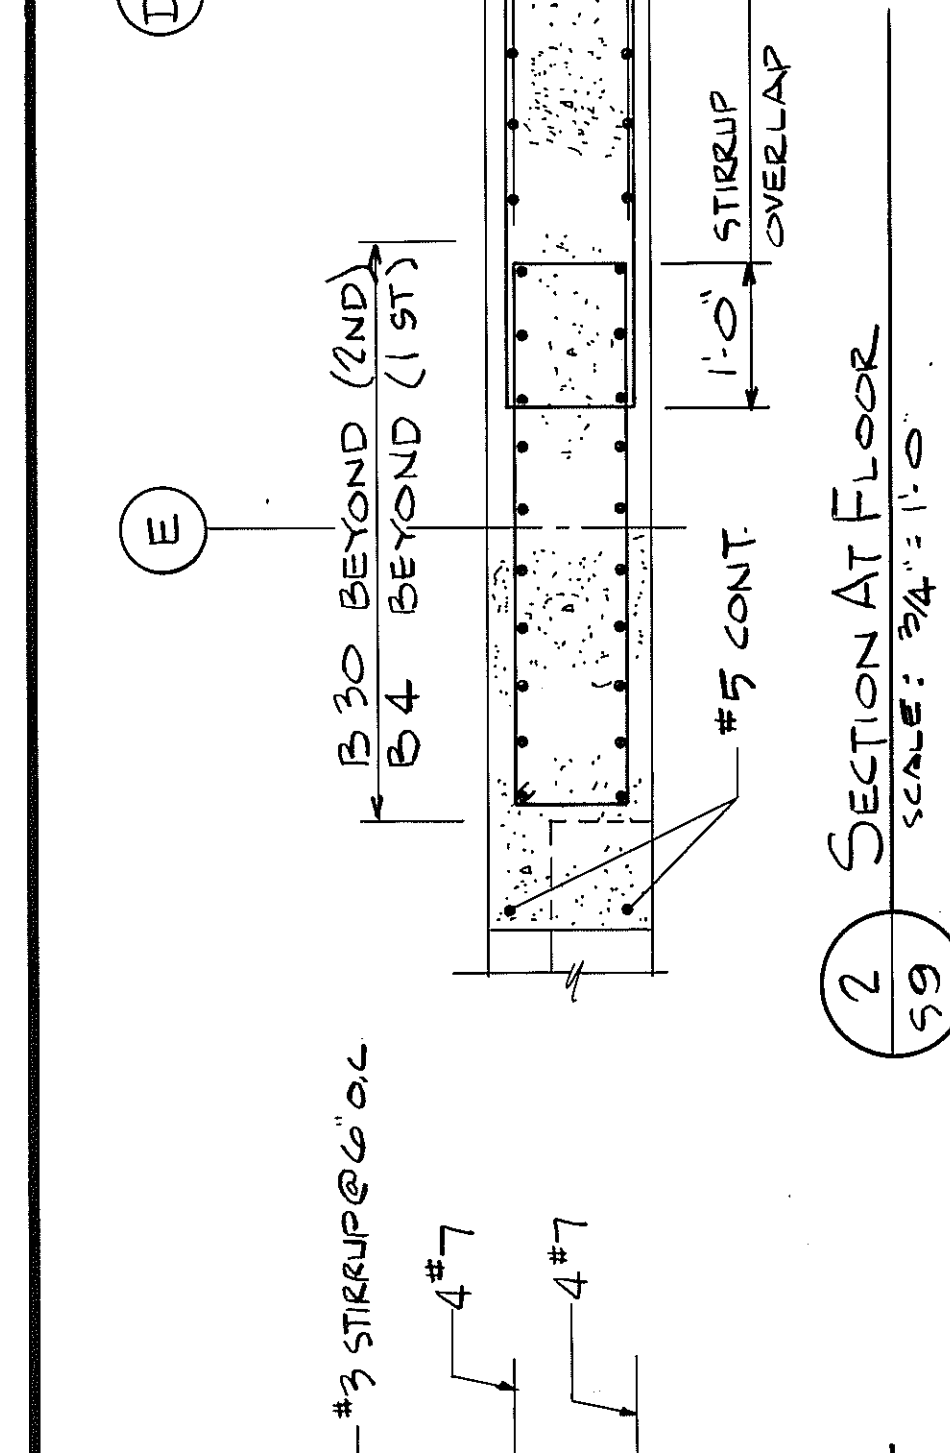
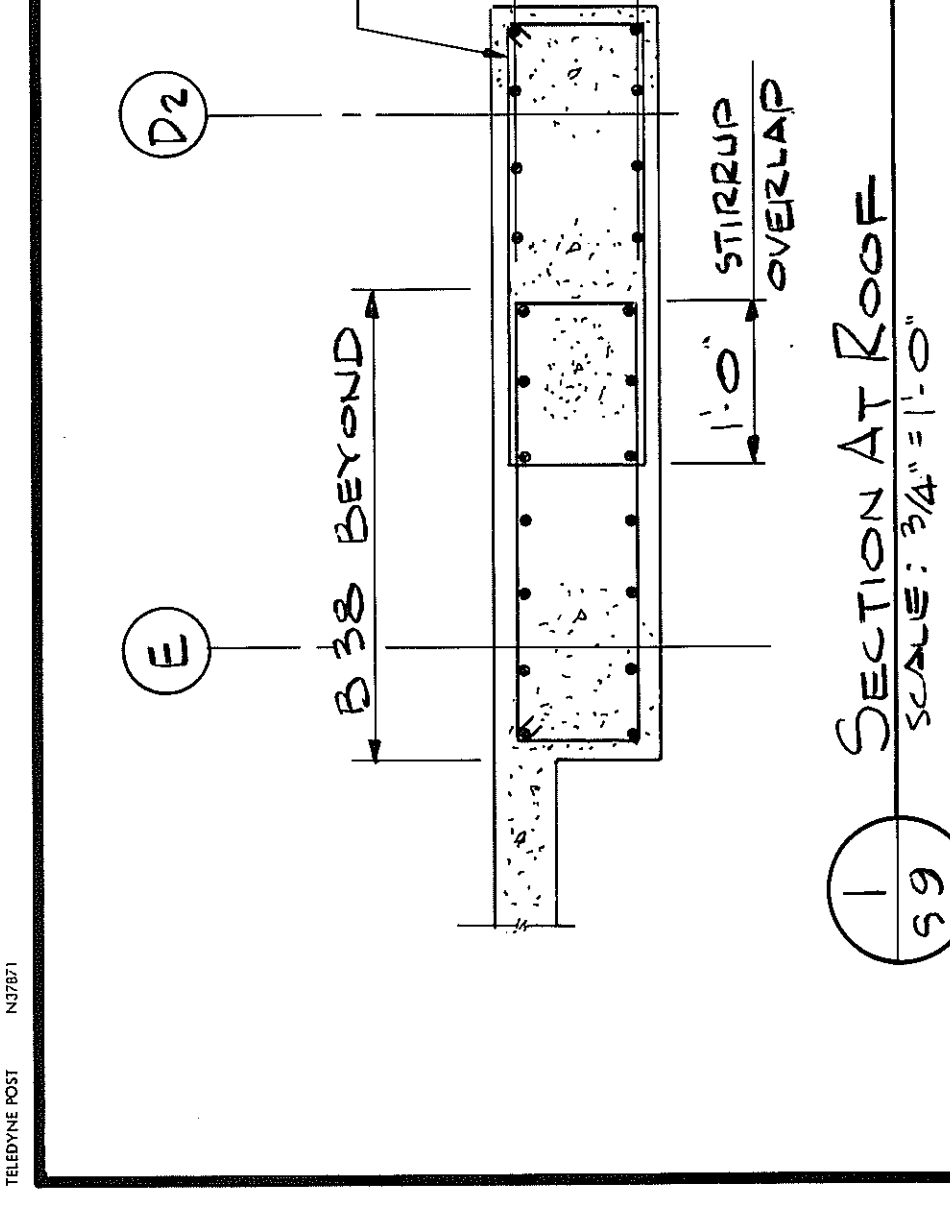


TEMPERING ROOM

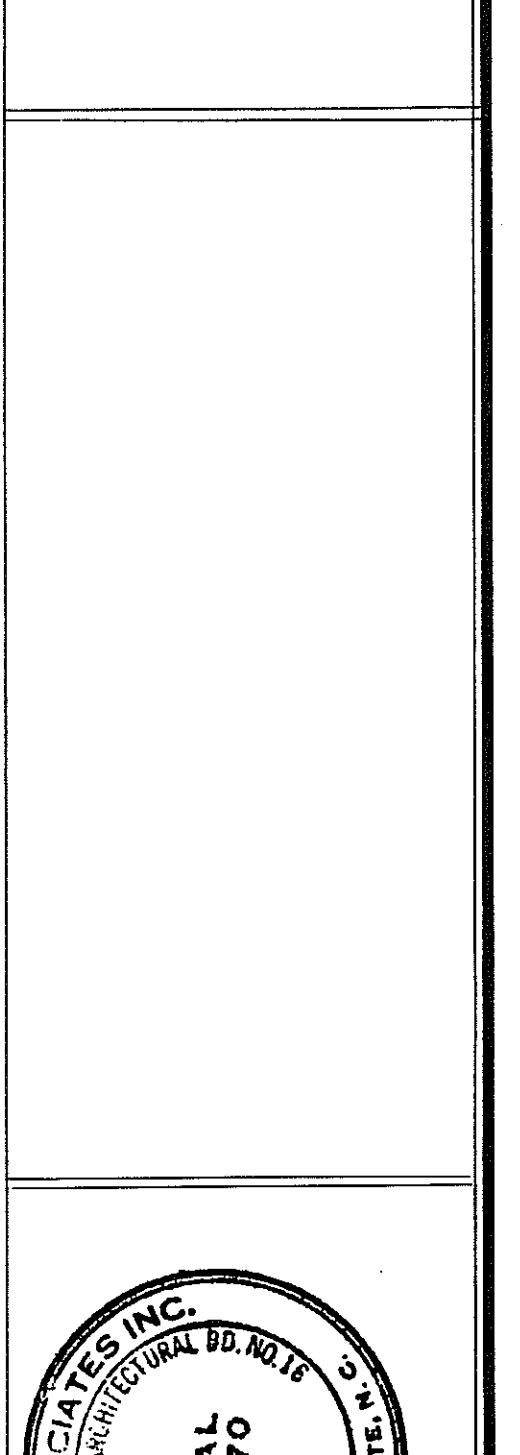

AS BUILT	1	Date
----------	---	------

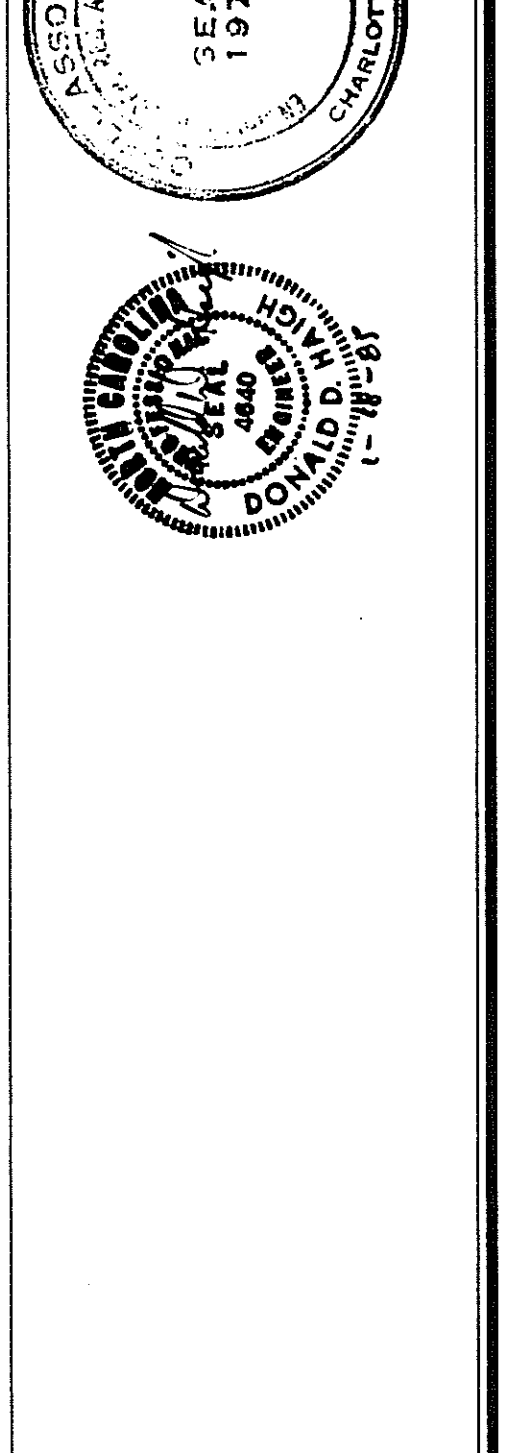

Project Title	CLINICAL ADDITION
Drawing Title	DETAILS
Approved: Division Chief	Checked
Approved: Service Director	Checked

Date	10/1/88
Project No.	565-027
Drawing No.	1-S9
Building Number	1
Location	V.A.M.C. - FAYETTEVILLE, N.C.

Revisions

7-2-1-2473