



MODIFICATIONS – PIPING SECTION & PLAN – NORTH METER PIT
SCALE: 1/2"=1'-0"

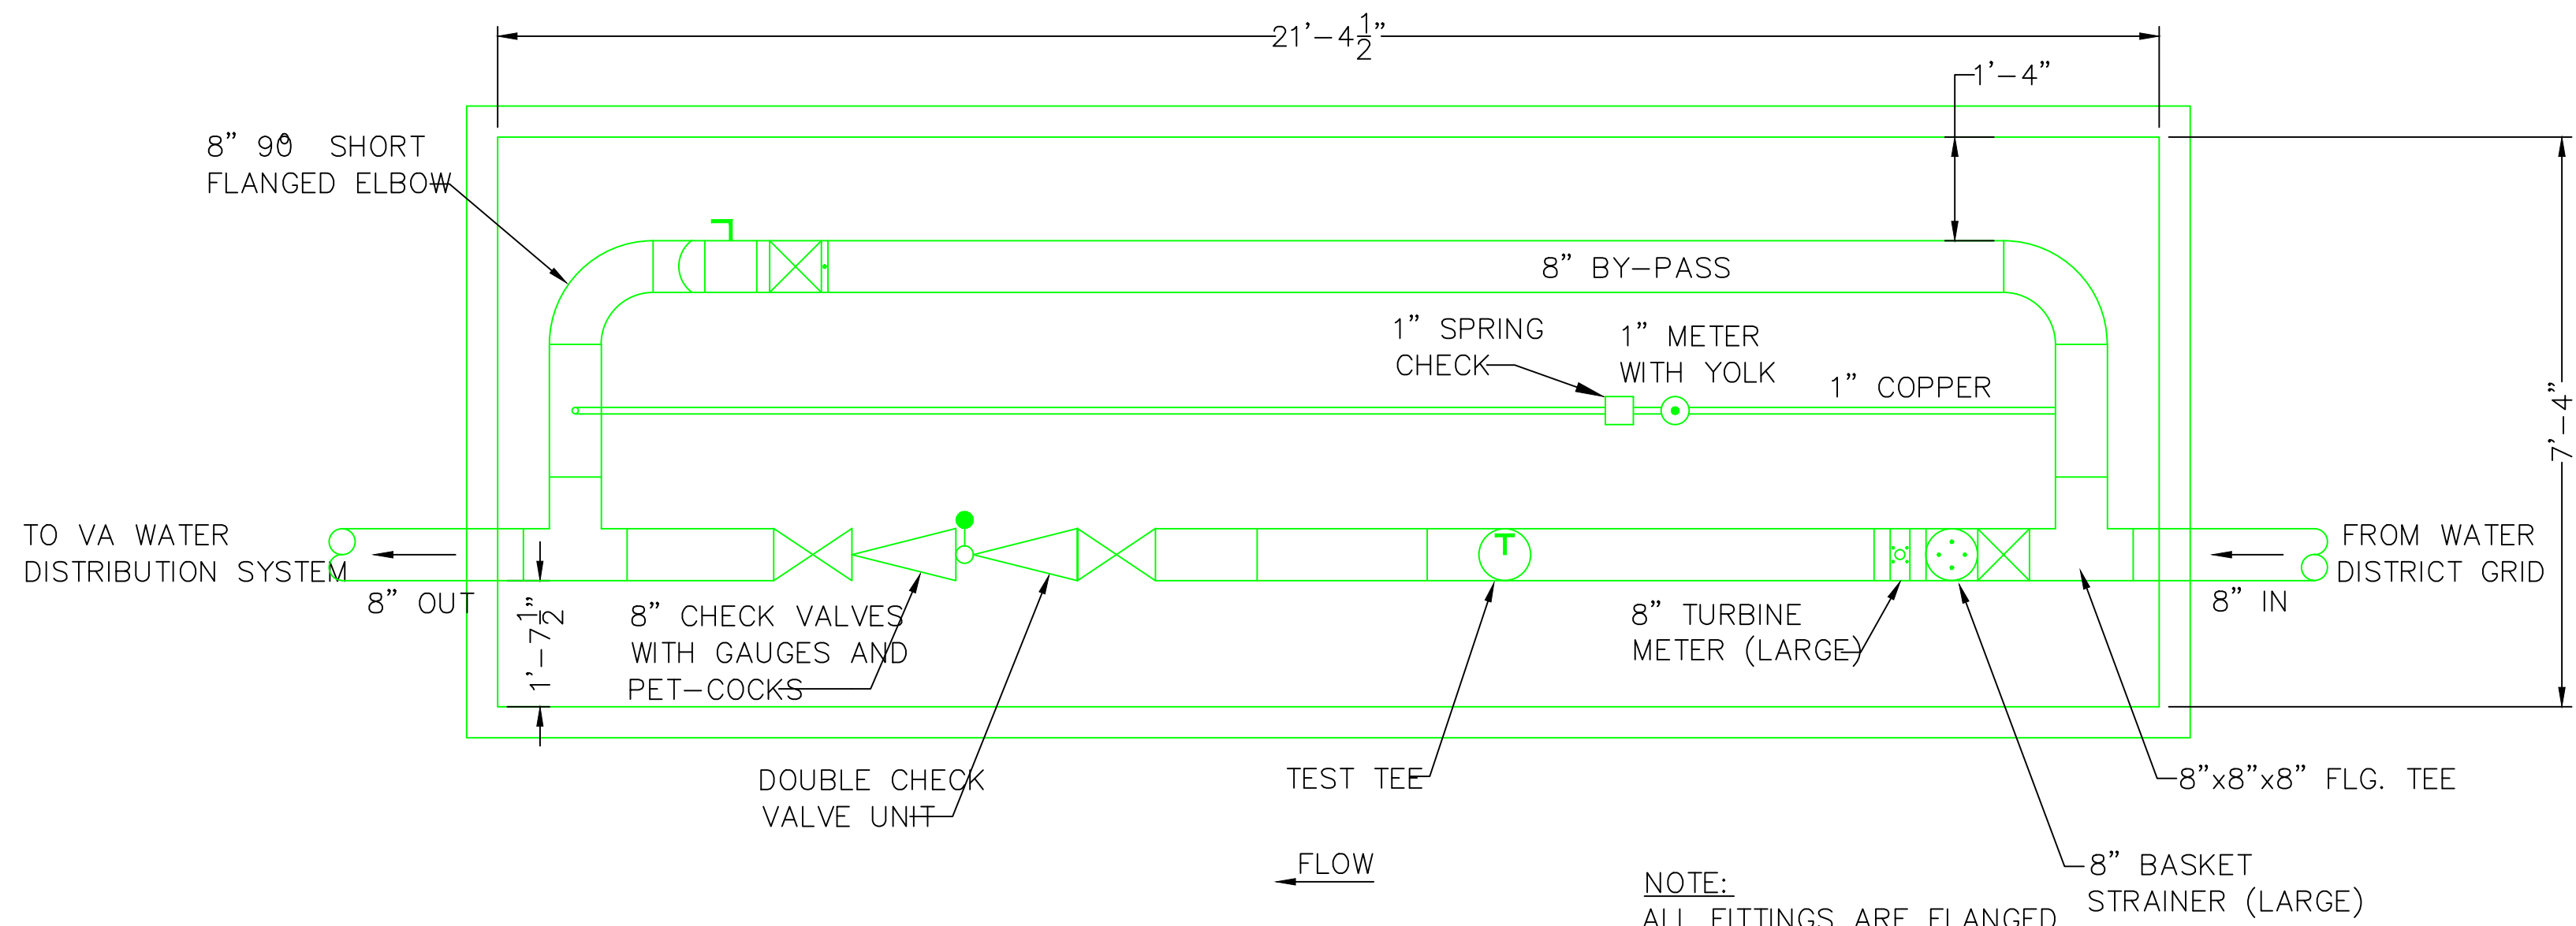

EXISTING NORTH METER PIT
PLAN VIEW
SCALE: 1/2" = 1'-0"

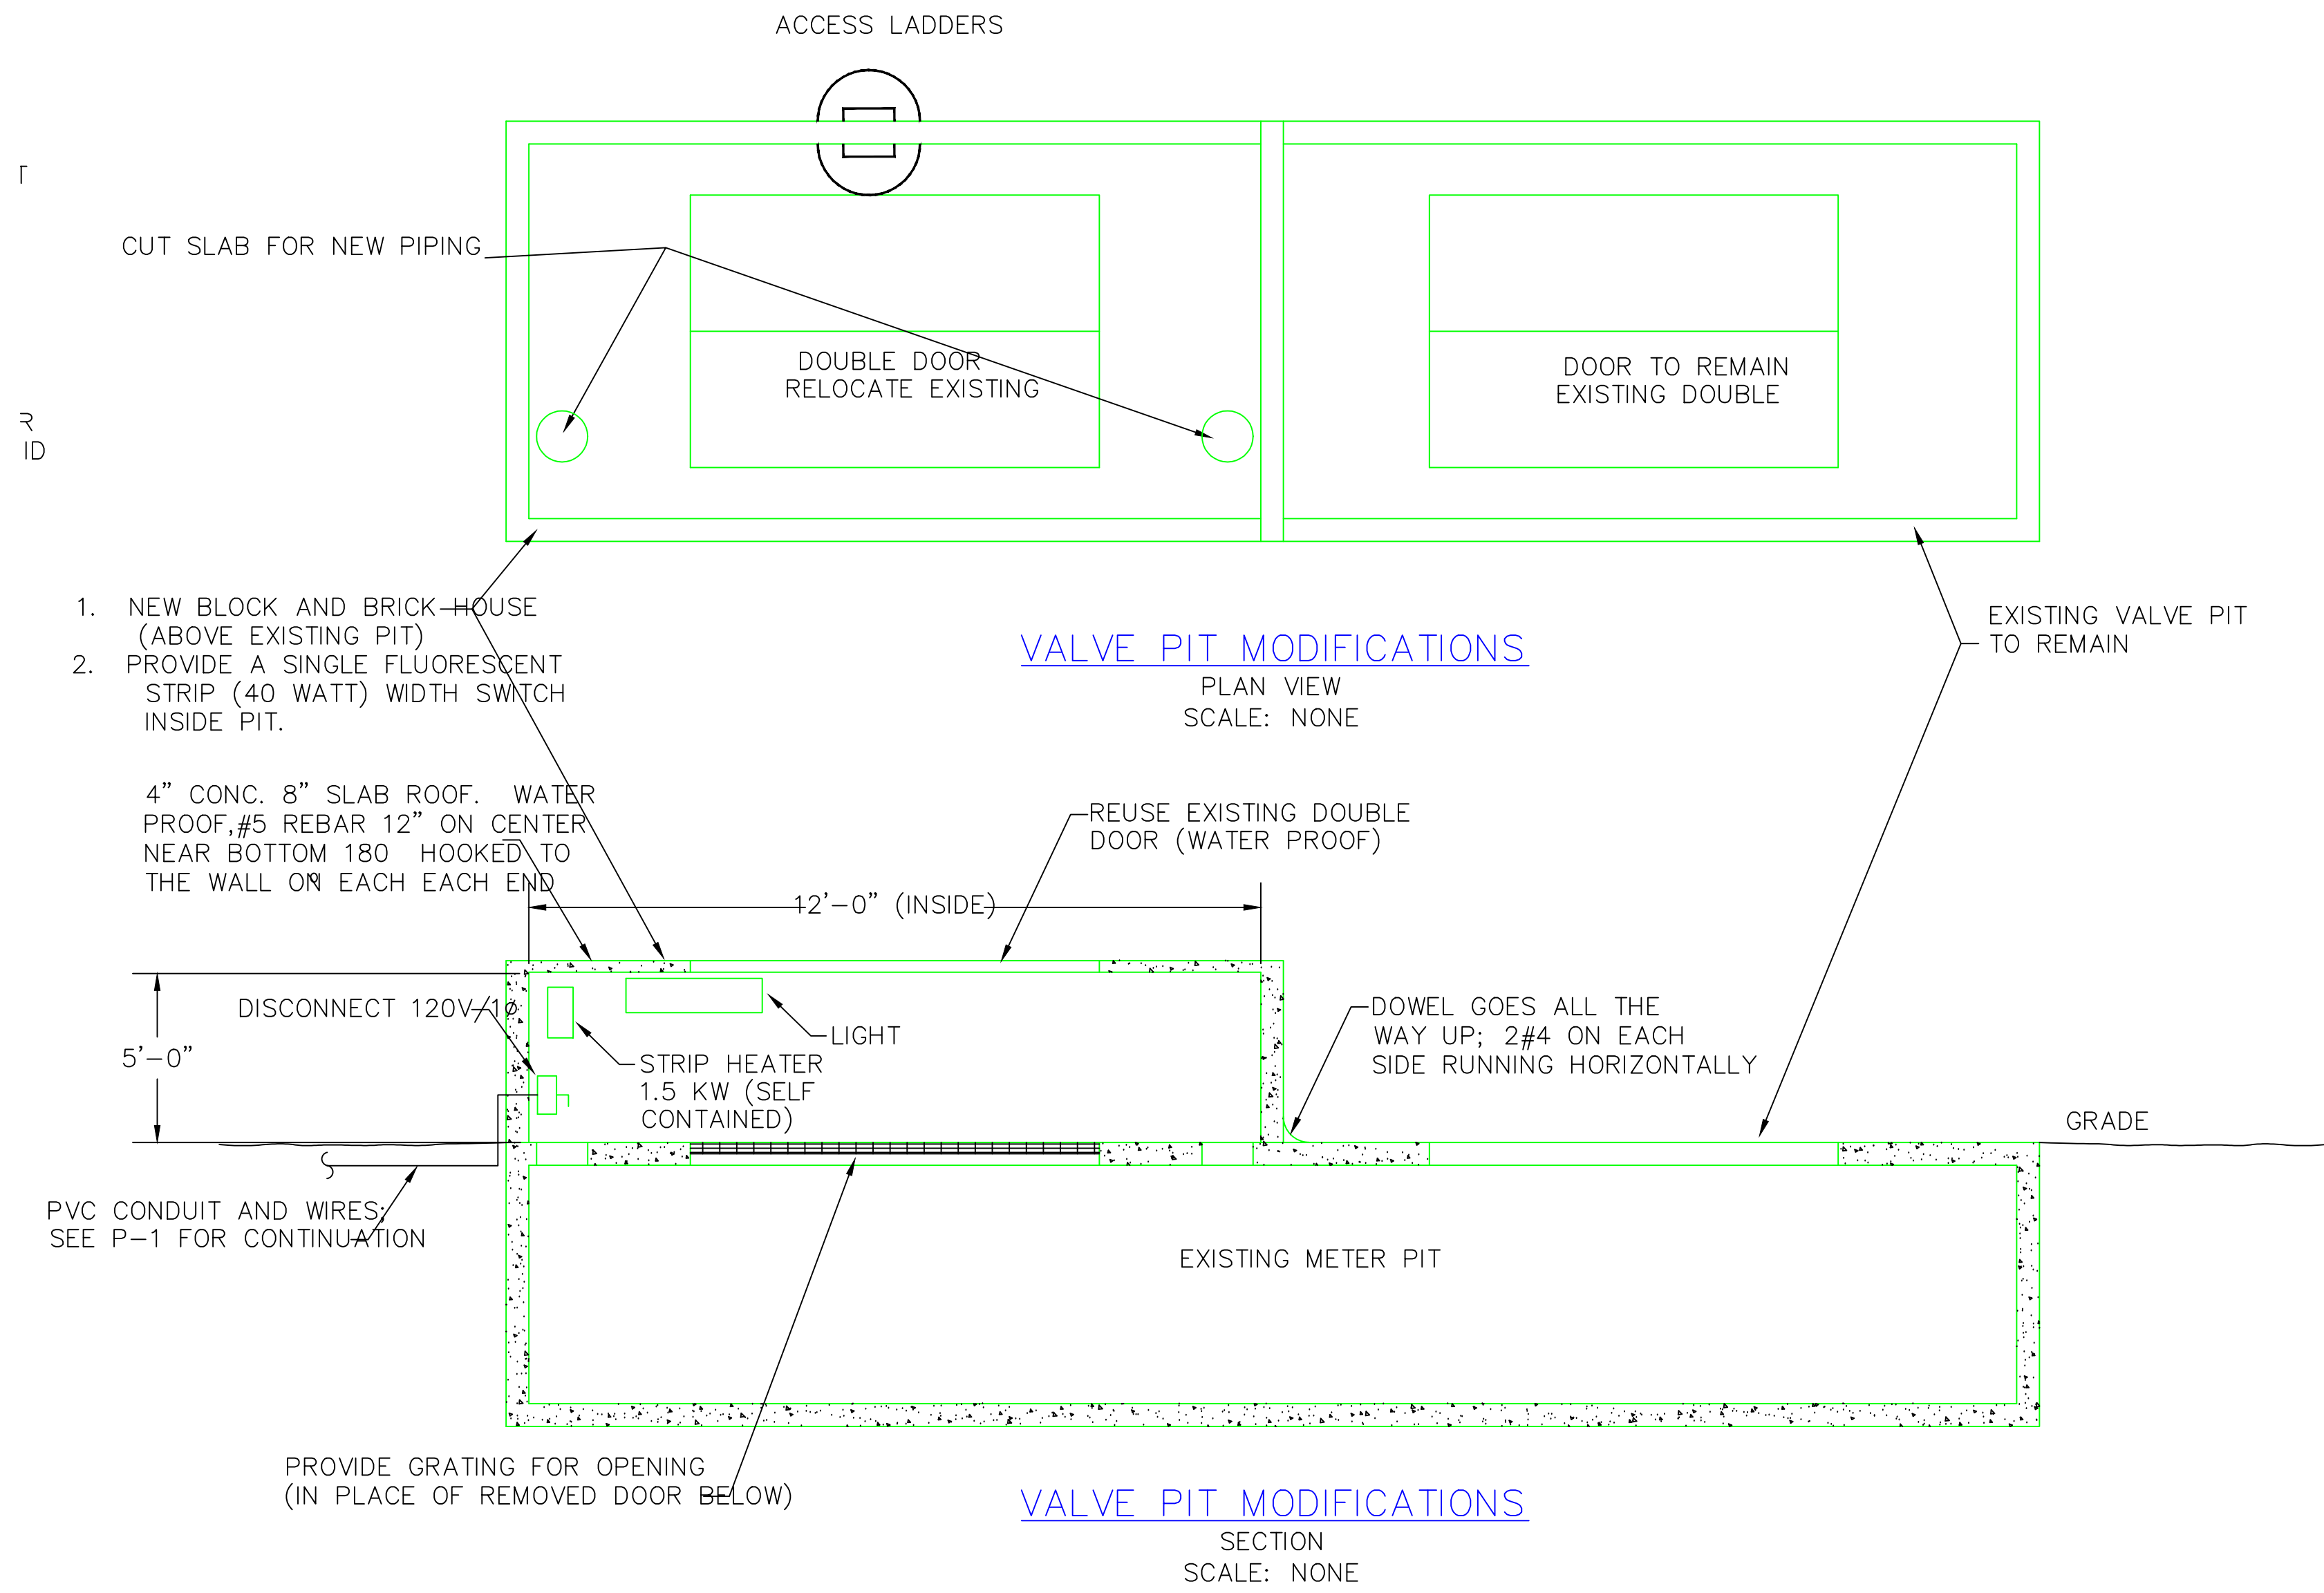


INSIDE OF VAULT TO LID, OPENING = 36"	54" OPENING DOORS	DISTANCE BETWEEN BOTH DOORS = 72 1/2"	54" OPENING DOORS	INSIDE OF VAULT TO LID, OPENING = 45"
---------------------------------------	-------------------	---------------------------------------	-------------------	---------------------------------------

NOTES:
1. NEW HOUSE TO BE WATER PROOFED.
2. PROVIDE BRICKS TO MATCH SITE BUILDINGS
3. MODIFICATIONS TYPICAL FOR NORTH AND SOUTH METER PITS.
4. PROVIDE ELECTRICAL FROM NEAREST SOURCE.
5. SEE P-1 FOR DETAILS.
6. CONTRACTOR TO OBTAIN WRITTEN APPROVAL FROM UTILITY CONSTRUCTION DEPARTMENT.
CITY OF SALISBURY. (MR. LARRY LYERLY - 704-638-5390)
7. CONTRACTOR WILL COORDINATE WITH

LEGEND:	
GV	GATE VALVE (NRS)
CV	CHECK VALVE
	RPZ CHECK VALVE UNIT
M	METER – TURBINE FULL FLOW
PRV	ROSS PRESSURE REDUCING VALVE
S	STRAINER

ISSUED FOR AS BUILTS	08-29-03
REVISED PER CITY OF SALISBURY UTILITY DEPT.	REVIEW-02
REVISED VALVE PIPING ARRANGEMENT	11-06-02
Revision	Date

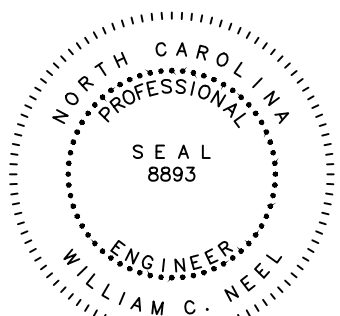

CAN Engineering, Inc.
4109 East North St., Suite 200
Greenville, South Carolina 29615
Ph: (864) 271-3873
Fax: (864) 268-7570
Email: CANENGINE@aol.com
CAN Project No. 2001601

RECOMMEND APPROVAL			
REQUESTOR	Date	CHIEF OF STAFF	Date
CHIEF OF SERVICE	Date	ASST. MED. CTR. DIR	Date
APPROVAL BY:	Date		
MEDICAL CENTER DIRECTOR			

Drawing Title	MODIFICATIONS TO NORTH METER PITS & VAMC WATER DISTRIBUTION SYSTEM
Approved: Safety Manager/M&O Supervisor	
Approved: Chief of Engineering Service	

Project Title	LIFE SAFETY DEFICIENCIES UPGRADE VETERANS' AFFAIRS MEDICAL CENTER SALISBURY, NORTH CAROLINA
Building Number	-
Location	Dept. of Veterans Affairs 1601 Brenner Ave. Salisbury NC 28144

Date	03-20-02
Project No.	659-01-107
DRAWING NO.	P-3
DWG. 14 OF 14	



Department of Veterans Affairs