


LEGEND:

- ① FIRE HYDRANT (W/ GATE VALVE IN ROADWAY BOX)
- LAWN HYDRANT
- ◇ POST INDICATOR VALVE
- ◇ CHECK VALVE
- ◇ GATE VALVE
- ◇ WALL SIAMESE CONN.


NOTES:

- EXISTING WATER DISTRIBUTION SHOWN.
- NORTH CONNECTION FROM THE SALISBURY--ROWAN UTILITIES DEPARTMENT GRID IS PRESENTLY NOT IN SERVICE. AFTER MODIFICATION BOTH CONNECTIONS WILL BE OPEN.
- TRENCH FOR 120V, 1Ø POWER TO BE 30" DEEP. LOCATE ANY EXISTING ELECTRICAL OR PIPING PRIOR TO BEGINNING EXCAVATION. FILL & GRA TO ORIGINAL CONDITION. BORE UNDER ANY ROAD OR SIDEWALKS.


WATER TANK VALVE PIT
SCALE: NONE

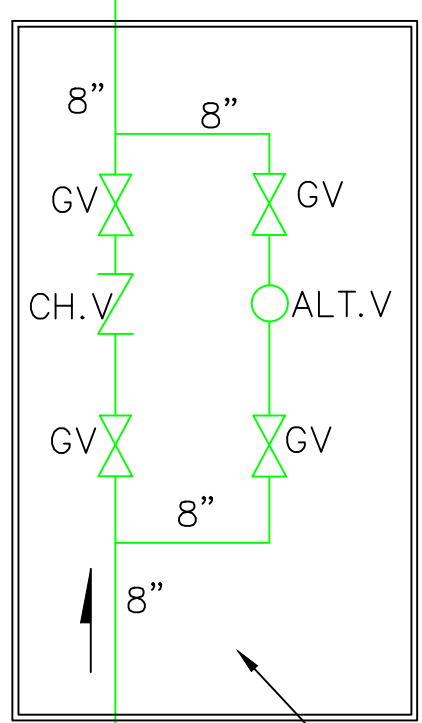

EXISTING VALVES IN WATER TANK PIT TO REMAIN IN SERVICE AFTER TANK IS REMOVED

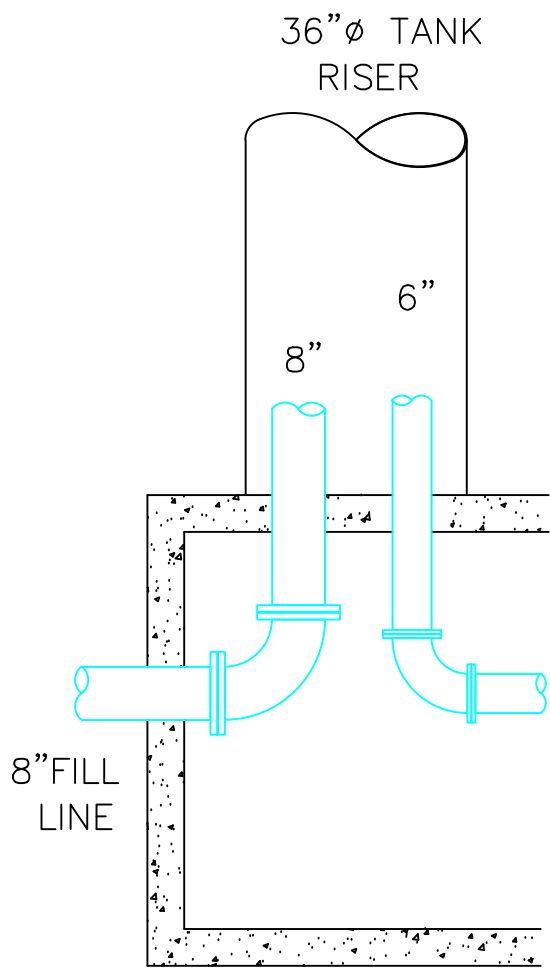

CENTER TANK RISER PIT
SCALE: NONE

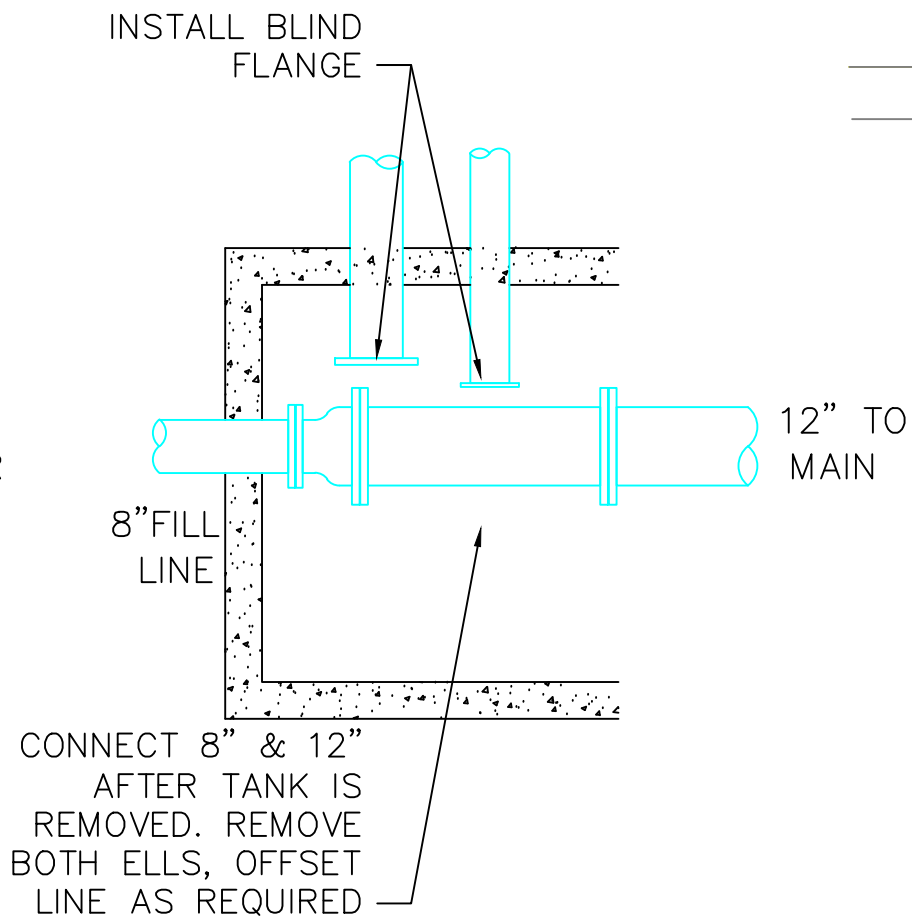

ROUTE IN CONDUIT TO ELECTRICAL ROOM IN BASEMENT, CONNECT TO PANEL GN1B 2, CKT. #40, 1Ø/20A NOTE 3

SOUTH METER PIT (SEE DETAIL DWG P-2)


ROUTE IN CONDUIT TO ELECTRICAL PANEL IN BASEMENT, CONNECT TO PANEL AA1, CKT. #14, 1Ø-20A NOTE 3

1" PVC WITH 2#12 COPPER WIRES

WATER DISTRIBUTION PLAN
SCALE: 1"=100'



ISSUED FOR AS BUILTS	08-29-03
Revision	Date

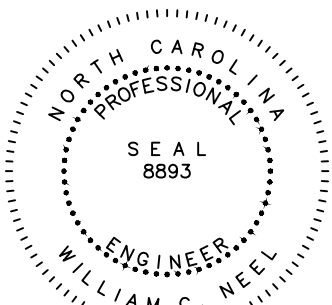

CAN Engineering, Inc.
4109 East North St., Suite 200
Greenville, South Carolina 29615
Ph: (864) 271-5875
Fax: (864) 268-7570
Email: CANENGINE@aol.com
CAN Project No. 2001601

RECOMMEND APPROVAL			
REQUESTOR	Date	CHIEF OF STAFF	Date
CHIEF OF SERVICE	Date	ASST. MED. CTR. DIR	Date
APPROVAL BY:			Date
MEDICAL CENTER DIRECTOR			

Drawing Title	EXISTING VAMC WATER DISTRIBUTION SYSTEM		
Approved: Safety Manager/M&O Supervisor			
Approved: Chief of Engineering Service			

Project Title	LIFE SAFETY DEFICIENCIES UPGRADE VETERANS' AFFAIRS MEDICAL CENTER SALISBURY, NORTH CAROLINA		
Building Number	-	Checked CH	Drawn LSH
Location	Dept. of Veterans Affairs 1601 Brenner Ave. Salisbury NC 28144		

Date	03-25-02
Project No.	659-01-107
DRAWING NO.	P-1
DWG. 12 OF 14	



Department of Veterans Affairs