


DRAWING NOTES:
A. NO WORK REQUIRED THIS AREA. SHEET INCLUDED FOR COMPLETENESS OF RECORD DRAWINGS.


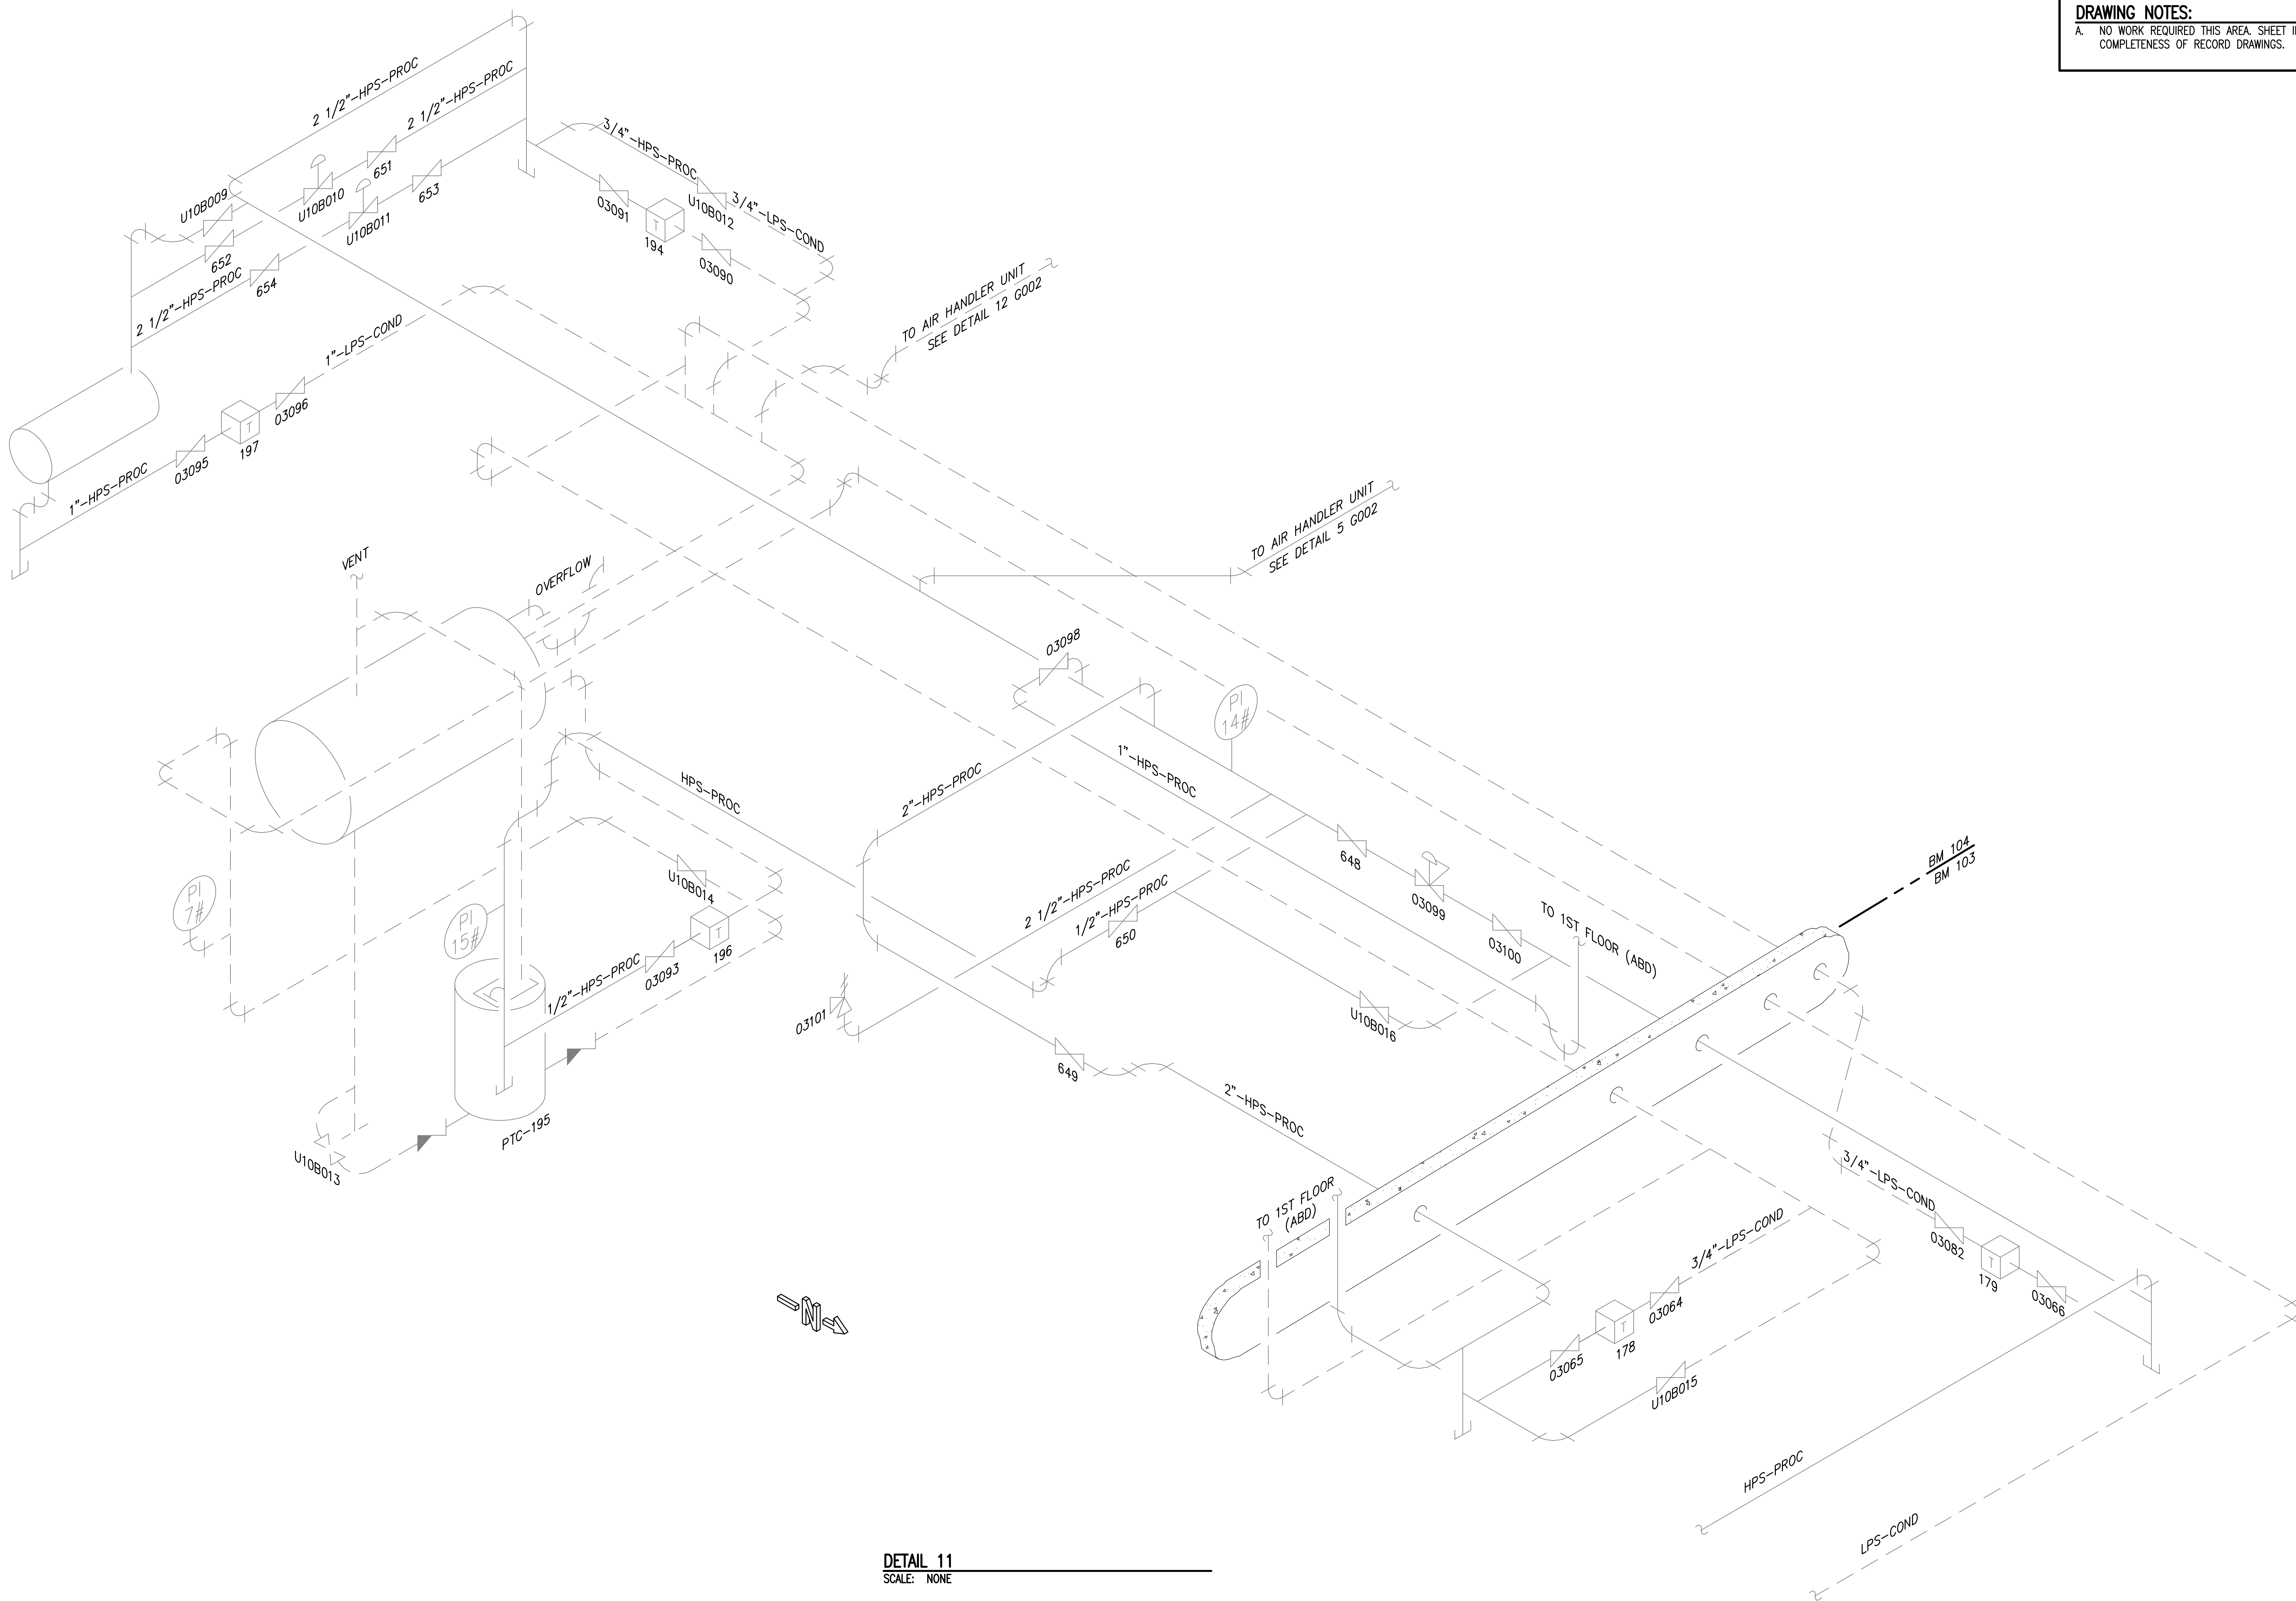


DETAIL 11
SCALE: NONE

Revisions	Date

AES
APPLIED ENGINEERING
SOLUTIONS
440 Martin Luther King, Jr. Blvd., Suite 401
Macon, Georgia 31201
(478) 314-1270
www.aes-pe.com

KEY PLAN
SCALE: NONE

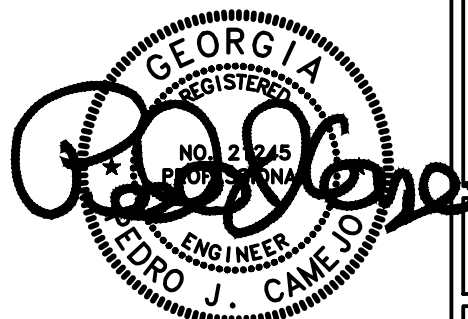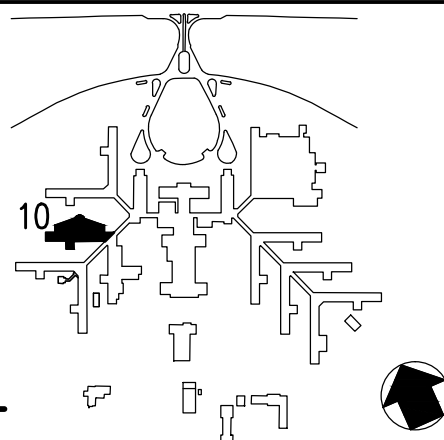

Drawing Title		Project Title		Date
DETAIL		STEAM AND CONDENSATE PIPING SYSTEM STUDY		JUNE 22, 2012
Building Number		Checked	Drawn	Project No.
10		PJC	JSW	557-10-109
Location		Drawing No.		Dwg. 52 Of 87
CARL VINSON VA MEDICAL CENTER DUBLIN, GEORGIA		10-G-003		

Veterans
Administration