




A

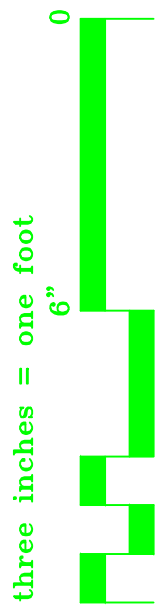


B

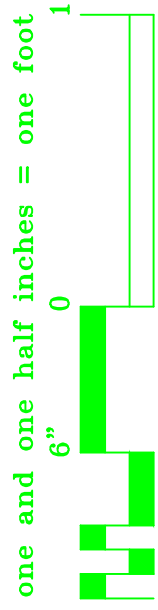


C

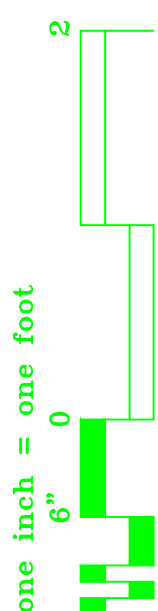




D

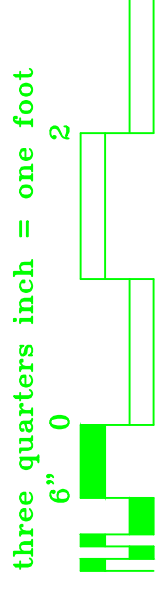

E

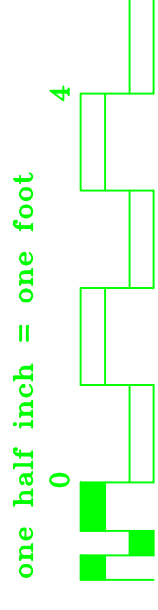

F

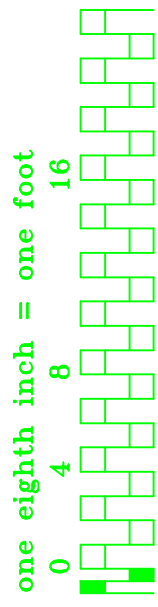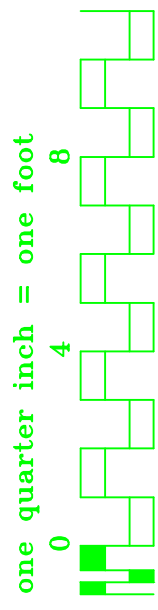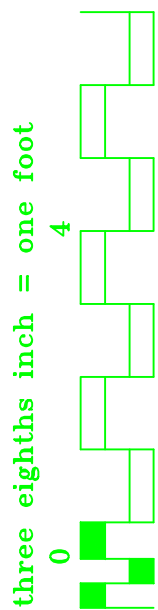

A

B

C

D

E

F

Revisions

Date

Professional Seal

Drawing Title

FIRST FLOOR PLAN  
ARCHITECTURAL / ZONE C  
BRECC

Approved:

Approved:

Project Title

AS-BUILT Drawings

Building Number

01

Checked

LM

Drawn

LM

Location

VAMC, LOCH RAVEN,  
MARYLAND

Date

10-12-2005

Project No.


Drawing No.

VAMC, LOCH RAVEN

VA

Department of  
Veterans Affairs

BRECC BLDG.#1  
1ST FLOOR ZONE C

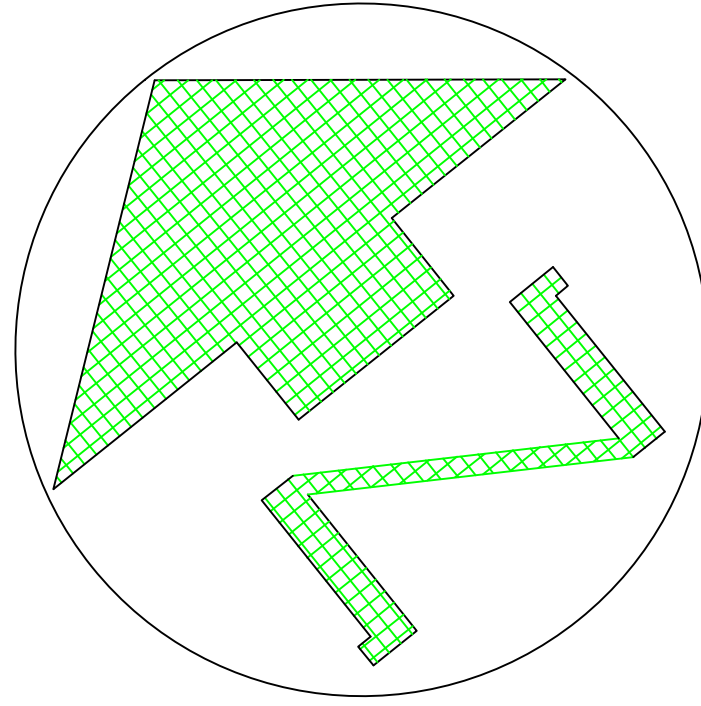

A

B

C

D

E

F