

A

B

C

D

E

F

three inches = one foot

one and one half inches = one foot

one inch = one foot

three quarters inch = one foot

one half inch = one foot

three eighths inch = one foot

one quarter inch = one foot

one eighth inch = one foot

A

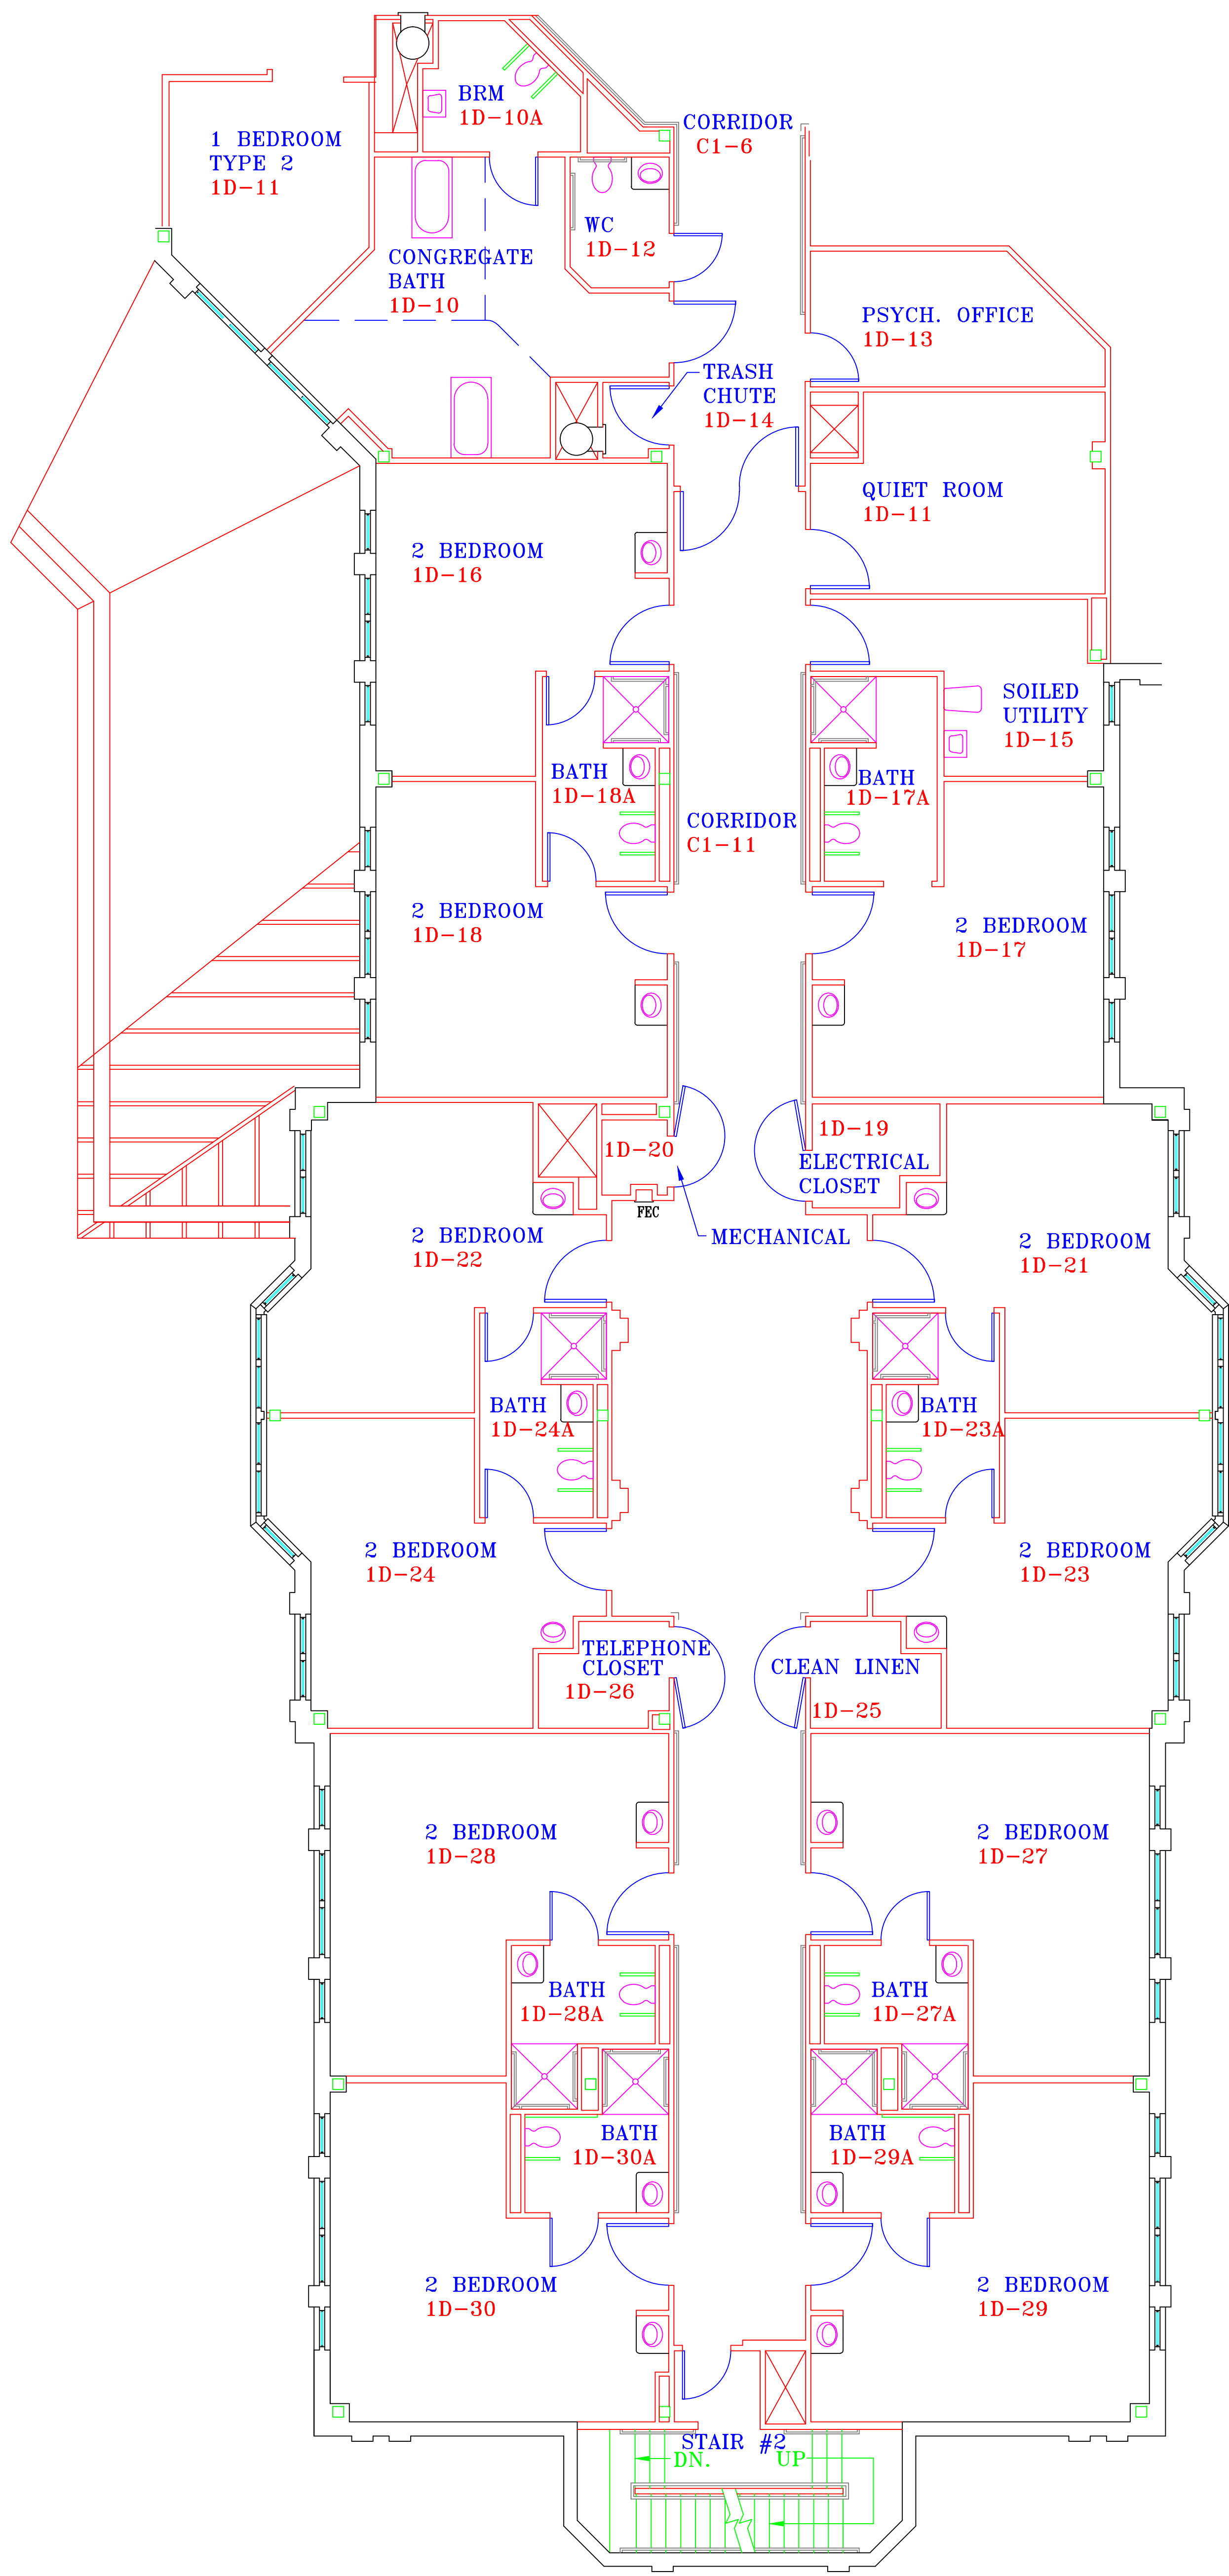
B

C

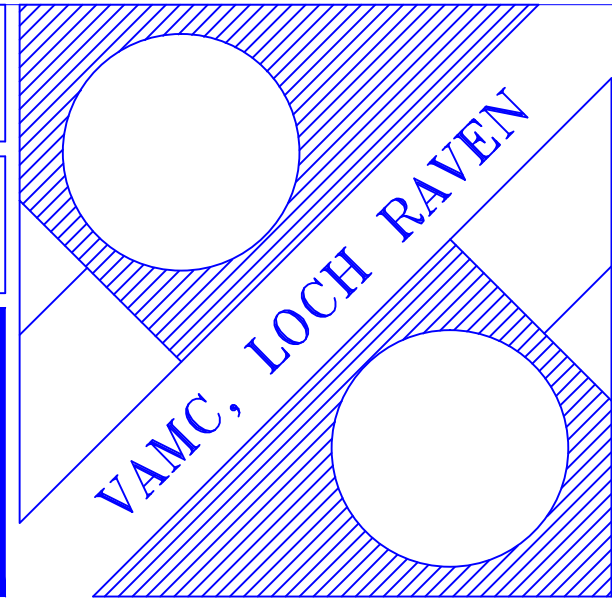
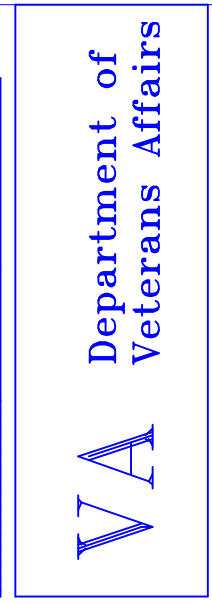
D

E

F



BRECC BLDG.#1
1ST FLOOR ZONE D

							Drawing Title		Project Title			Date		
							FIRST FLOOR PLAN ARCHITECTURAL / ZONE D BRECC		AS-BUILT Drawings			10-12-2005		
							Approved:		Building Number	Checked	Drawn	Project No.		
									01		LM			
Revisions		Date			Professional Seal		Approved:		Location VAMC, LOCH RAVEN, MARYLAND			Drawing No.		