


BRECC BLDG.#1
2ND FLOOR ZONE B

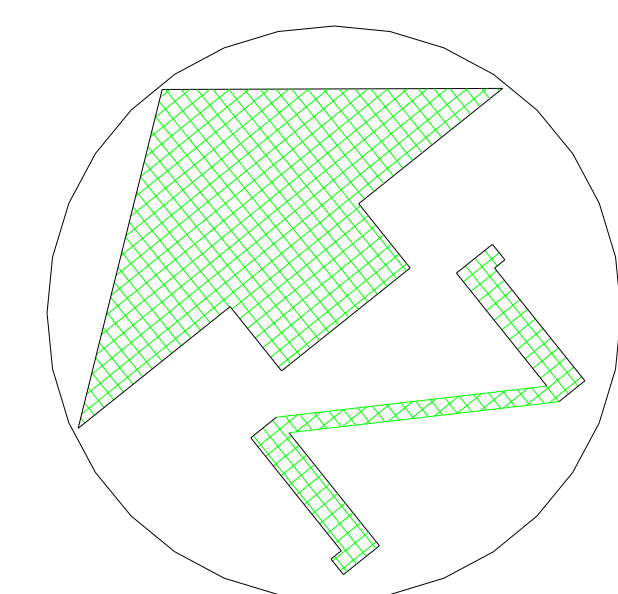

BRECC BLDG.#1
2ND FLOOR ZONE B

					Drawing Title SECOND FLOOR PLAN ARCHITECTURAL / ZONE B BRECC	Project Title AS-BUILT Drawings			Date 10-12-2005		
					Approved:	Building Number 01	Checked	Drawn LM	Project No.		
					Approved:	Location VAMC, LOCH RAVEN, MARYLAND			Drawing No.		
Revisions	Date			Professional Seal							