
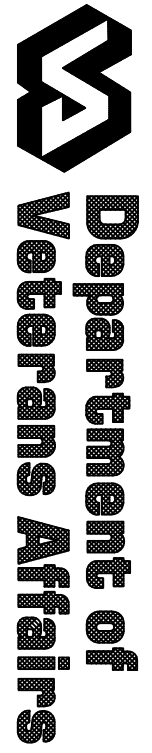


KEY PLAN

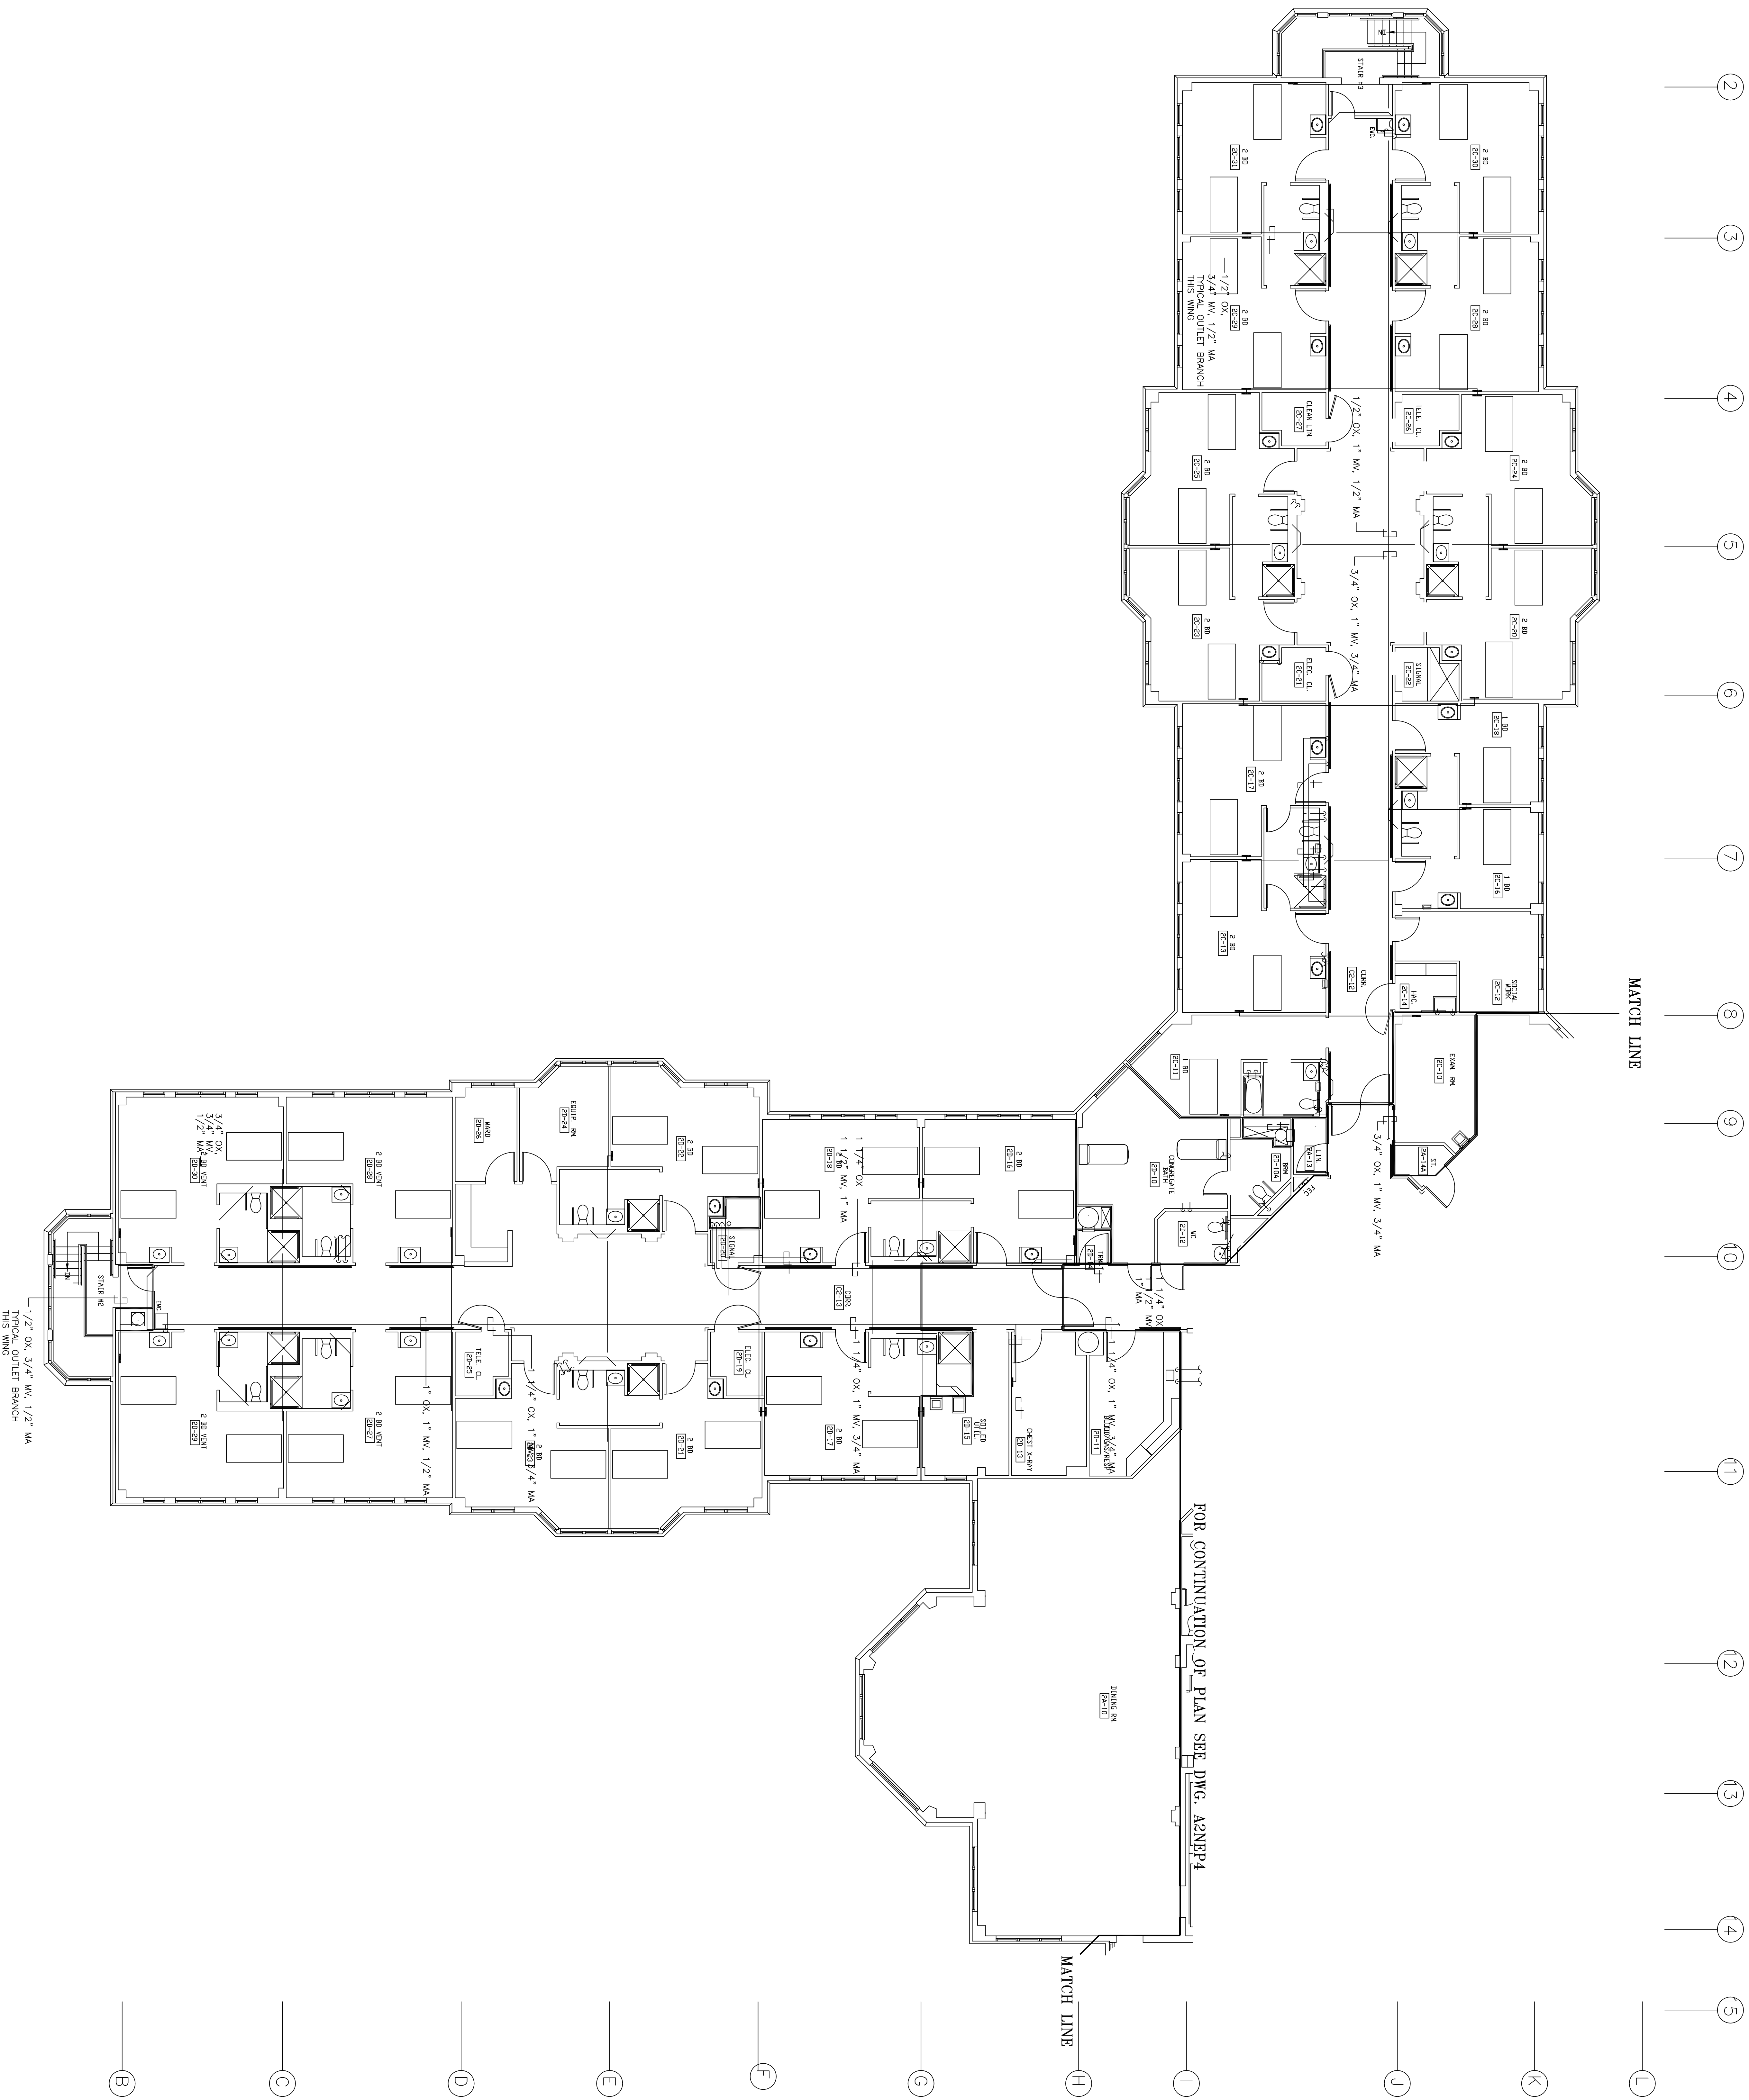

BALTIMORE
REHABILITATION
EXTENDED CARE
CENTER

Drawn	Scale
ZRP1	1/8"=1'
Checked	Date
ZRP1	10-07-97
Title	
SECOND-FLOOR-SOUTHWEST PLUMBING (7AS-BUILT*)	
Rev	Revision
1	AZSWP5