



KEY PLAN

Rev	Description	Date	By
-----	-------------	------	----

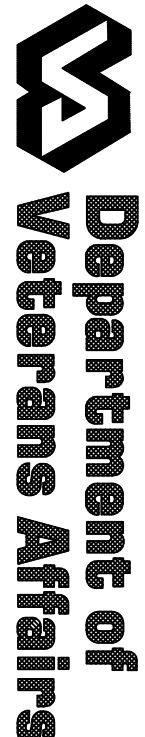

BALTIMORE
REHABILITATION
EXTENDED CARE
CENTER

Drawn	Scale
ZRP1	1/8" = 1'
Checked	Date
ZRP1	8-29-97
Title	
SECOND-FLOOR-NORTHEAST PLUMBING (7AS-BUILT)	
Drawn by	Revision
ZNEP4	—

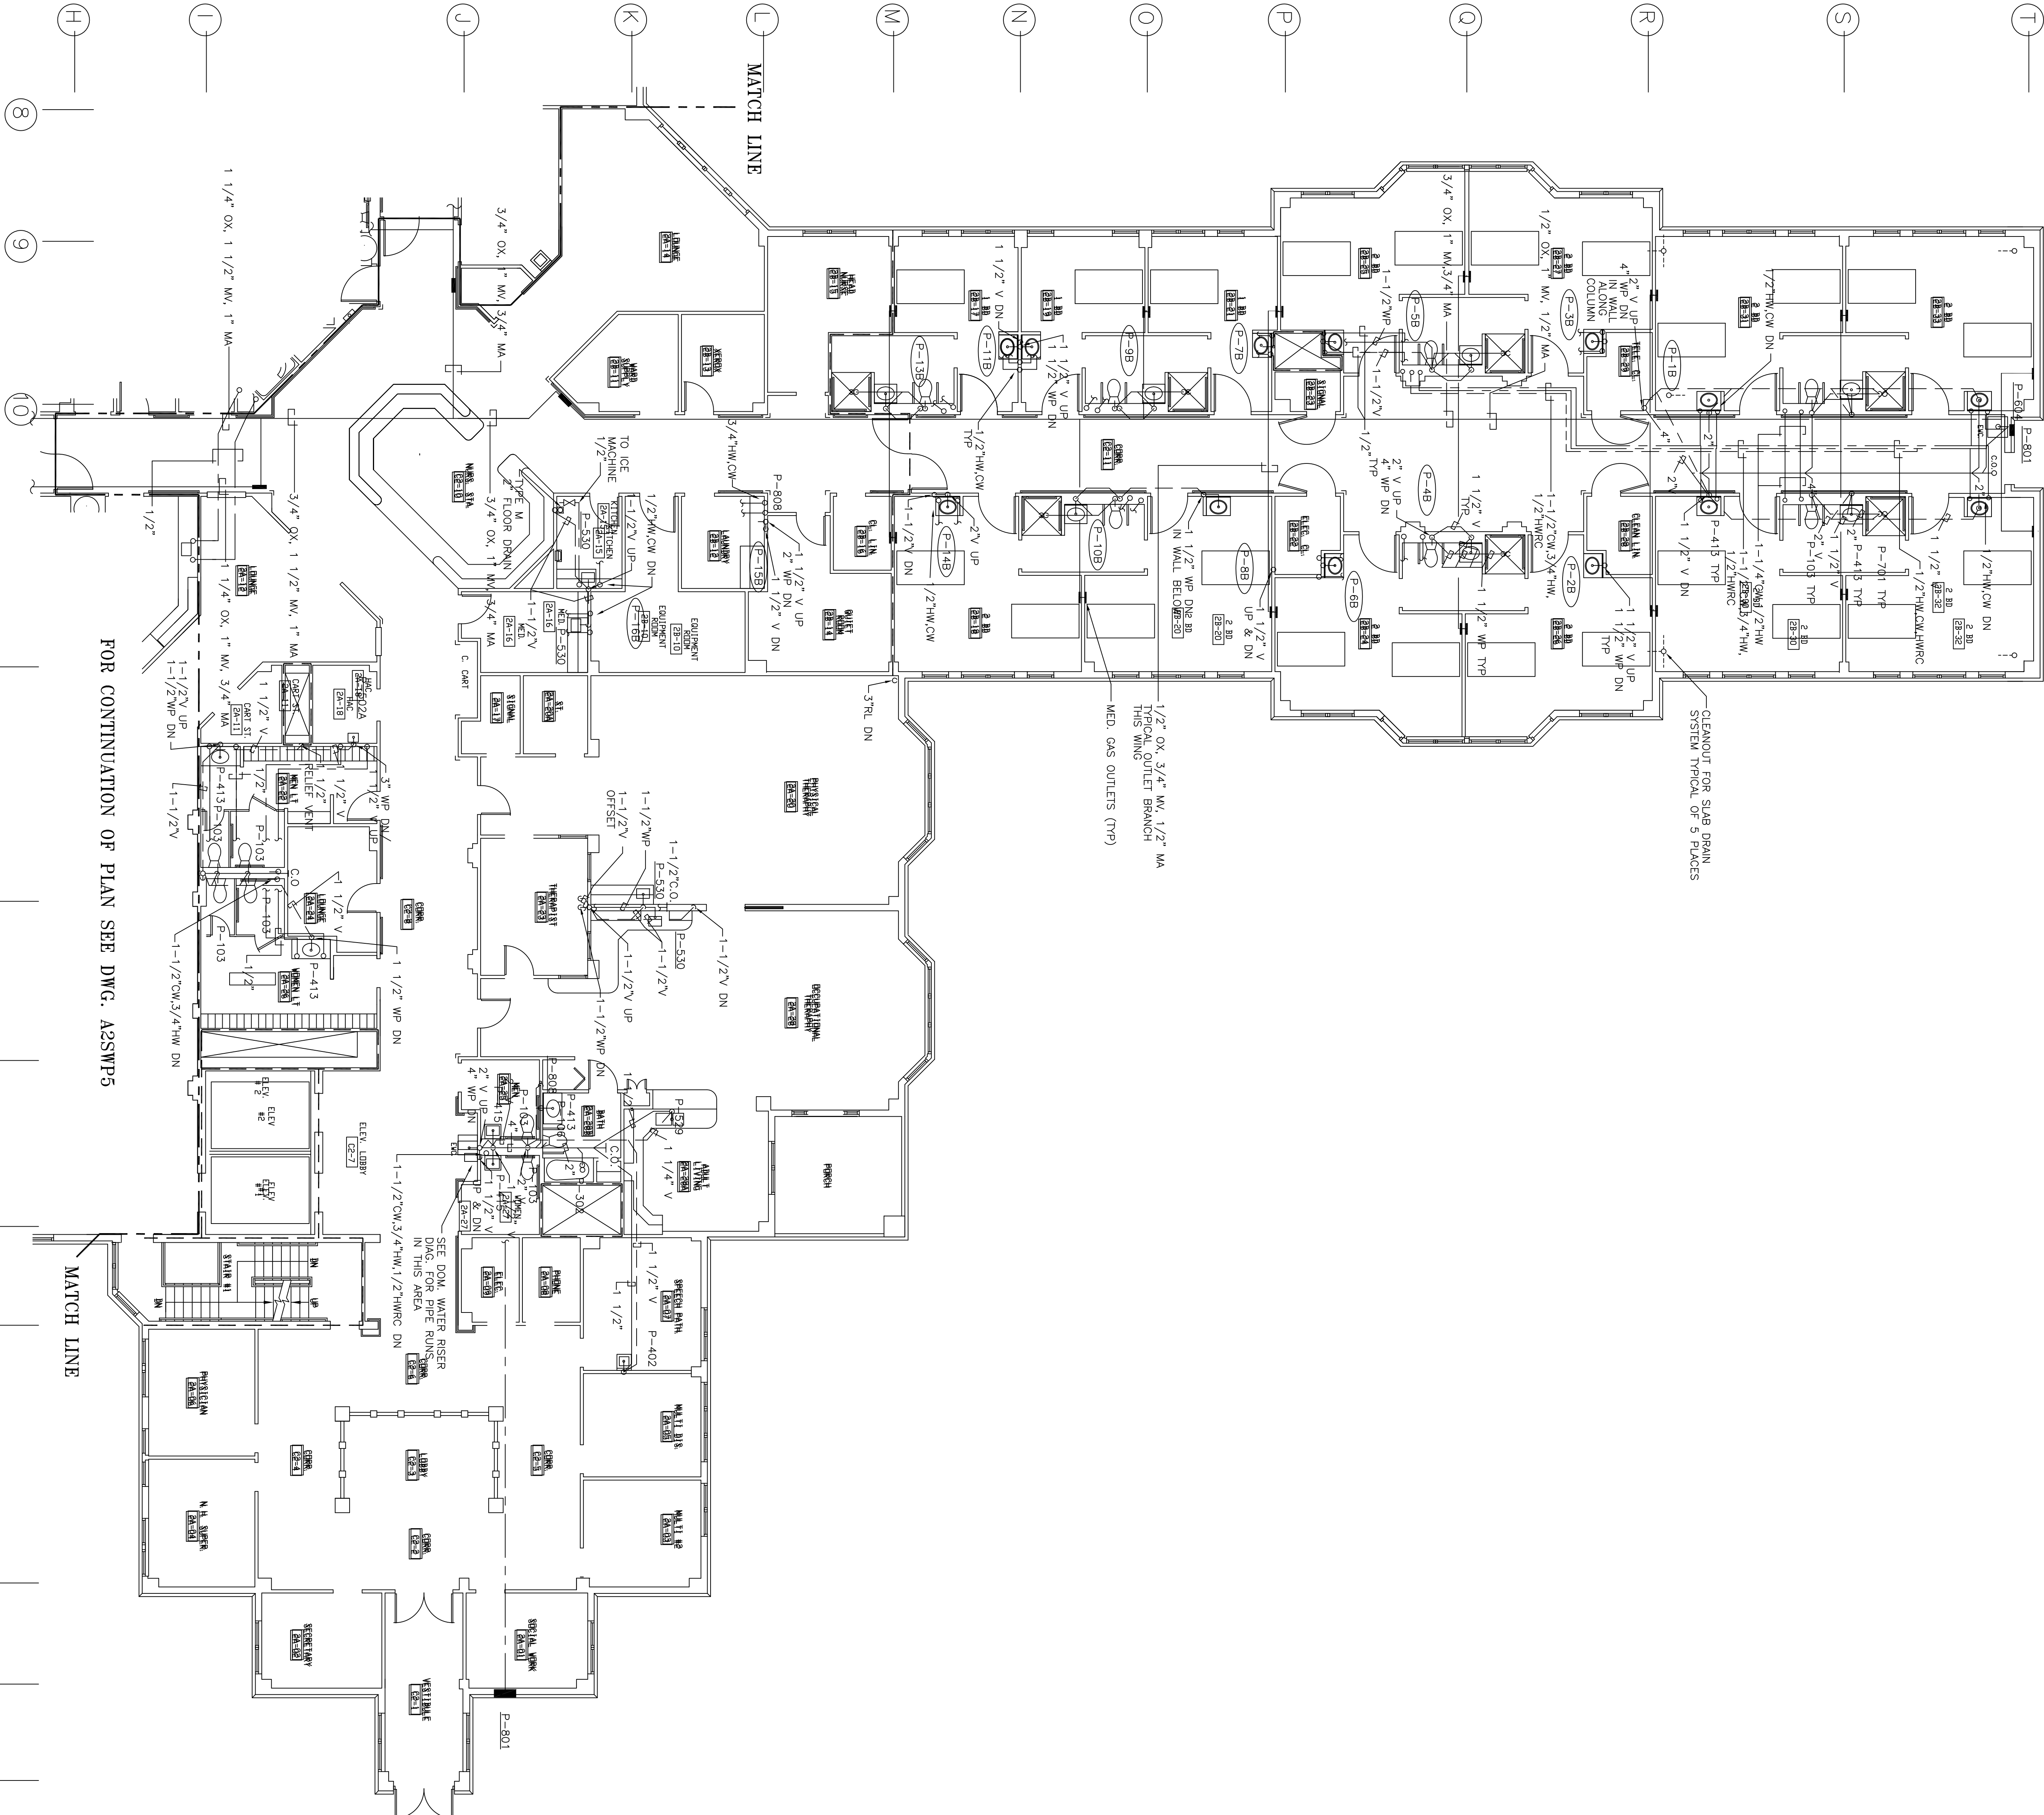

FOR CONTINUATION OF PLAN SEE DWG. A2SWP5