


COLOR CODE = ORANGE

NOTE: CEILING HEIGHT IS 9'-0" A.F.F.  
UNLESS NOTED OTHERWISE ON PLAN.

AS BUILT

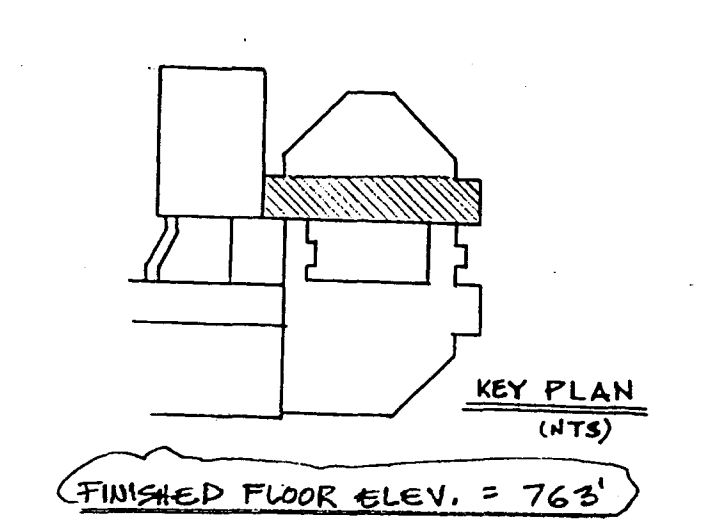

**IMPORTANT**

In facilities subject to freezing conditions, it is the owner's responsibility to provide heat throughout wet pipe sprinkler systems areas and in enclosures for dry pipe deluge and other types of valves controlling water supplies to sprinkler systems. This drawing and the information and design application herein contained is the property of Grinnell Fire Protection Systems Company, Inc. and/or its subsidiaries and is loaned upon express conditions that the same be returned to GPS upon request; all information herein contained shall be treated as secret, and confidential; no reproduction of this drawing or any part thereof shall be made without written consent of GPS.

Created by the Grinnell Design System - "All rights reserved".  
Copyright by Grinnell Corporation 1990.

CONTRACT RESPONSIBILITIES	
ITEM	G.F.P.S./OTHERS
STREET WATER CONNECTION	
UNDERGROUND WATER MAINS	
EXCAVATIONS	
BACKFILL	
WIRING	
PAINTING	

SYMBOLS	
<ul style="list-style-type: none"> <li>Hydraulic Reference Point</li> <li>Line Designation of Pipe Below Bottom of Deck</li> <li>Excavation</li> <li>Backfill</li> <li>Wiring</li> <li>Painting</li> </ul>	<ul style="list-style-type: none"> <li>Fire Dept. Conn. (Standard) (FDC)</li> <li>Fire Dept. Conn. (Push) (FDC)</li> <li>Fire Dept. Conn. (Side) (FDC)</li> <li>Fire Dept. Conn. (Top) (FDC)</li> <li>Fire Dept. Conn. (Bottom) (FDC)</li> <li>Fire Dept. Conn. (Side) (FDC)</li> <li>Fire Dept. Conn. (Top) (FDC)</li> <li>Fire Dept. Conn. (Bottom) (FDC)</li> </ul>

GEM SPRINKLERS							
	TYPE	ORIFICE	TEMP.	FINISH	CANOPY	SYMBOL	QTY.
	F738P	REG. 1/2	155	CHROME	F700 CHRM.	●	36
	F738P	REG. 3/4	155	CHROME	CHRM.	●	20
	P200NT	REG. 1/2	200	BRASS		○	1
	'A'BR. WFR	1/2	200	BRASS		○	20
		</					