
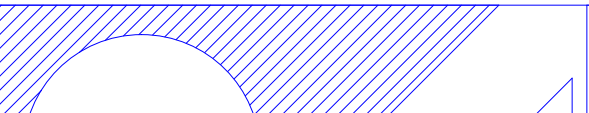



Revisions	Date	Professional Seal	<div><div></div><div>Indus Systems, Inc. 2352, Main Street, Concord MA 01742 Tel: 978-461-0555 www.indus-systems.com</div></div>	Drawing Title	Project Title		Date	<div></div> <div>VAMC, ERIE</div> <div></div>
				SECOND FLOOR PLAN ARCHITECTURAL	AS-BUILT Drawings		10-15-2010	
				Approved:	Building Number 04	Checked	Drawn	
				Approved:	Location		VAMC, ERIE PENNSYLVANIA	Drawing No.