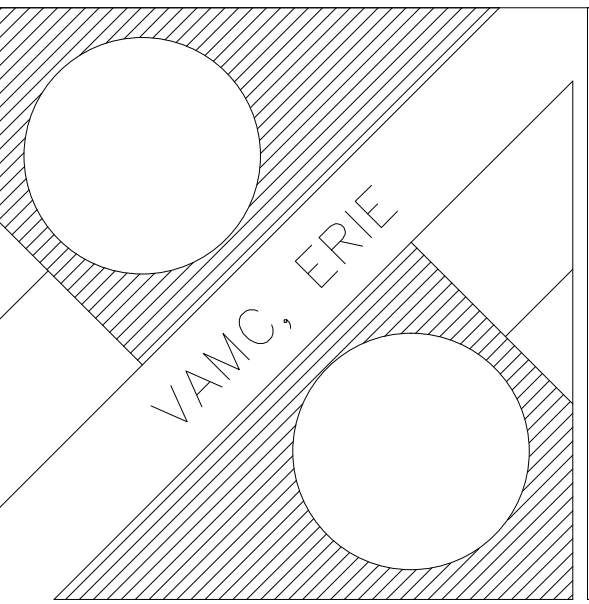

 <div>Indus Systems, Inc. 2352, Main Street, Concord MA 01742 Tel: 978-461-0555 www.indus-systems.com</div>	Drawing Title BASEMENT FLOOR PLAN ARCHITECTURAL		Project Title AS-BUILT Drawings		Date 10-15-2010		 <div>VAMC, ERIE</div>	 <div>VA Department of Veterans Affairs</div>	
				Approved:		Building Number 02		Checked	Drawn			Project No.
				Approved:		Location VAMC, ERIE PENNSYLVANIA		Drawing No.				
Revisions		Date		Professional Seal								