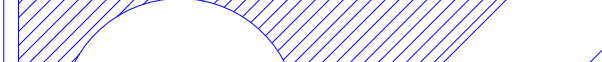
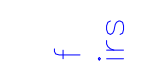
 Indus Systems, Inc. 2352, Main Street, Concord MA 01742 Tel: 978-461-0555 www.indus-systems.com	Drawing Title SECOND FLOOR PLAN ARCHITECTURAL		Project Title AS-BUILT Drawings		Date 10-15-2010			
				Approved:		Building Number 03	Checked	Drawn	Project No.		
				Approved:		Location VAMC, ERIE PENNSYLVANIA		Drawing No.			
Revisions	Date		Professional Seal								