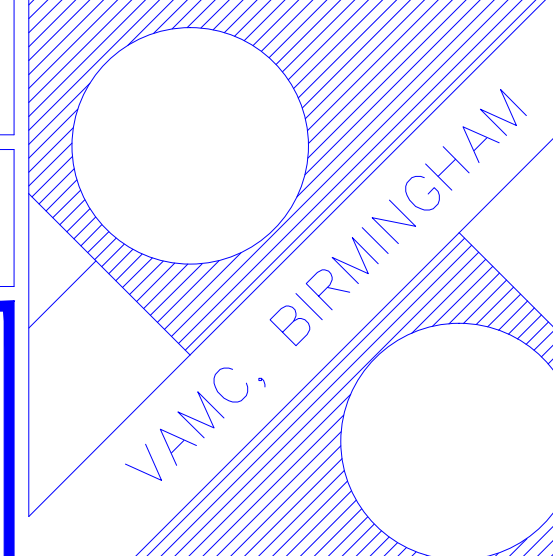


Revisions		Date	Professional Seal		Drawing Title FIRST FLOOR PLAN ARCHITECTURAL		Project Title AS-BUILT Drawings		Date 11-30-2010		 VAMC, BIRMINGHAM	VA Department of Veterans Affairs
					Approved:		Building Number 01		Project No.			
					Approved:		Location VAMC BIRMINGHAM		Drawing No.			