

A

B

C

D

E

F

A


B

C


D

E

F

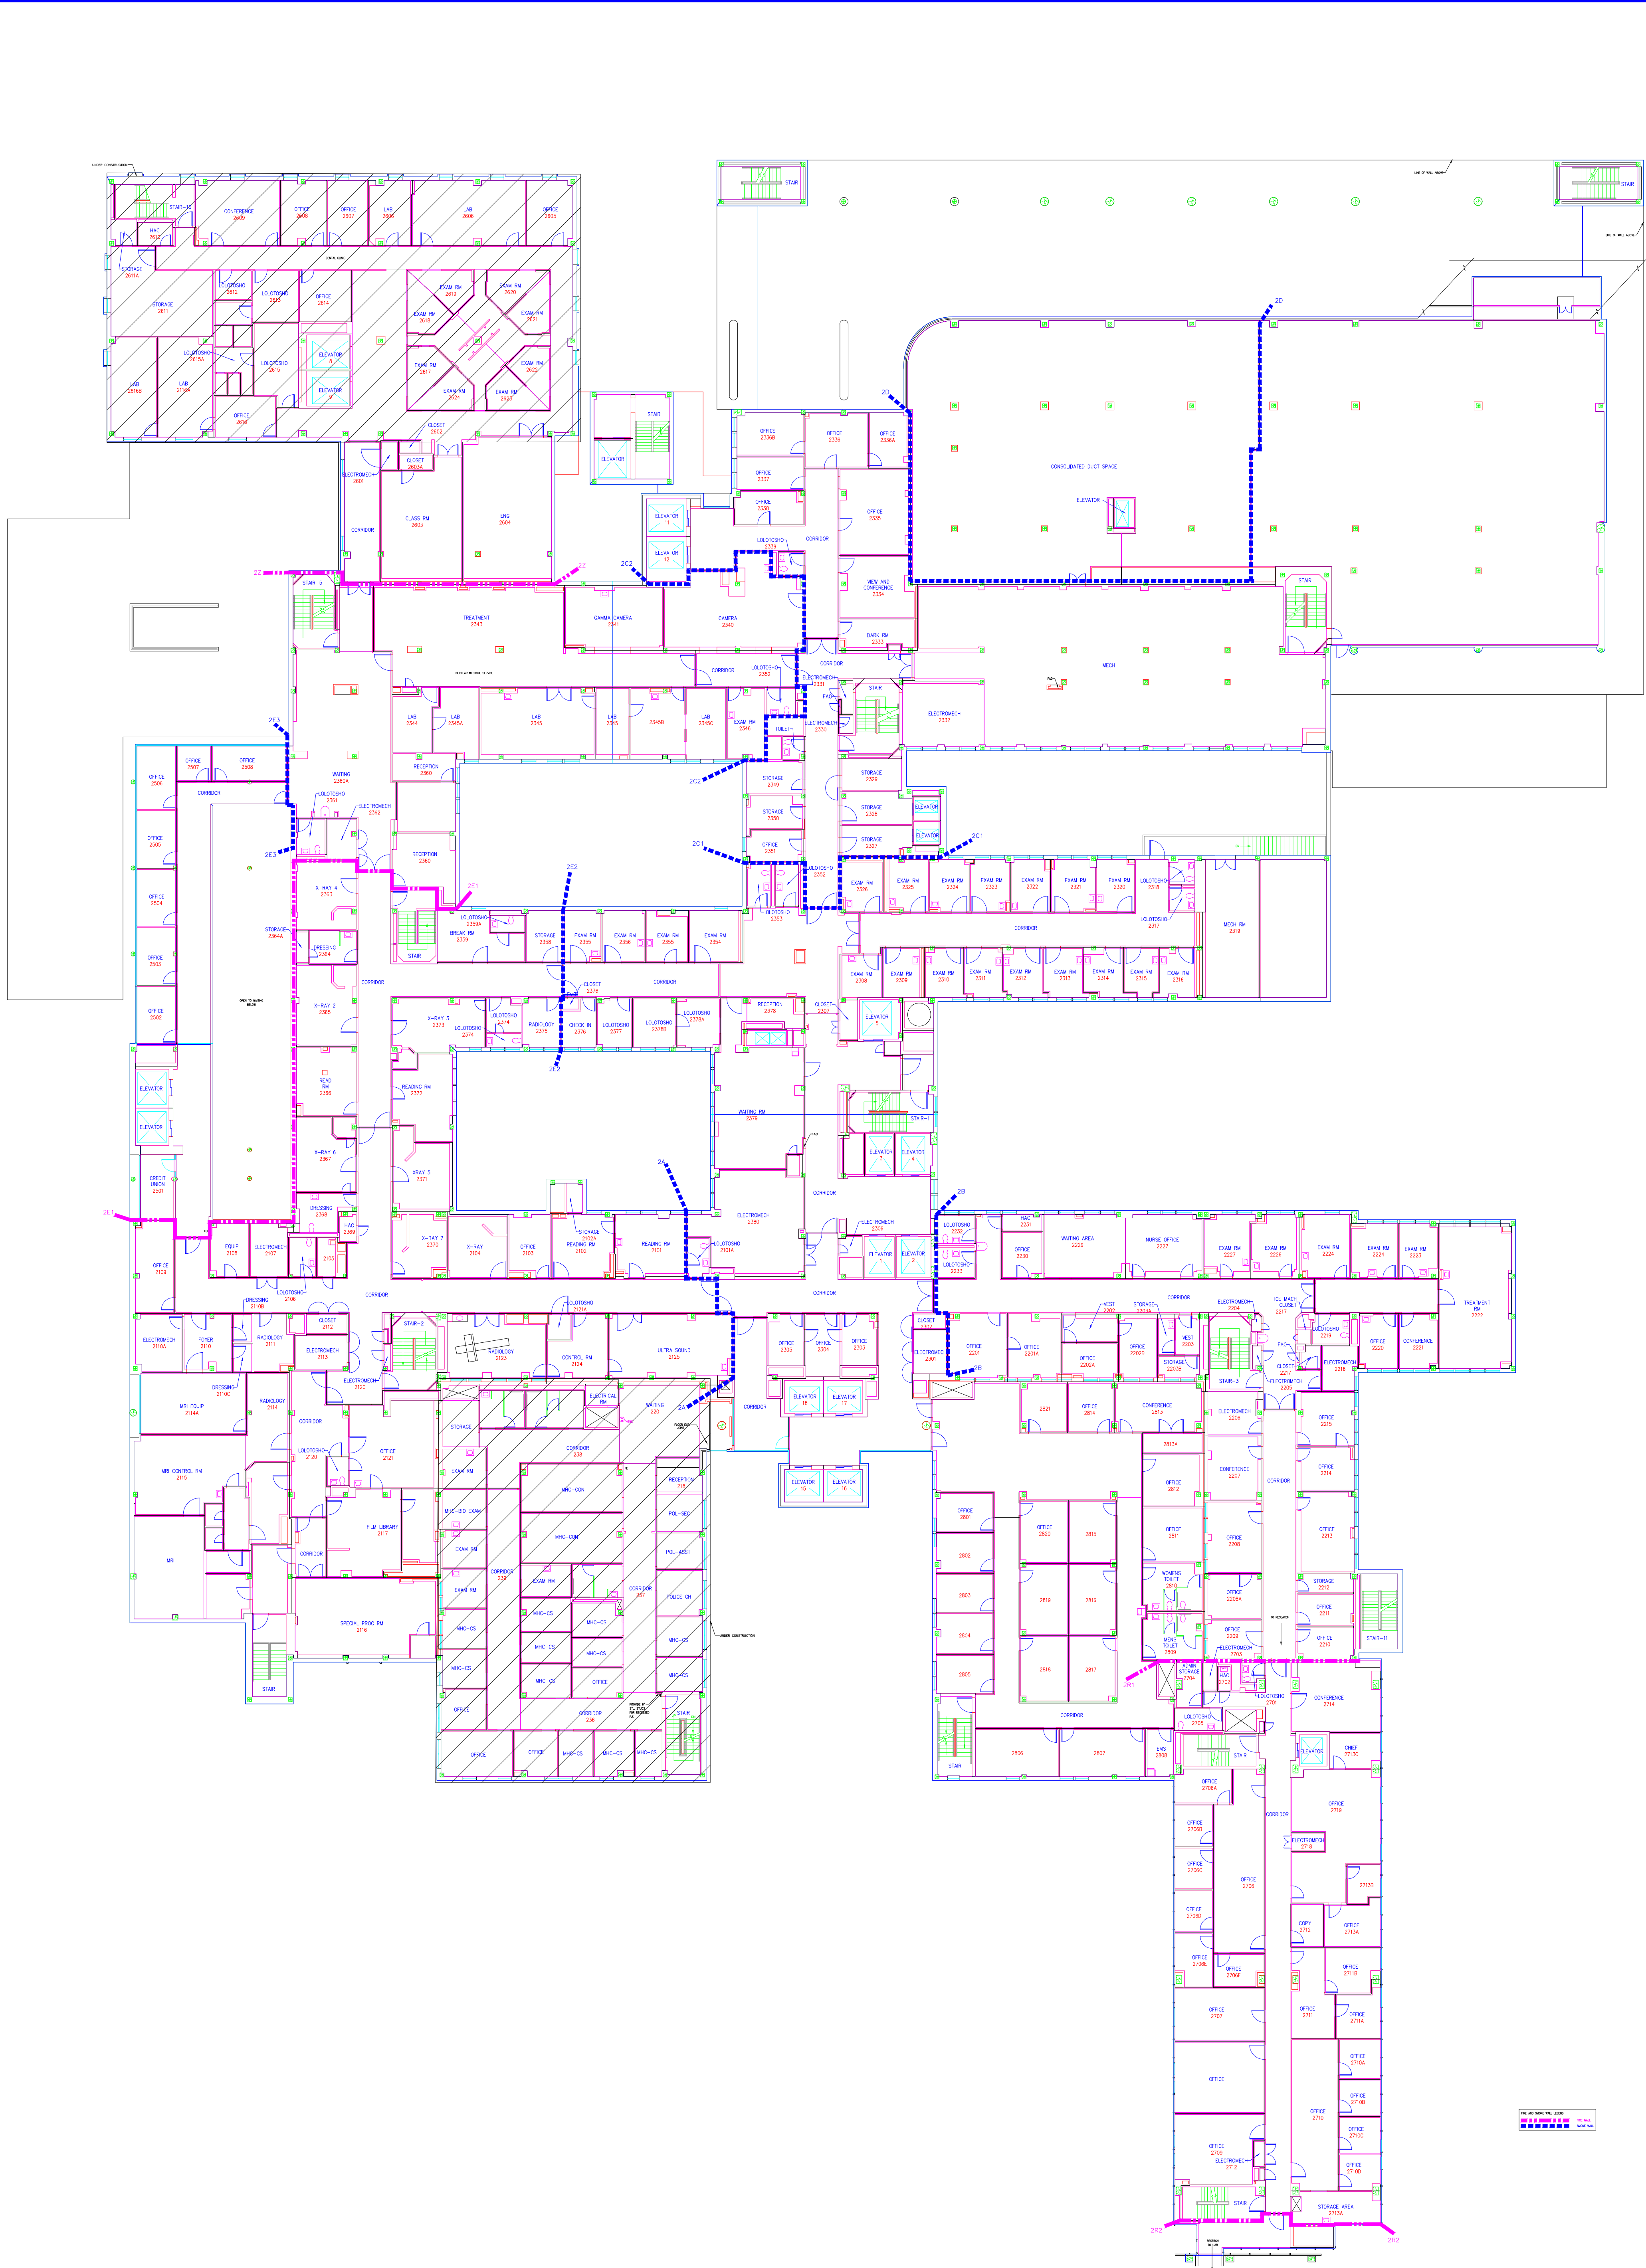

three inches = one foot
one and one half inches = one foot
one inch = one foot
three quarters inch = one foot
one half inch = one foot
three eighths inch = one foot
one quarter inch = one foot
one eighth inch = one foot

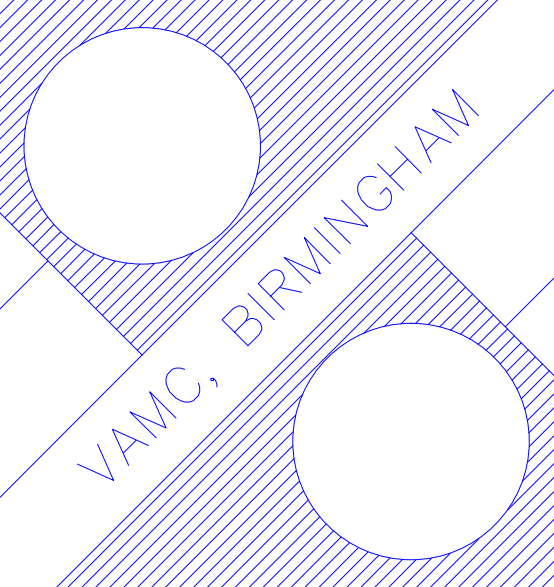Revisions		Date	Professional Seal		Drawing Title SECOND FLOOR PLAN ARCHITECTURAL		Project Title AS-BUILT Drawings		Date 11-30-2010				VA Department of Veterans Affairs			
					Approved:		Building Number 01		Checked	Drawn					Project No.	
					Approved:		Location VAMC BIRMINGHAM		Drawing No.							