

A

B

C

D

E

F

A

B

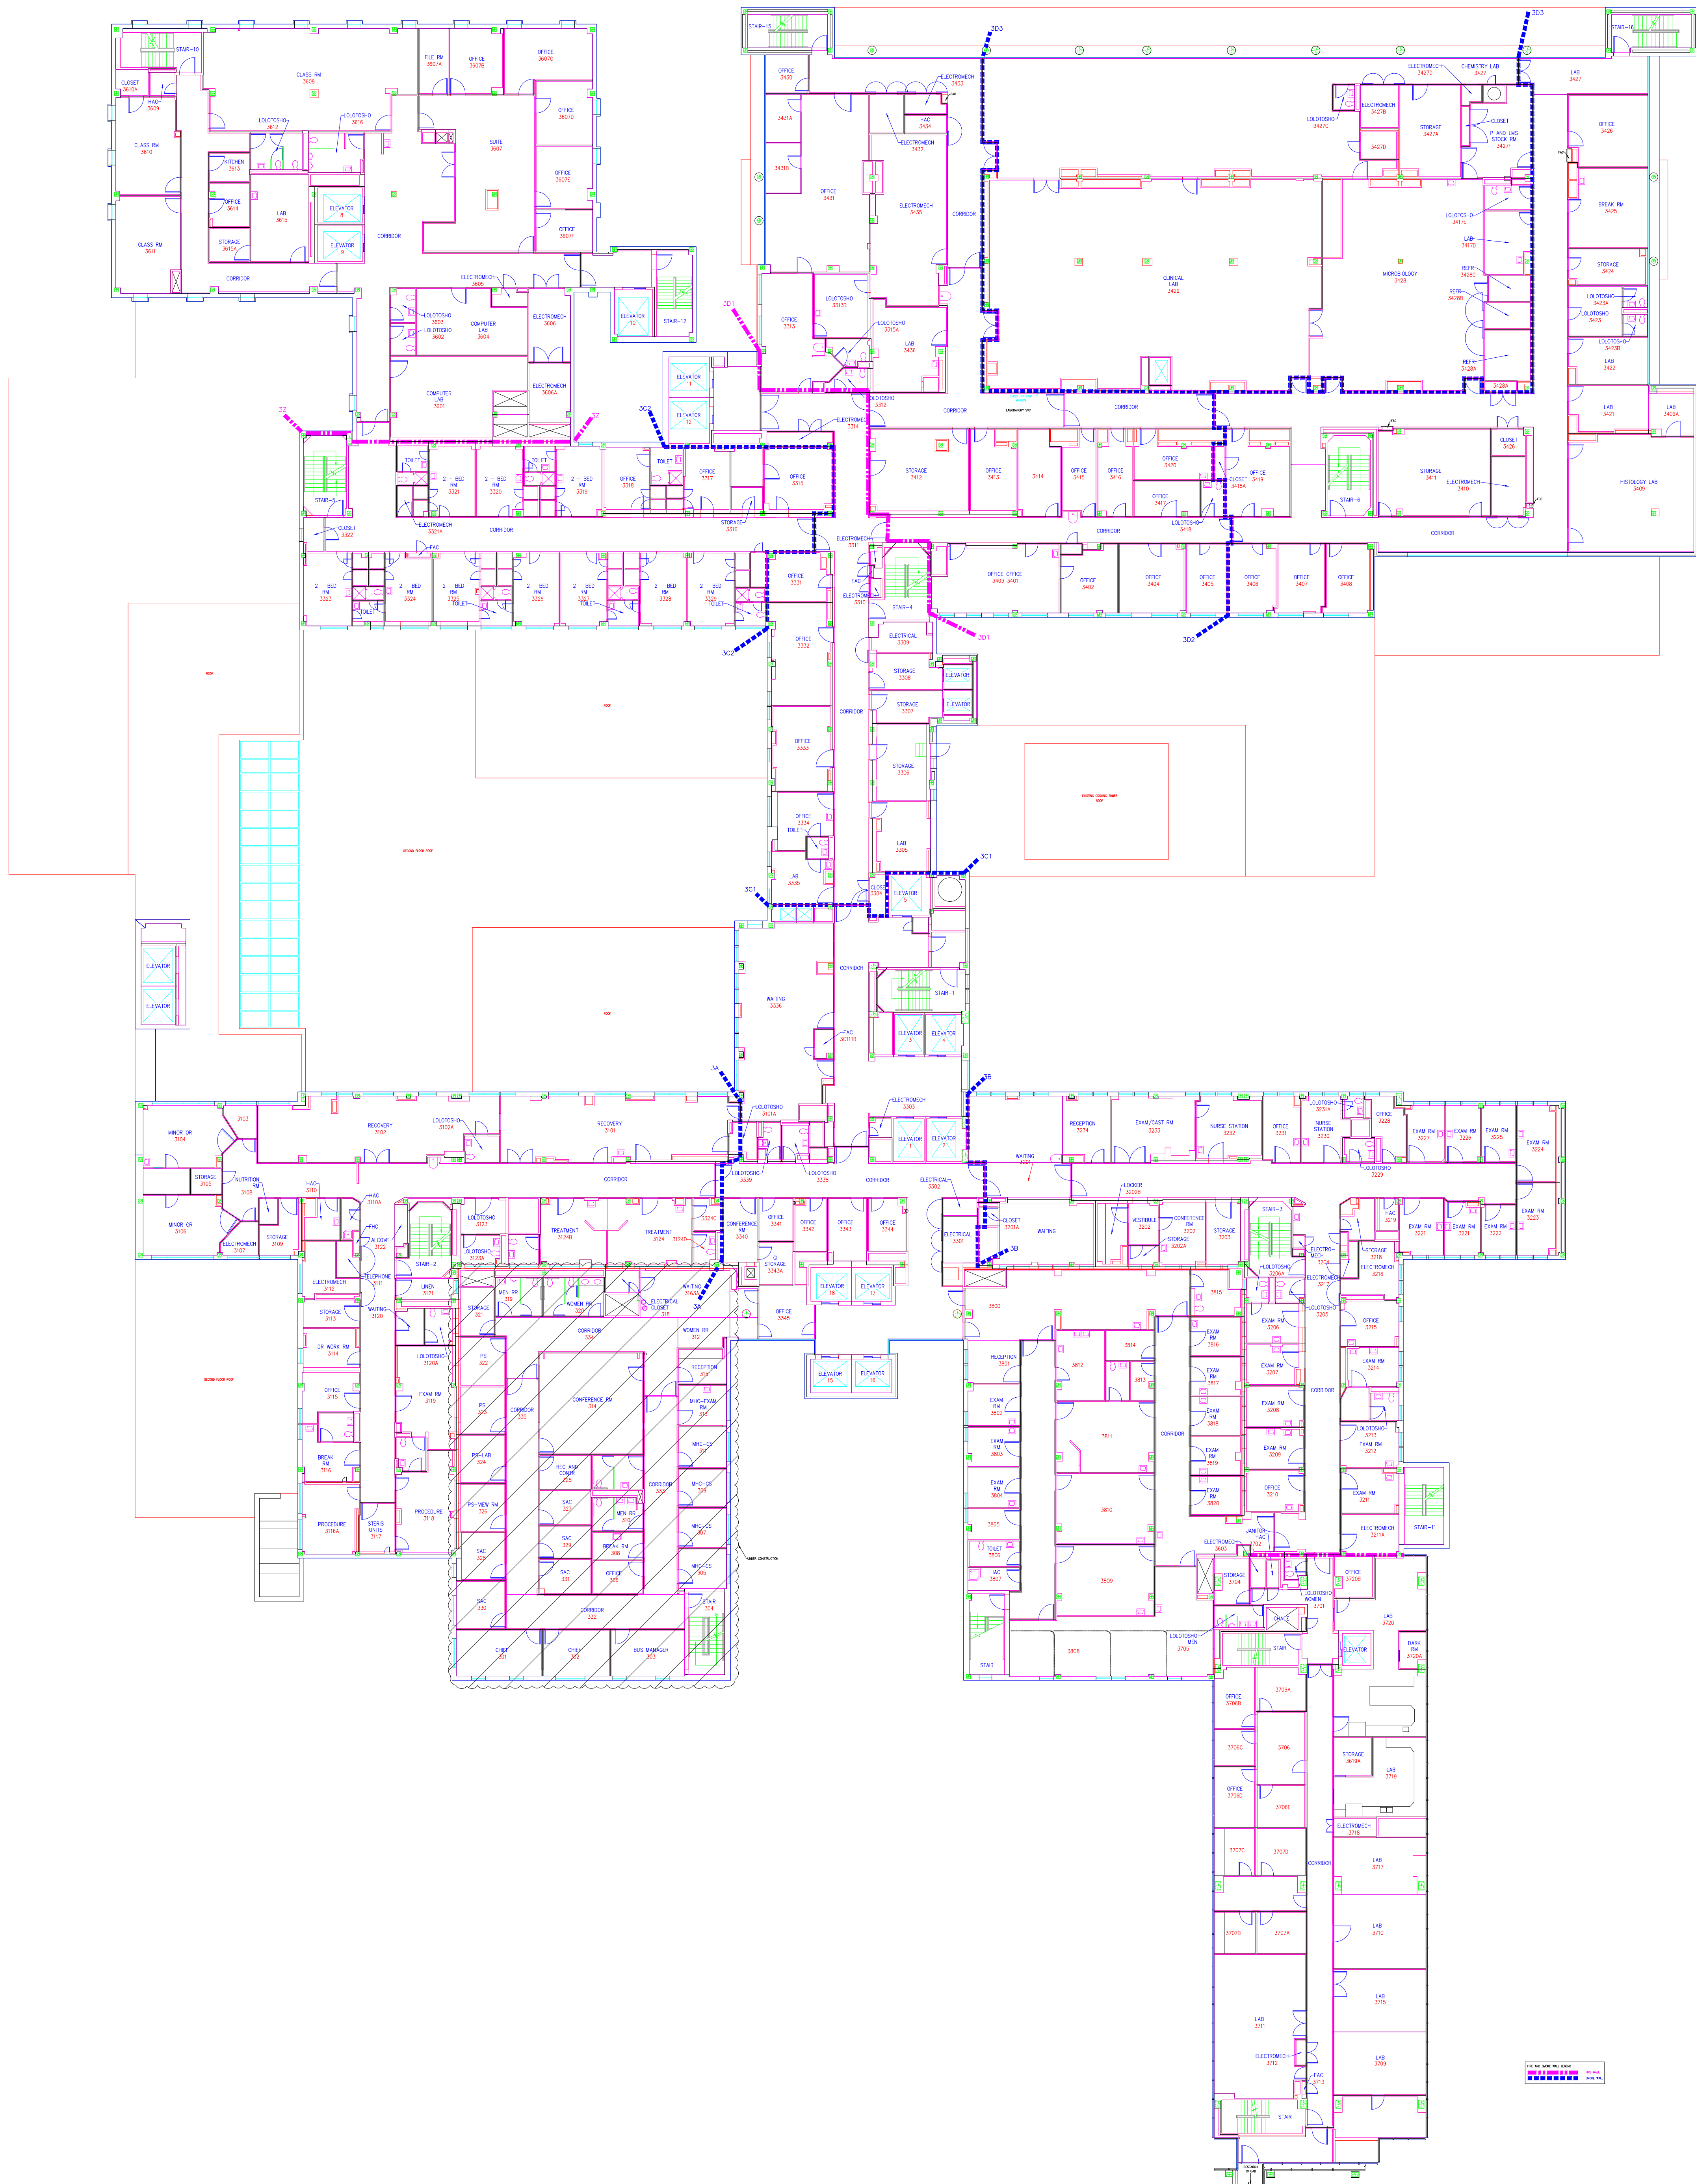
C

D

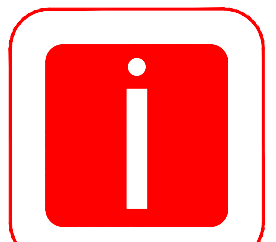

E

F

three inches = one foot  
one and one half inches = one foot  
one inch = one foot  
three quarters inch = one foot  
one half inch = one foot  
three eighths inch = one foot  
one quarter inch = one foot  
one eighth inch = one foot



1/8" = 1' - 0"

Revisions		Date	Professional Seal		 <b>Indus Systems, Inc.</b> 2352, Main Street, Concord MA 01742 Tel: 978-461-0555 www.indus-systems.com		Drawing Title THIRD FLOOR PLAN ARCHITECTURAL		Project Title AS-BUILT Drawings		Date 12-01-2010 Project No.		 VAMC, BIRMINGHAM		VA Department of Veterans Affairs	
Approved:		Approved:		Building Number 01		Checked		Drawn		Drawing No.						
Approved:		Approved:		Location VAMC BIRMINGHAM												