
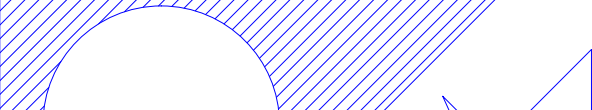


				<div><div></div><div>Indus Systems, Inc. 2352, Main Street, Concord MA 01742 Tel: 978-461-0555 www.indus-systems.com</div></div>		Drawing Title EIGHTH FLOOR PLAN ARCHITECTURAL		Project Title AS-BUILT Drawings		Date 11-18-2010			VA Department of Veterans Affairs				
						Approved:		Building Number 01		Checked				Drawn		Project No.	
Revisions		Date		Professional Seal		Approved:		Location VAMC BIRMINGHAM		Drawing No.							