

A

B

C




 
D

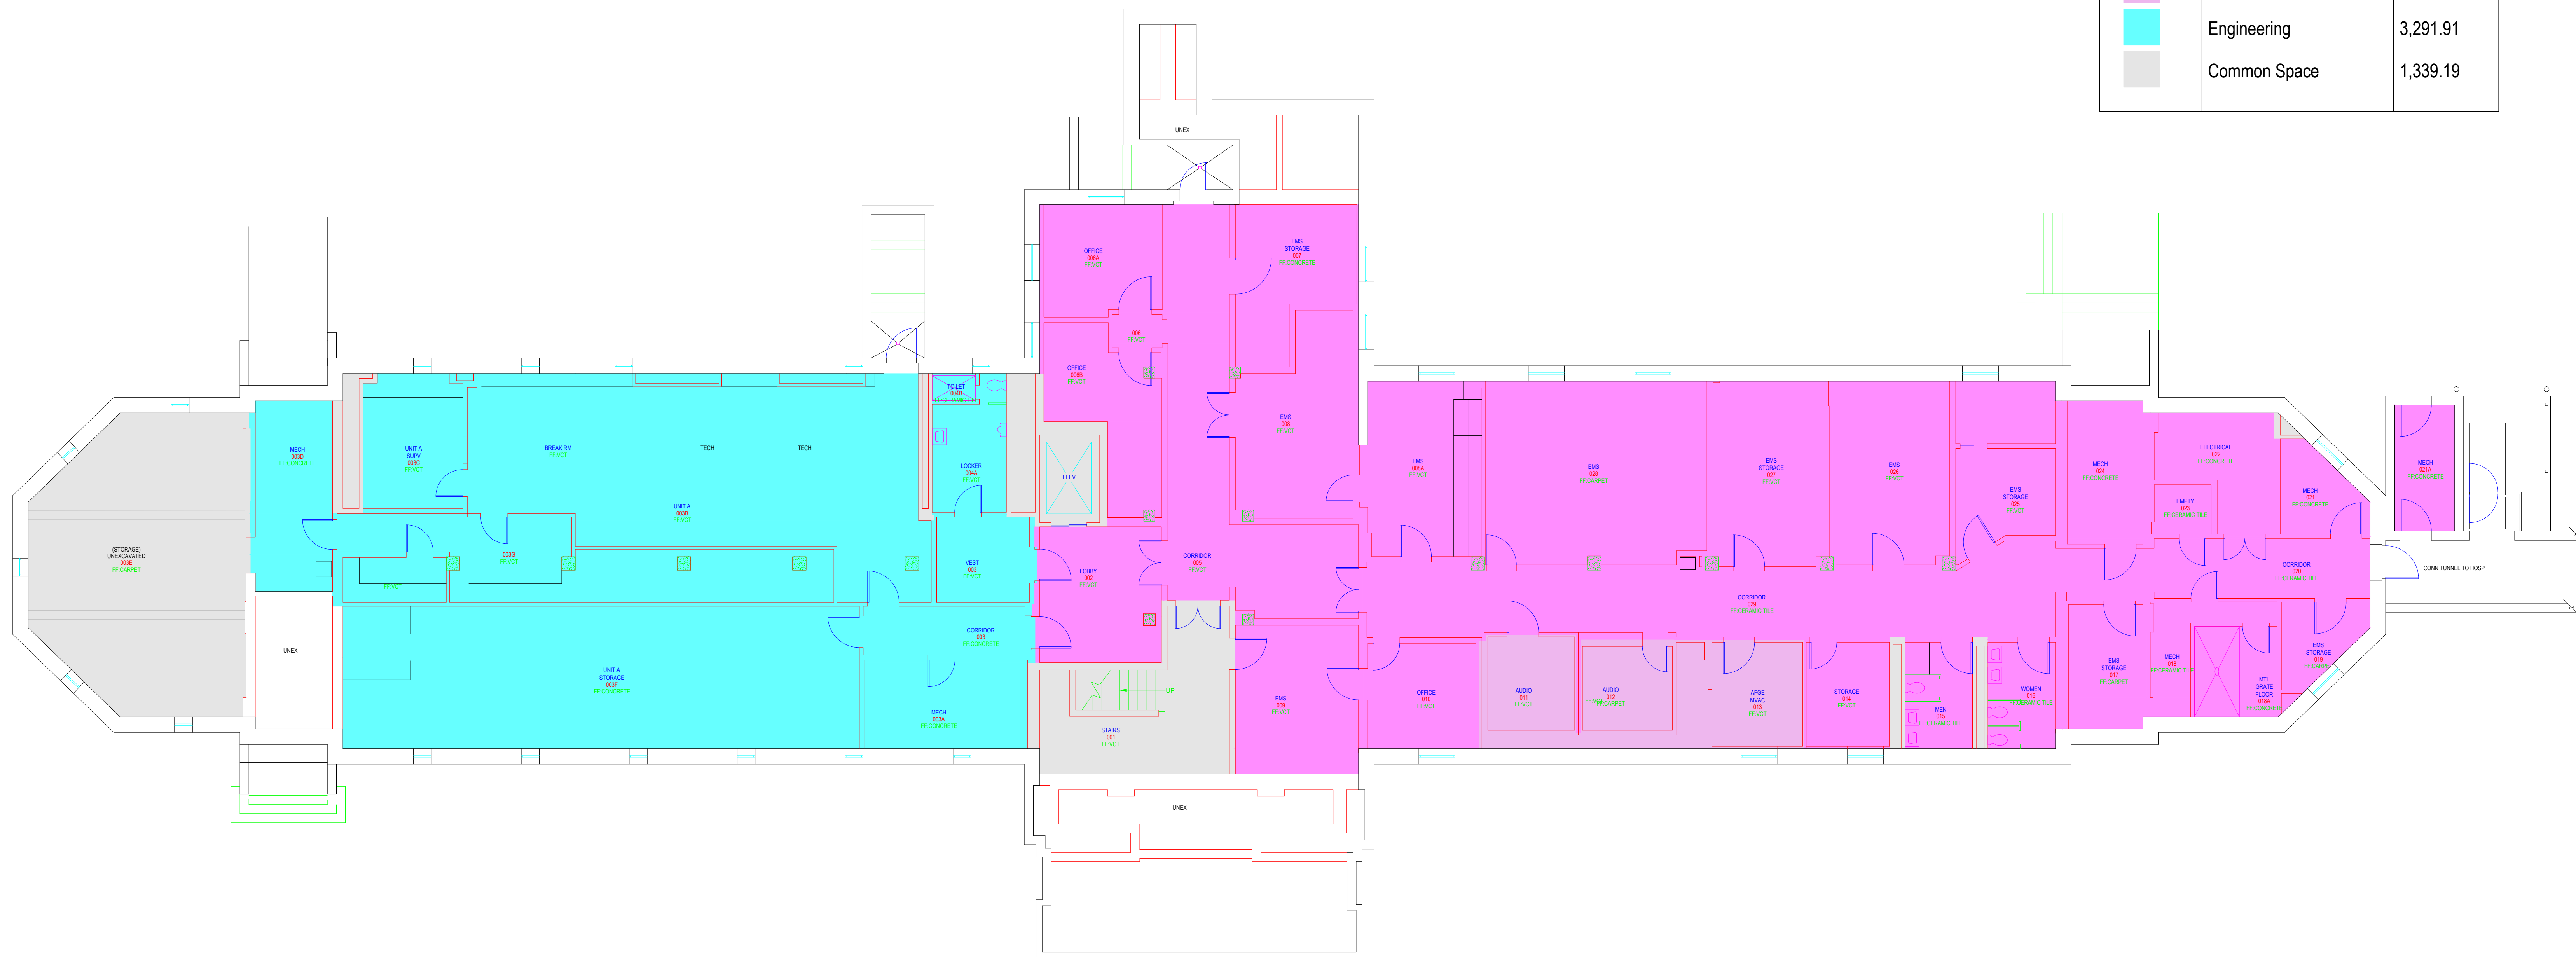
E

F

three inches = one foot
one and one half inches = one foot
one inch = one foot
three quarters inch = one foot
one half inch = one foot
three eighths inch = one foot
one quarter inch = one foot
one eighth inch = one foot




Site: Mountain Home, Building: 8, Floor: Ground

Hatch Pattern	Service	Area Sq. Ft.
	EMS	5,701.67
	Audiology	439.50
	Engineering	3,291.91
	Common Space	1,339.19



NOTES:
FF - FLOOR FINISH



Revisions	Date	Professional Seal	 Indus Systems, Inc. 2352, Main Street, Concord MA 01742 Tel: 978-461-0555 www.indus-systems.com	Drawing Title GROUND FLOOR PLAN ARCHITECTURAL		Project Title AS-BUILT Drawings			Date 09-03-2013	 VAMC MOUNTAIN HOME	Department of Veterance Affairs 
				Site: MOUNTAIN HOME	Building: 08	Drawn:	Checked:	Approved:	Project No.		
				Location: VAMC MOUNTAIN HOME		Approved:					

1

2

3

4

5

6

7

8

9

A

B

C

D

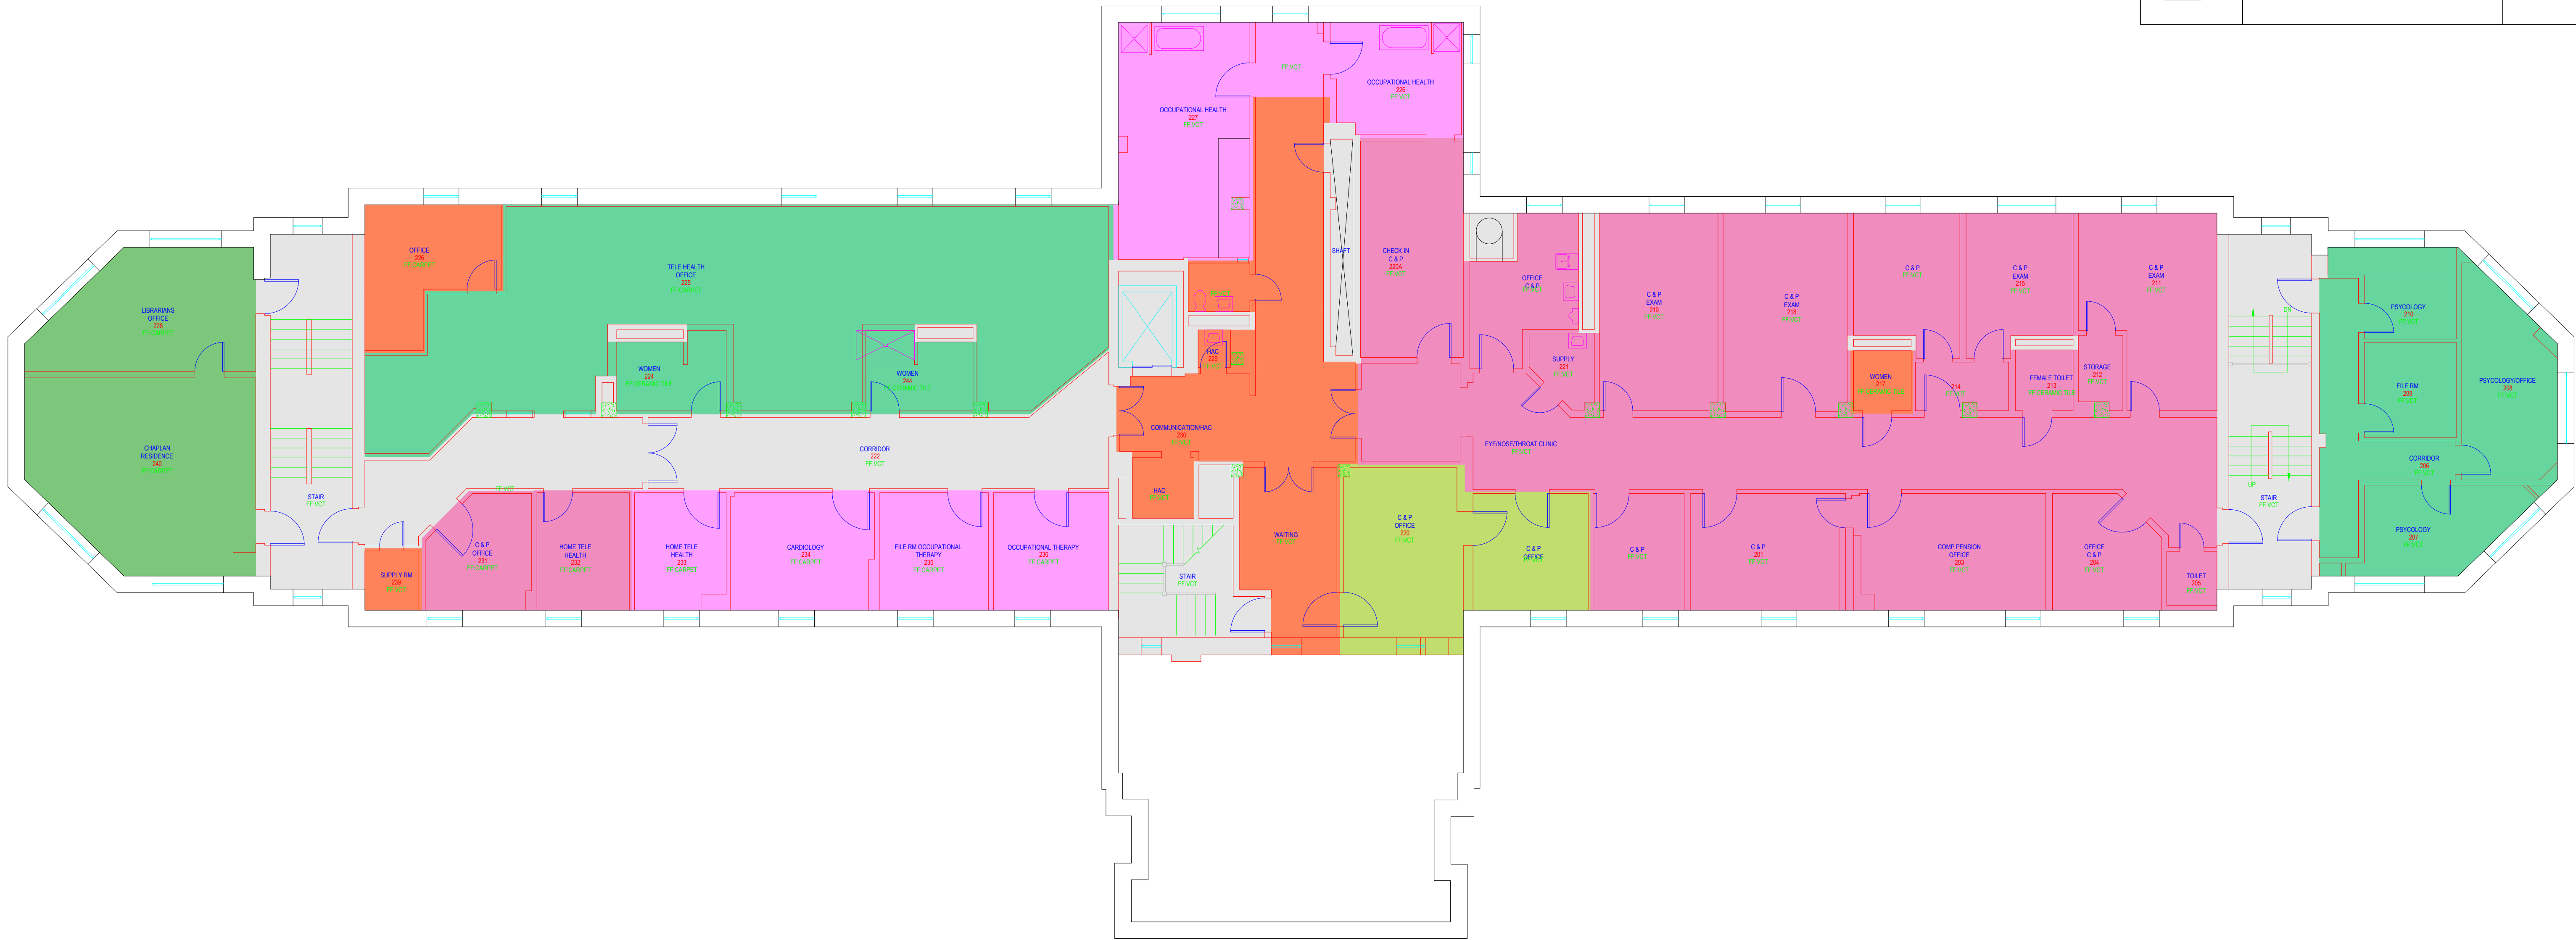
E

F

three inches = one foot
one and one half inches = one foot
one inch = one foot
three quarters inch = one foot
one half inch = one foot
three eighths inch = one foot
one quarter inch = one foot
one eighth inch = one foot

Site: Mountain Home, Building: 8, Floor: 2

Hatch Pattern	Service	Area Sq. Ft.
	Chaplain	700.77
	Occupational Health	1,161.59
	Compensation and Pension	3,495.42
	PIG	408.08
	Vacant	2,180.49
	Service Not Available	958.84
	Common Space	2003.42



NOTES:
FF - FLOOR FINISH



Revisions	Date	Professional Seal	 Indus Systems, Inc. 2352, Main Street, Concord MA 01742 Tel: 978-461-0555 www.indus-systems.com	Drawing Title SECOND FLOOR PLAN ARCHITECTURAL		Project Title AS-BUILT Drawings			Date 09-03-2013	 VAMC MOUNTAIN HOME	Department of Veterance Affairs
				Site: MOUNTAIN HOME	Building: 08	Drawn:	Checked:	Approved:	Project No.		
				Location: VAMC MOUNTAIN HOME		Approved:					

1

2

3

4

5

6

7

8

9

A

B

C





D

E

F

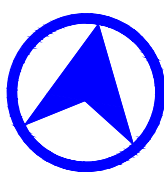
three inches = one foot
one and one half inches = one foot
one inch = one foot
three quarters inch = one foot
one half inch = one foot
one quarter inch = one foot
one eighth inch = one foot
one eighth inch = one foot

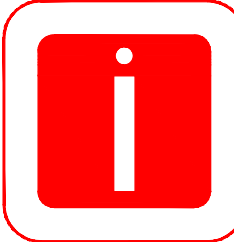
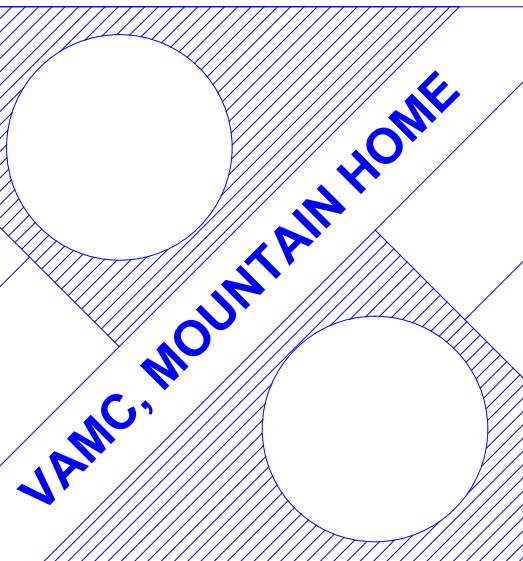

Site: Mountain Home, Building: 8, Floor: 3

Hatch Pattern	Service	Area Sq. Ft.
	Fiscal	3,172.59
	ACQ	4,150.06
	Service Not Available	2,333.68
	Common Space	1,753.04



NOTES:
FF - FLOOR FINISH



Revisions	Date	Professional Seal	 <div>Indus Systems, Inc. 2352, Main Street, Concord MA 01742 Tel: 978-461-0555 www.indus-systems.com</div>	Drawing Title THIRD FLOOR PLAN ARCHITECTURAL		Project Title AS-BUILT Drawings			Date 09-03-2013	 <div>VAMC MOUNTAIN HOME</div>	Department of Veterance Affairs 	
				Site: MOUNTAIN HOME	Building: 08	Drawn:	Checked:	Approved:	Project No.			Drawing No.
				Location: VAMC MOUNTAIN HOME		Approved:						

1

2

3

4

5

6

7

8

9