


Eglin OPC Floor Plan

A - 4

A-4

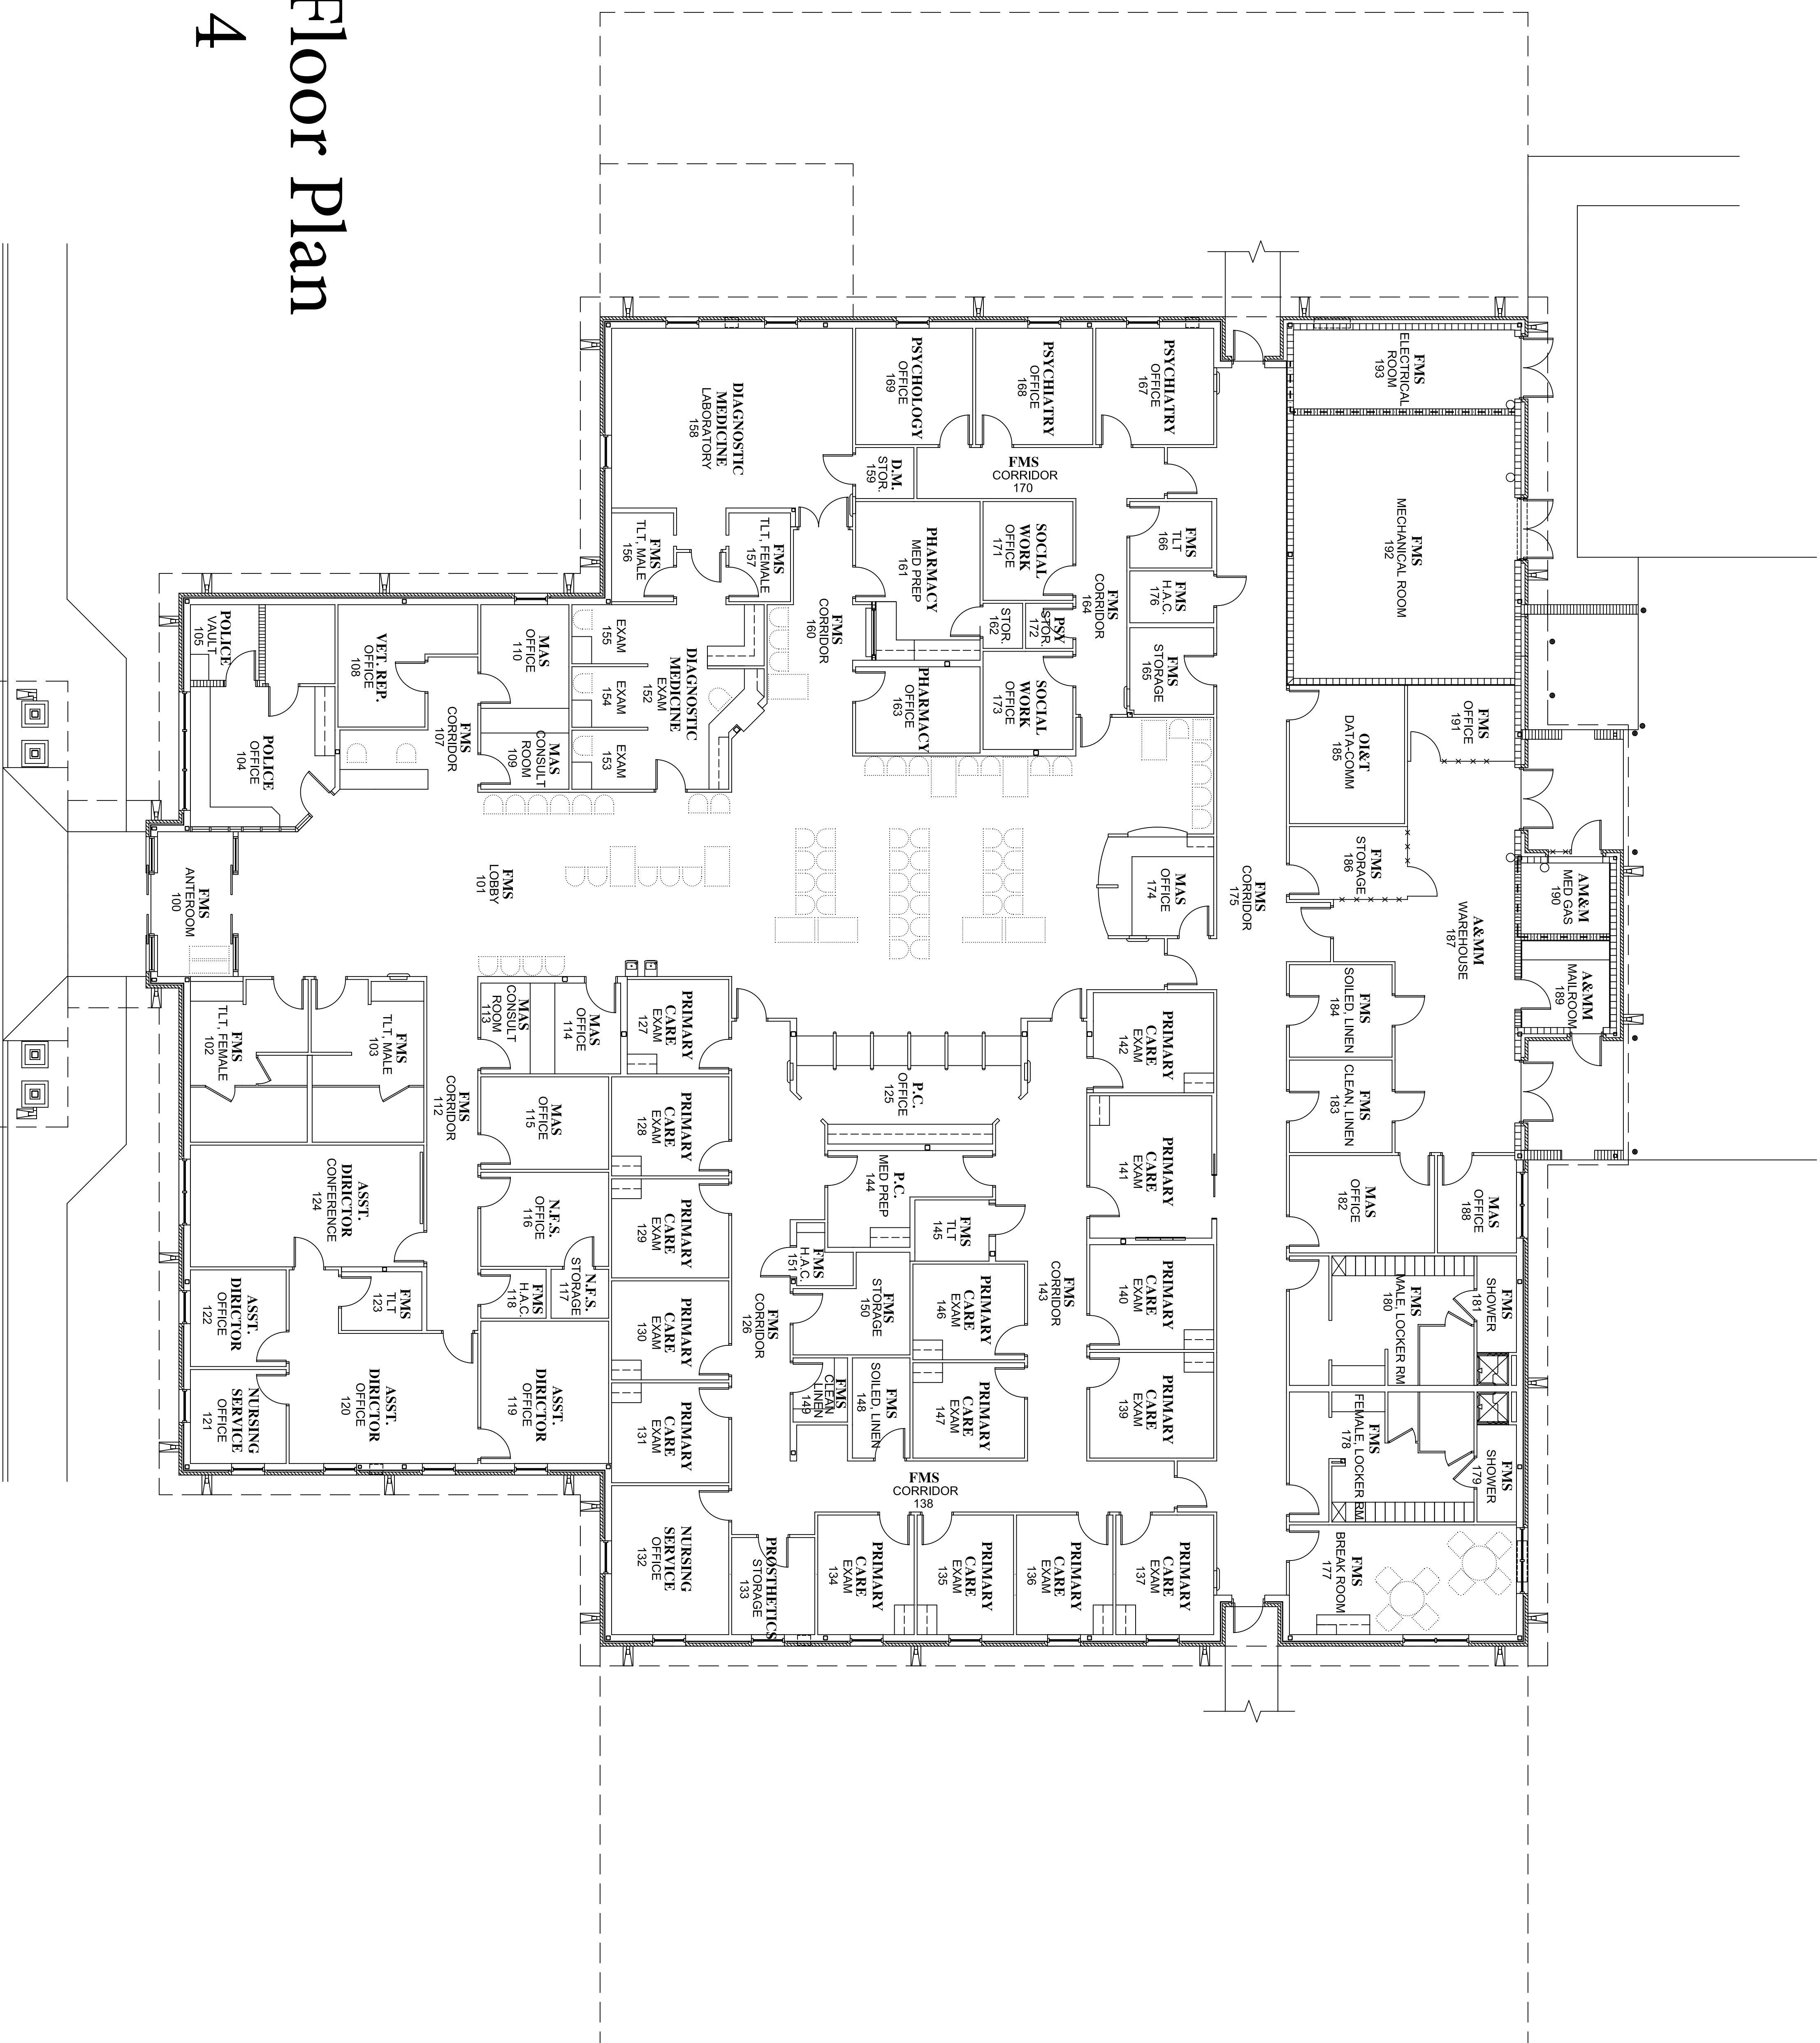

NOTES:

NOTES:	
Approved: _____	
PROGRAM MANAGER, PROJECTS _____	
SAFETY/INDUSTRIAL HYGIENE _____	
HEALTH SYSTEMS SPECIALIST _____	
MAINTENANCE SUPERVISOR _____	
MAINTENANCE FOREMAN _____	
MAINTENANCE FOREMAN _____	
Approved: Service Director _____	
Drawing Title EGLIN AFB CLINIC ARCHITECTURAL PLAN	
Project Title AS-BUILT DRAWINGS	
Date 01/01/09	Project No. _____
DRAWING NO. EGLIN-ARI	
Page 1 of 1	
Building Number EGLIN AFB	
Checked	Drawn
Location EGLIN AFB, FL	
Office of Facilities	
Department of Veterans Affairs	

 Department of
Veterans Affairs