

	FIRE HYDRANT		MANHOLE
	STORM DRAIN MANHOLE		CURB INLET
	SURFACE INLET		SIGNAL DUCTBANK
	SIGNAL MANHOLE		POLE WITH SINGLE FIXTURE
	POLE WITH 2 FIXTURE		ELECTRICAL DUCTBANK
	ELECTRICAL MANHOLE		REMOVE EXISTING POLE & FIXTURE
	LIGHTING & CONTROL CIRCUIT		ENERGY MONITORING SYSTEM - 2'C
	HANDHOLE		HANDHOLE


NOTES BY SYMBOL ( )	
NOT	DESCRIPTION
1	EXISTING 15KV. DUCTBANK.
2	EXISTING 15KV. MANHOLE. ADD /DELETE EXTENSION RINGS AND ADJUST MANHOLE COVER TO MEET NEW GRADES SHOWN ON GRADING DRAWINGS.
3	120V. IRRIGATION CONTROL CIRCUIT (2#10 & 1#12GND. IN 1/2" C.). VERIFY EXACT LOCATION. VERIFY EXIST AND CIRCUIT TO AN EXISTING 120V. PANEL IN NURSING HOME BLDG. 60.
4	CONCRETE ENCASED DUCTBANK WITH 6-4"C. AND PULL LINES FOR FUTURE TELEPHONE CABLES.

NOTES THIS SHEET ONLY	
NOT	DESCRIPTION
1	REFER TO ARCHITECTURAL AND CIVIL PLANS FOR CONSTRUCTION PHASING REQUIREMENTS, LIMITS OF CONSTRUCTION, AND RELATED REQUIREMENTS.
2	EXISTING UTILITIES ARE SHOWN FROM AS-BUILT PLANS AND FIELD SURVEY (ACTUAL ROUTING MAY VARY). LOCATE ALL UNDERGROUND UTILITIES.
3	REFER TO LANDSCAPE DRAWINGS FOR EXACT LOCATION OF FIXTURES IN RELATIONSHIP TO SHRUBS, TREES, ETC.
4	ALL OUTDOOR EQUIPMENT SHALL BE OUTDOOR APPROVED.
5	ALL LIGHTING CIRCUITS TO HAVE SAME CONDUIT CONDUCTOR SIZES AS INDICATED ON HOMERUN.

RECORD DRAWINGS

THE INFORMATION SHOWN ON THESE DRAWINGS HAS BEEN BASED ON DOCUMENTS PROVIDED BY THE VETERANS AFFAIRS REGIONAL ENGINEER OFFICE. THE ARCHITECT/ENGINEER OF RECORD HAS NOT VERIFIED THE ACCURACY AND/OR COMPLETENESS OF THIS INFORMATION AND SHALL NOT BE RESPONSIBLE FOR ANY ERRORS OR OMISSIONS WHICH MAY BE INCORPORATED HEREIN AS A RESULT.

DATE

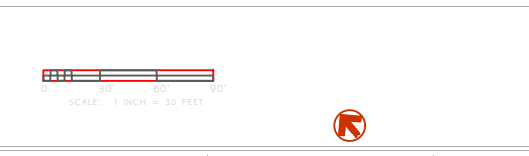

DAHL BRADEN PTM, INC.  
F&S PARTNERS, INC.  
A JOINT VENTURE  
1825 MARKET CENTER BLVD.  
DALLAS, TEXAS 75207-3332  
(214) 748-7337 FAX (214) 748-2284

STRUCTURAL ENGINEER  
EDWARD L. WILSON, JR.  
CONSULTING ENGINEERS  
2909 MAPLE AVENUE  
DALLAS, TEXAS 75201  
(214) 871-8801

M.E.P. & CIVIL ENGINEERS  
YANDELL HILLER & CO., INC.  
512 MAIN ST., SUITE 1500  
FORT WORTH, TEXAS 76102-1922  
(817) 335-3000 FAX (817) 335-1025

Drawing Title  
ELECTRICAL SITE PLAN AREA 1 -  
1" = 30'-0"

Approved: Area Project Manager

Project Title  
CLINICAL ADDITION

Date  
07/20/93

Project No.  
549-085

Building Number  
CMC

Drawn  
JG

Location  
VA MEDICAL CENTER, DALLAS, TEXAS

DRAWING NO.  
E3

Dwg. Of

