


TYPICAL FOR MASTER 2

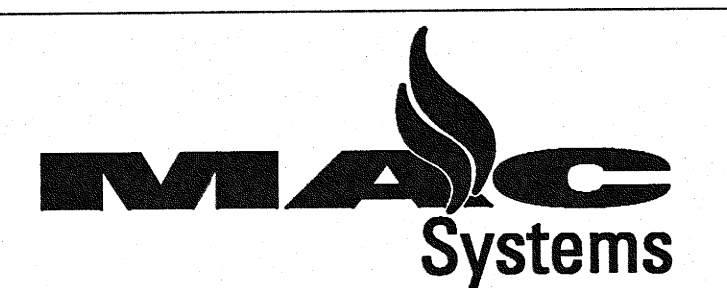

210 South Norfolk
 Tulsa, Oklahoma 74120
 Voice (918) 582-1148 Fax (918) 582-3700
 Oklahoma Alarm License # 0363

Department of Veterans Affairs			
VA Medical Center			
921 NE 13th Street			
Oklahoma City, Oklahoma 73104			
SCALE:	NTS	DRAWN BY:	Tom Deter
DESIGNER:	Tom Deter	AHL	
JOB NUMBER:	15254	DRAWING DATE:	As-Built - 2/16/07
FLOOR:	Remote Multiplex Panel Single IH Card Wiring Diagram		
DRAWING TYPE:	Fire Detection and Alarm System		
SHEET NUMBER:	FA1.37		