



PLAN VIEW

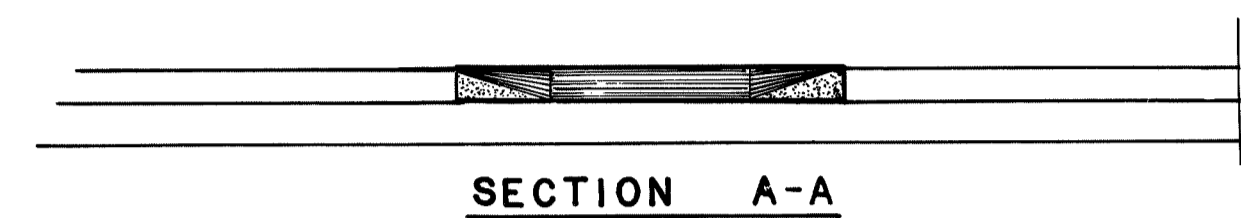


SECTION A-A

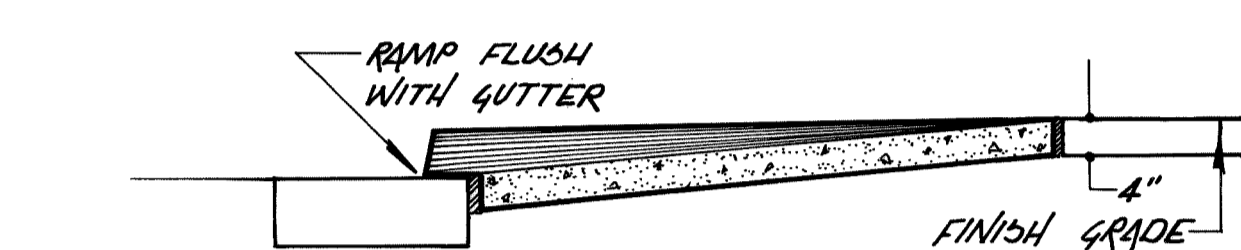

SECTION B-B

NOTES:
 PROVIDE WARNING LINES PERPENDICULAR TO TRAFFIC, 3 FEET FROM TRAFFIC LANE.
 E.J. - EXPANSION JOINT
 C.J. - CONTROL JOINT
 C&G - CURB & GUTTER

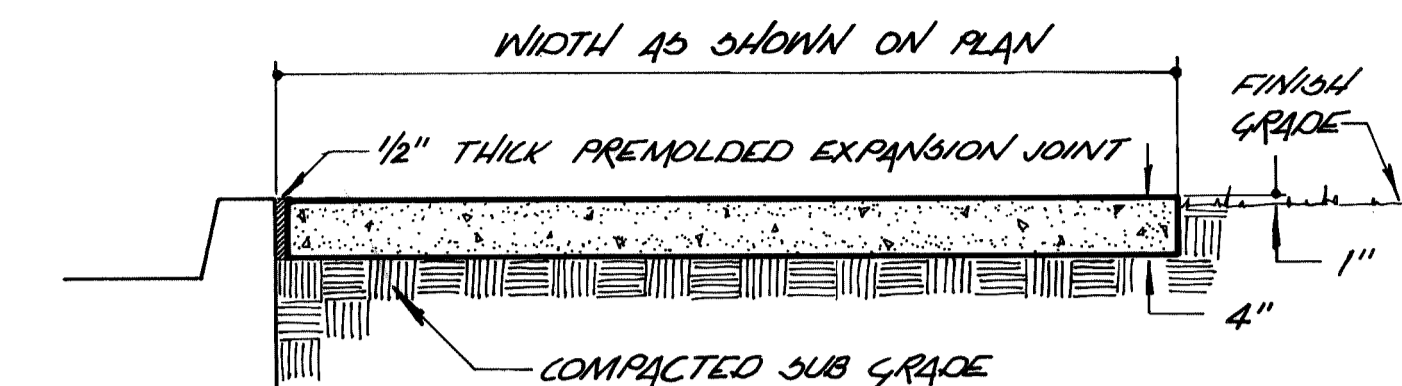

NOTES:
 PROVIDE MIN 3" RADIUS FILLETS AT ALL WALK INTERSECTIONS
 ALL SIDEWALKS TO BE 4" THICK
 PROVIDE 1/2" EXP JOINT BETWEEN ALL FIXED OBJECTS AND WALK
 PROVIDE TRANSVERSE CONTRACTION JOINTS

2 CONCRETE PEDESTRIAN PAVEMENT



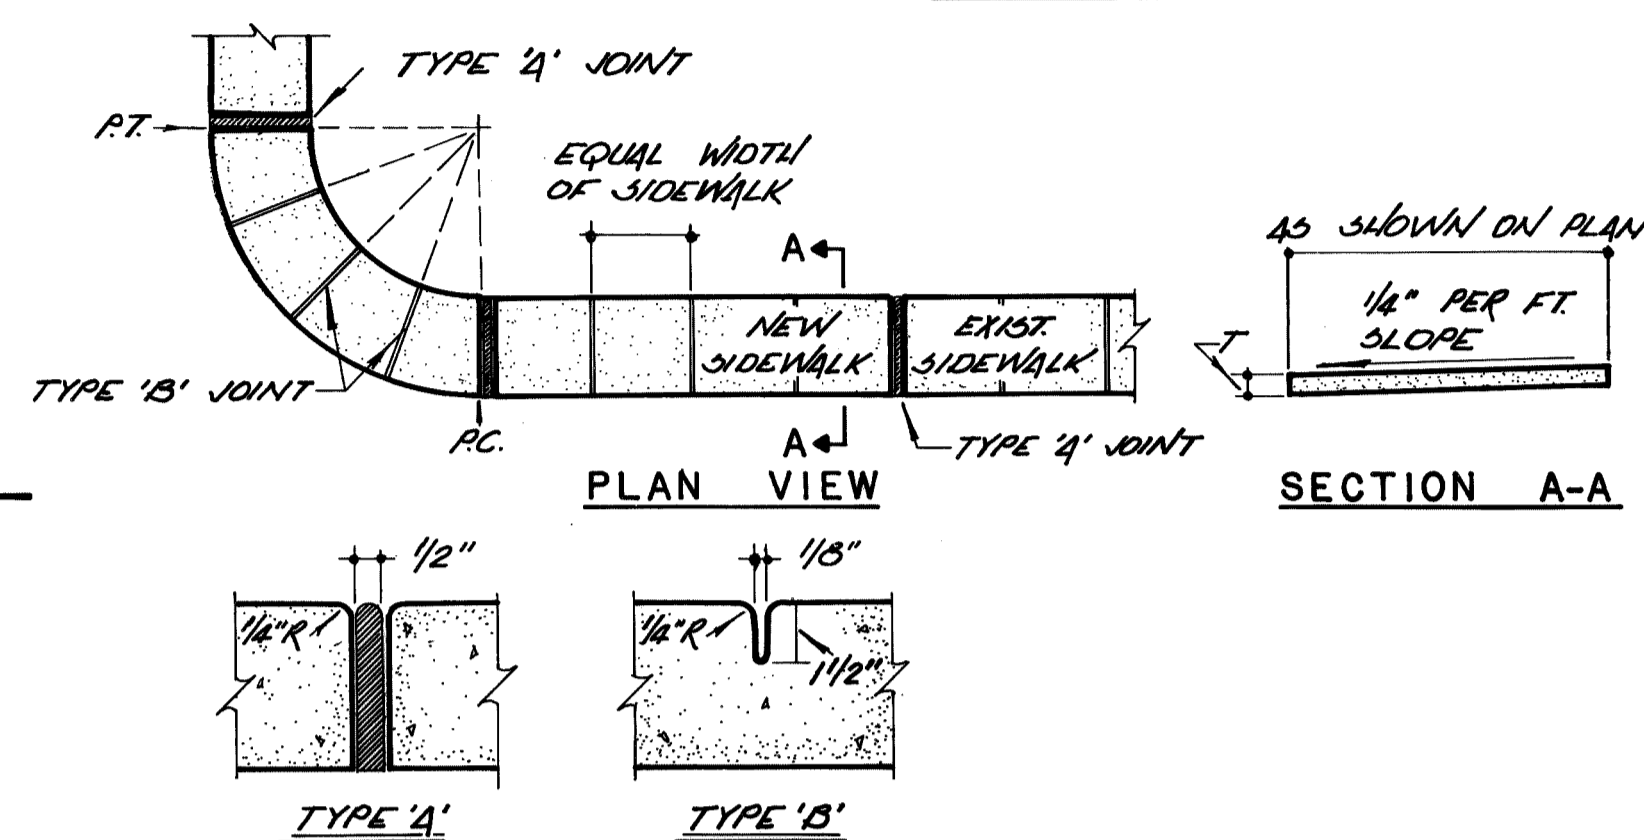



TABLE OF SIDEWALK JOINTS	
TYPE	LOCATION
1'	WHERE SIDEWALKS ABUT CONCRETE CURBS, WALKS AND SIMILAR STRUCTURES AND AT LEAST EVERY 50'
15'	ON CENTERS EQUAL TO SIDEWALK WIDTH NOT TO EXCEED 20'

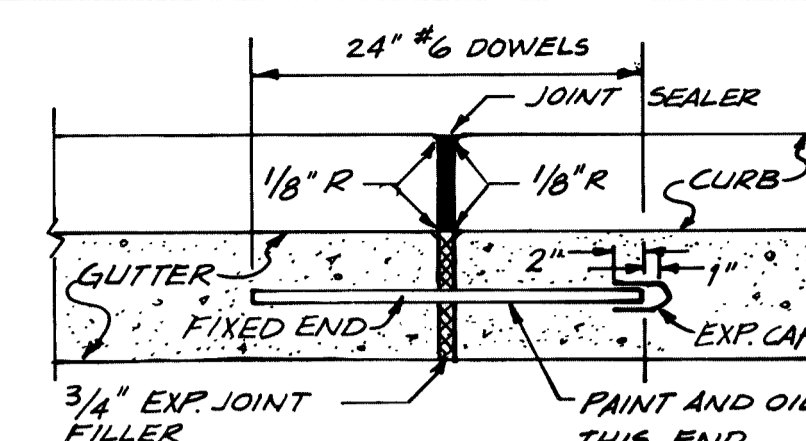

EXPANSION JOINT

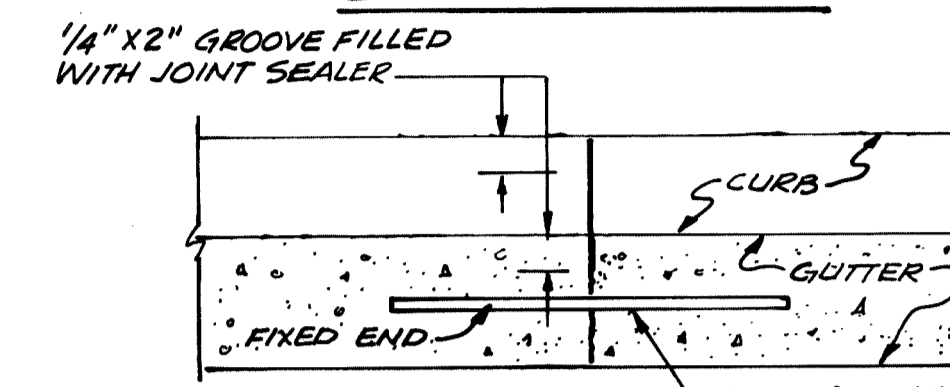


CONTRACTION JOINT

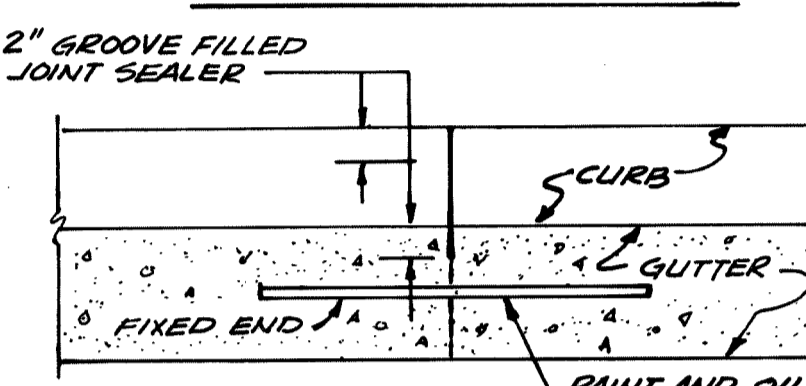


CONSTRUCTION JOINT

4 COMBINATION CURB & GUTTER JOINTS

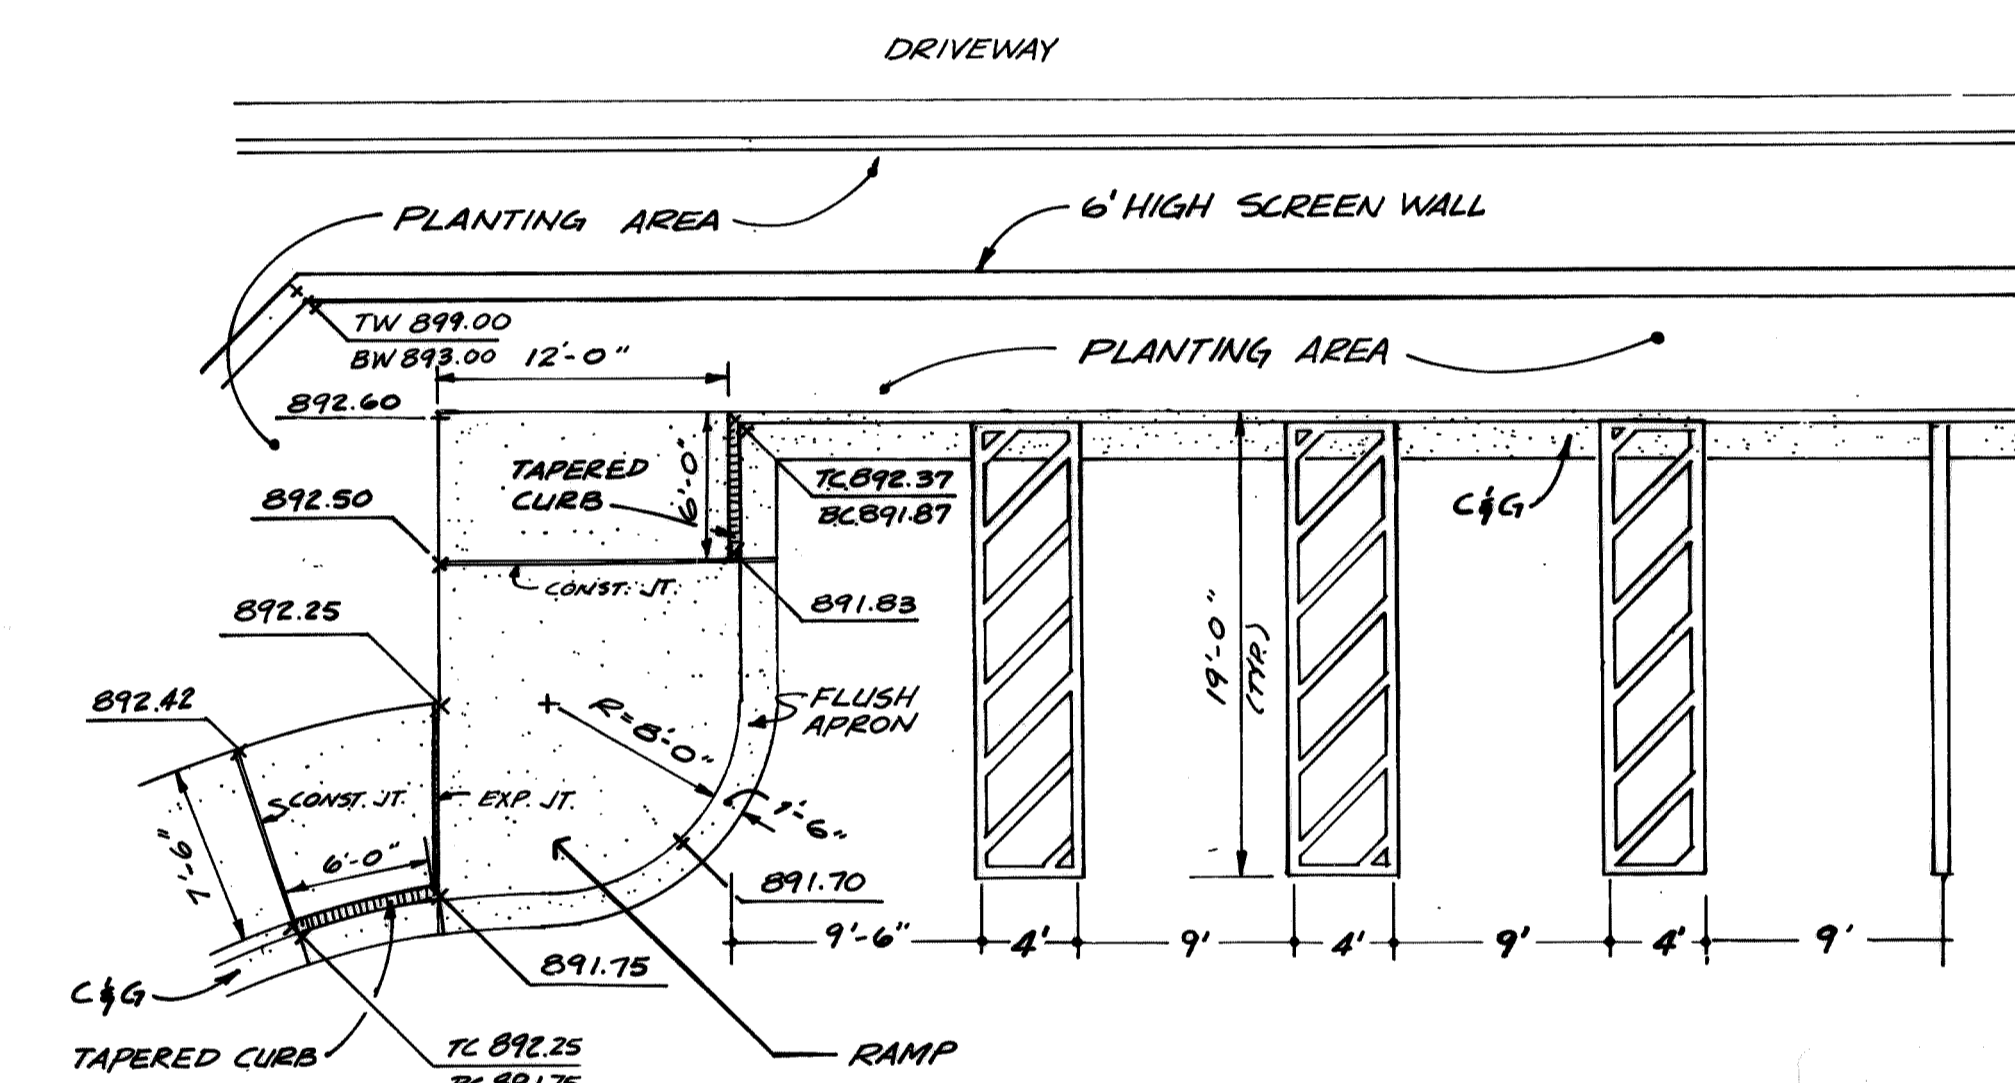


6-0-2-2230


7 HANDICAPPED PARKING LAYOUT

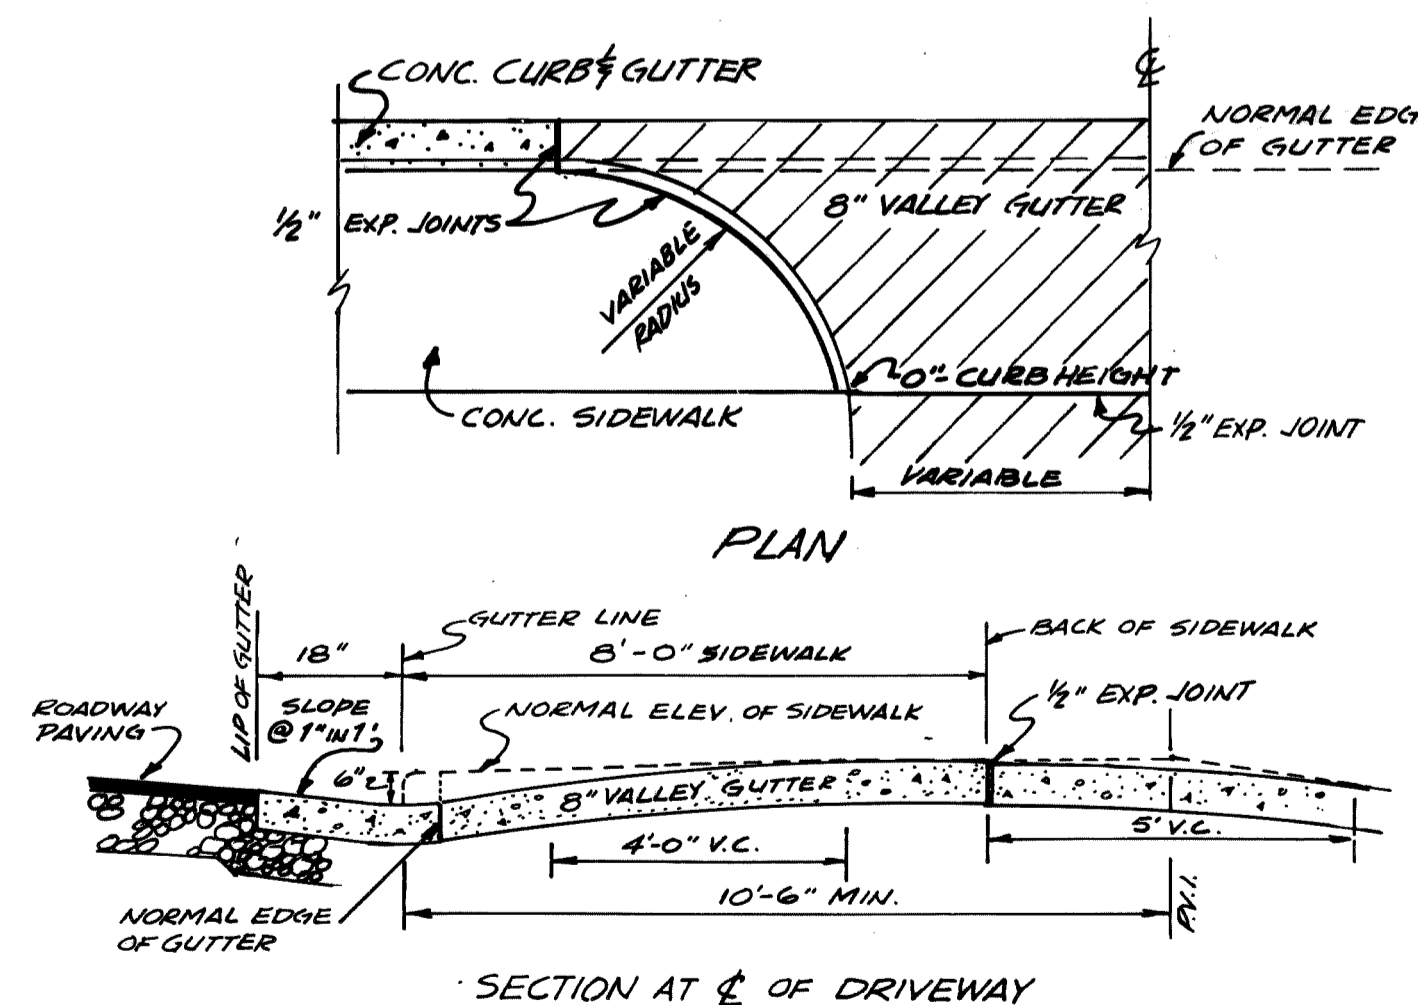

SECTION AT E OF DRIVEWAY

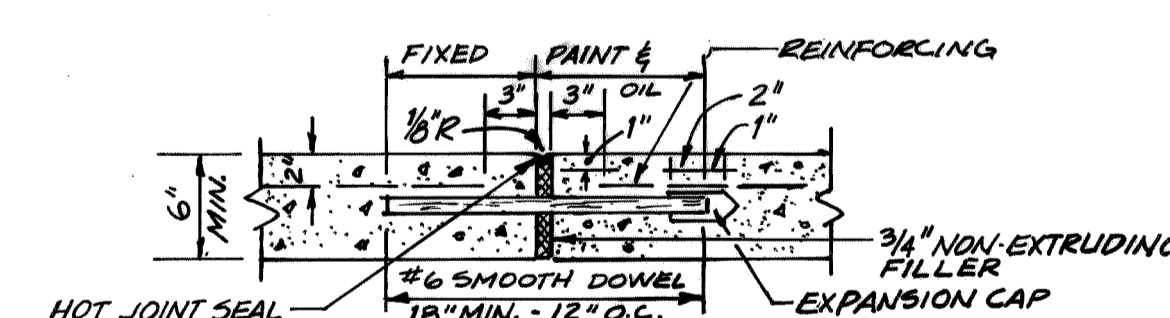

EXPANSION JOINT

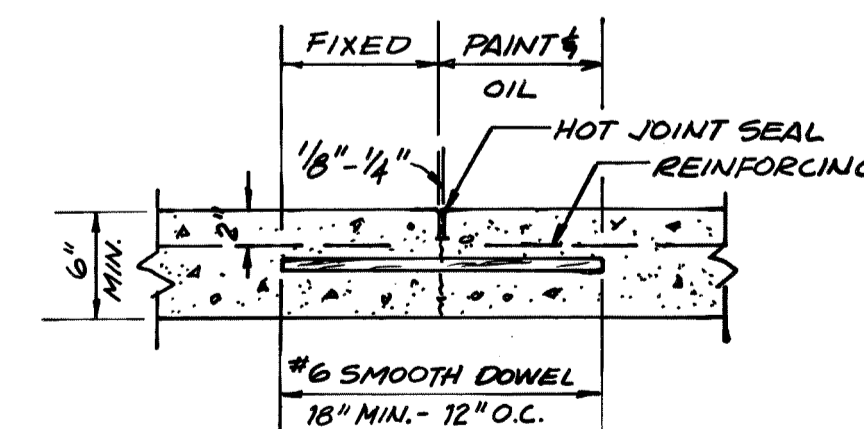


CONTRACTION JOINT

NOTE:
 BEGIN DOWELS 6" FROM LONGITUDINAL CONST. JOINT

SERVICE AREA TRANSVERSE JOINTS


12 CONCRETE DRIVEWAY APRON

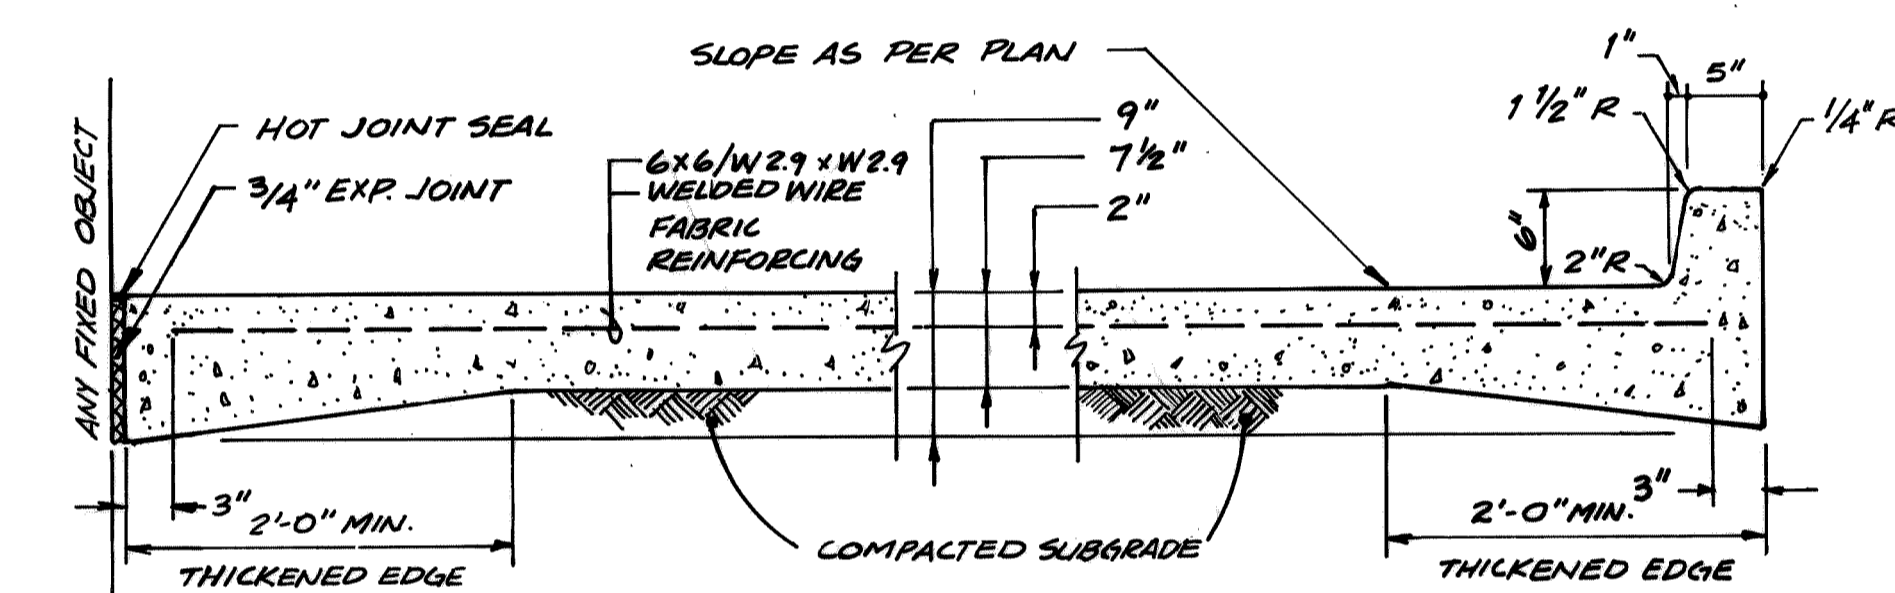


1. THE MIN. LAP OF FABRIC SHALL BE TWELVE (12) INCHES FROM END CROSS WIRES.
2. REINFORCING STEEL IS TO BE CUT SO THAT NO STEEL COMES WITHIN THREE (3) INCHES OF THE OUTER EDGES AND ENDS OF THE SLAB.
3. CURB AND GUTTER CAST INTEGRAL WITH OR DOWNELED TO PAVEMENT SHALL HAVE JOINTS COINCIDE WITH PAVEMENT JOINTS.

6 CONCRETE SERVICE AREA SECTION


5 SERVICE AREA LONGITUDINAL CONSTRUCTION JOINT

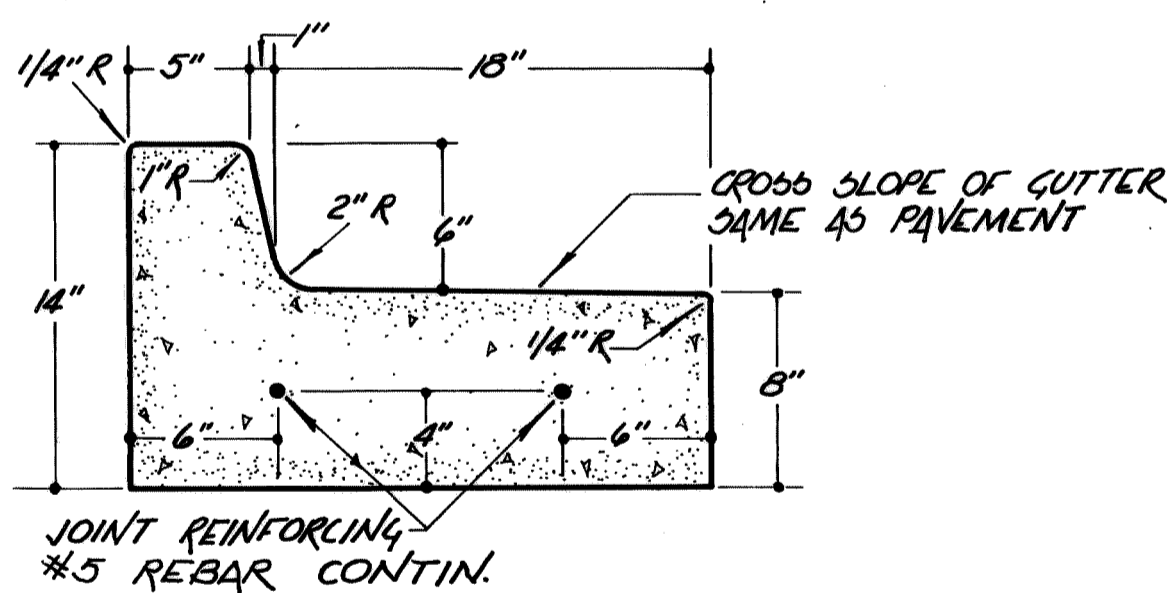

8 COMBINATION CONCRETE CURB & GUTTER DETAIL

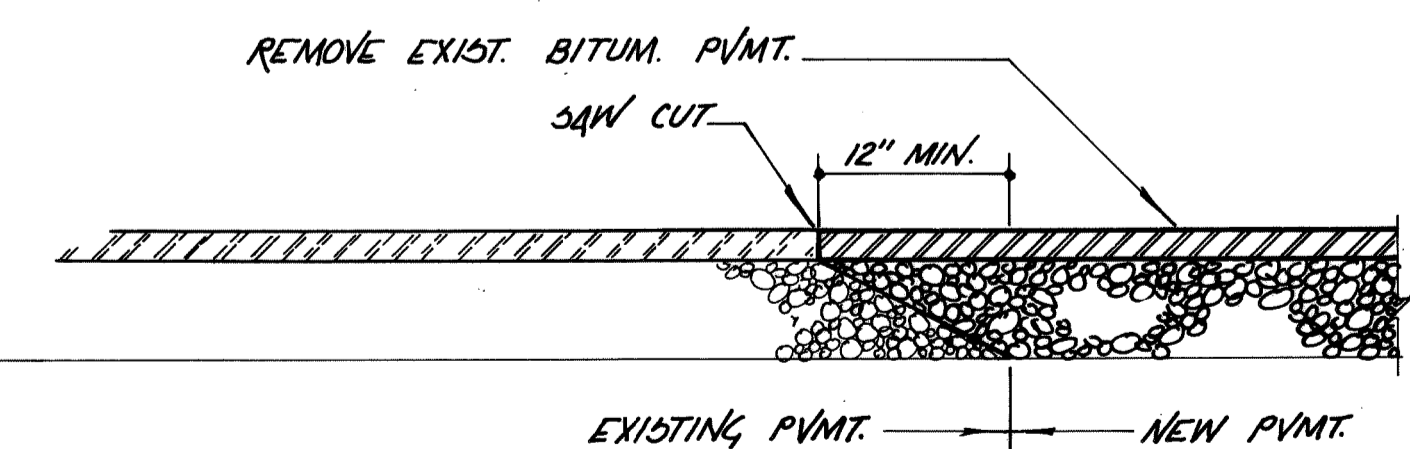


9 JUNCTION AT EXISTING PAVEMENT

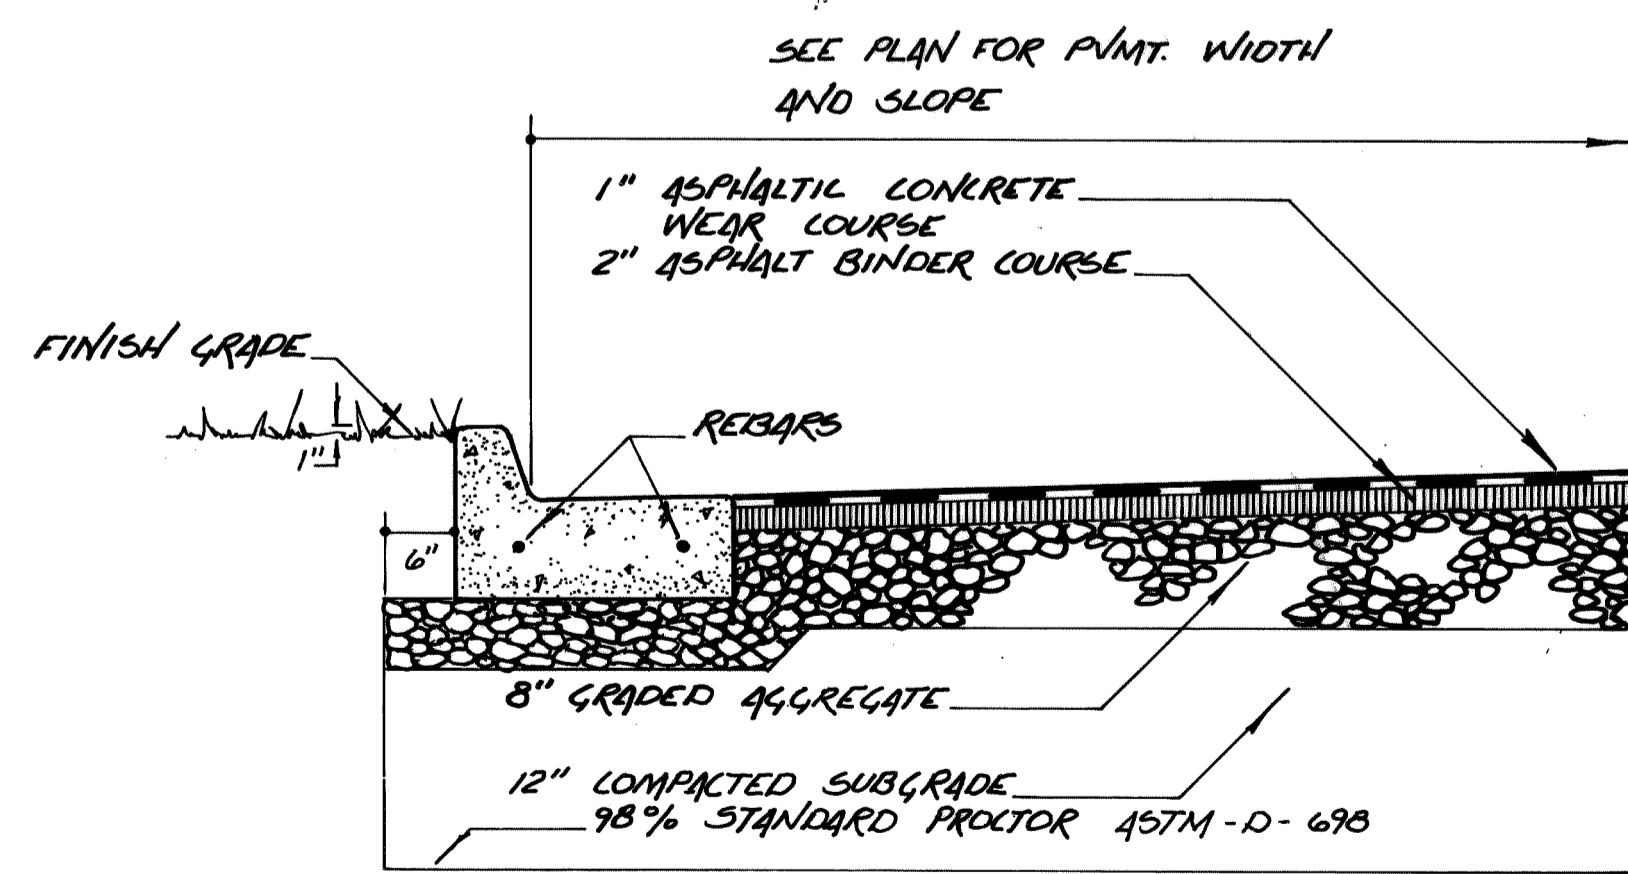

10 DETAIL - ASPHALT PAVEMENT

11 SERVICE AREA TRANSVERSE JOINTS

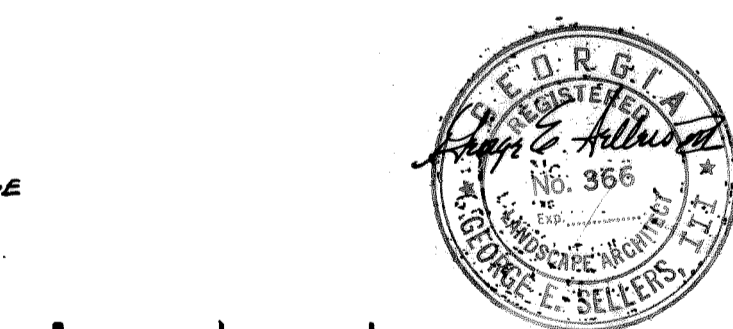

AS BUILT	7-29-83	THIS DRAWING REFLECTS A COMPILED OF MODIFICATIONS AND REVISIONS BY THE ARCHITECT TO THE ORIGINAL DRAWING.	
NO.	DATE	DESCRIPTION	
REVISIONS:			
SHEET TITLE			
SITE DETAILS			
BLDG. NO.	PROJECT TITLE	DATE	
9	120 BED NURSING HOME CARE UNIT	7-25-79	
DRAWN	CHECKED	DATE	
M.H. BLACK	G.E. SELLERS	7-25-79	
HEERY		DRAWING NO.	
Heery & Heery, Architects & Engineers, Inc. 880 West Peachtree Street, N.W., Atlanta, Georgia 30309		9-L7	
APPROVED: PROJECT DIRECTOR		DWG 7 OF 11	
VETERANS ADMINISTRATION		PROJECT NO.	
		508-011	
LOCATION			
VAH. - ATLANTA, GA.			

THREE INCHES EQUALS ONE FOOT ONE AND ONE HALF INCHES EQUALS ONE FOOT ONE INCH EQUALS ONE FOOT THREE QUARTER INCH EQUALS ONE FOOT ONE HALF INCH EQUALS ONE FOOT THREE EIGHTH INCH EQUALS ONE FOOT ONE QUARTER INCH EQUALS ONE FOOT ONE EIGHTH INCH EQUALS ONE FOOT