


NOTES:
 1. ALL SOIL AREAS DISTURBED BY CONSTRUCTION OPERATIONS SHALL BE GRASSED WITH PERMANENT LAWN GRASS. DO NOT GRASS AREAS THAT ARE TO RECEIVE PLANT MATERIALS.

LEGEND

FH	FIRE HYDRANT
SS	SANITARY SEWER
SPH	SPRINKLER HEAD
TBM	TEMPORARY BENCH MARK
CB	CATCH BASIN
TH	THROAT
TC	TOP OF CURB
BC	BOTTOM OF CURB
WV	WATER VALVE
WSP	WATER SPROCKET
W	WATER
G	GAS
TW	TOP WALK
BW	BOTTOM WALK
LS	LIGHT STANDARD
DI	DROP INLET
TB	TOP BANK
BB	BOTTOM BANK
WS	WATER SURFACE
DH	DRAIN HOLE
TS	TOP SLAB
CMP	CORRUGATED METAL PIPE
CBG	CURB & GUTTER
FF	FINISHED FLOOR
PP	POWER POLE
HW	HEADWALL
X	SPOT OF ELEVATION
EP	EDGE PAVEMENT
MH	MANHOLE
UT	UNDERGROUND TELEPHONE LINE
UP	UNDERGROUND POWER LINE

	ROOF LINE AND BUILDING FOOTPRINT
	CONCRETE PEDESTRIAN PAVEMENT
	CONCRETE CURB & GUTTER
	RIP RAP SEE DETAIL 9-W2
	ASPHALT PAVING
	CONCRETE VEHICULAR PAVING

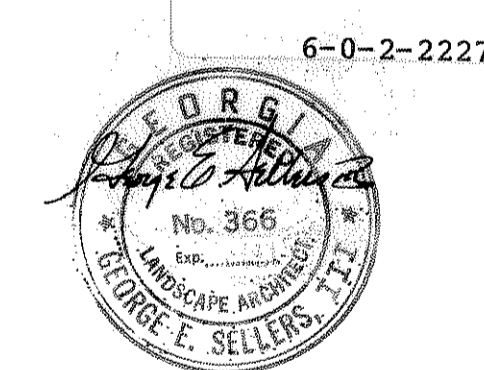

NOTES

A. THE UTILITIES SHOWN HERE ARE BASED ON AN AS BUILT DRAWING ENTITLED "UTILITY SITE PLAN, BLDG NO. 1 580 BED G.M.B. HOSPITAL & RO. MEDICAL CLINICS" DATED OCTOBER 1, 1966. DUE TO THE NATURE OF THE SITE THIS SURVEYOR RECOMMENDS TEST PITS TO DETERMINE EXACT LOCATION OF CRITICAL UTILITIES.

B. REFERENCE DRAWING IS UNCLEAR AS TO WHETHER TWO WATERMANS EXIST AT THIS LOCATION. TESTIMONY OF HOSPITAL EMPLOYEES CONFLICT AS TO THE NUMBER OF LINES FOUND IN PREVIOUS EXCAVATIONS.

C. IT IS IMPOSSIBLE TO DETERMINE THE EXACT RELATIONSHIP BETWEEN THE DOMESTIC, FIRE & SPRINKLER WATER SYSTEMS, USERS OF THIS MAP SO CAUTIONED.

D. UNDERGROUND UTILITIES SHOWN HEREON ARE TAKEN FROM AN AS BUILT DRAWING ENTITLED "ELECTRICAL SITE PLAN" DATED OCTOBER 1, 1966.

E. UNDERGROUND FUEL STORAGE TANKS THIS AREA, EXACT ARRANGEMENTS UNKNOWN.

G. ALL DIMENSIONS ARE TO BACK OF CURB & GUTTER.

AS BUILT 7-29-63		DATE: 1-25-79							
10-B-21 PARKING SPALL CHANGE		DRAWING NO. 9-L4							
8-21-61 REFINISHED CORRIDOR CONCRETE PAVEMENT (SEE SHEET 8-100-2)		PROJECT NO. 508-011							
<table border="1"> <tr><th colspan="2">REVISIONS:</th></tr> <tr><th>NO.</th><th>DESCRIPTION</th></tr> <tr><td>1</td><td>DATE</td></tr> </table>				REVISIONS:		NO.	DESCRIPTION	1	DATE
REVISIONS:									
NO.	DESCRIPTION								
1	DATE								
SHEET TITLE SITE STAKING PLAN									
BLDG. NO. 9 PROJECT TITLE 120 BED NURSING HOME CARE UNIT									
DRAWN R. L. MEADOW		CHECKED M. H. BLACK							
HEERY Heery & Heery, Architects & Engineers, Inc. 880 West Peachtree Street, N.W., Atlanta, Georgia 30309		DATE 1-25-79							
APPROVED: PROJECT DIRECTOR 									
VETERANS ADMINISTRATION VAH - ATLANTA, GA.									

