

REQUEST FOR INFORMATION (RFI)
VA-251-14-B-0054

PROJECT NUMBER:	553-303a	Please ensure that before submitting questions or requests for clarification that you thoroughly read the solicitation, specifications, drawings and other pertinent documents. When submitting questions on this project the Government requires contractors to specifically identify the specification and/or solicitation section(s) or drawing number(s) in reference to the question or request for clarification submitted. No question or request for clarification will be answered by the Government unless the above requirements are met. Failure to comply may prevent the Government from responding in a timely manner.	
PROJECT TITLE:	Expand Emergency Center		
PROJECT LOCATION:	Department of Veterans Affairs VA Medical Center 4646 John R. Street Detroit, MI 48201		
SUBMITTED BY:	DBC	City/State:	
PHONE NO.:			

TO:

Aleda E. Lutz VAMC
Department of Veterans Affairs
Attn: Contracting Office, 90CSC
1500 Weiss Street
Saginaw, MI 48602

RFI NO.:	DATE:	SPEC/DWG. REFERENCE:
	8/1/14	C-10Z
REPLY NEEDED BY:		

INFORMATION NEEDED:

~~QAR~~
PLEASE PROVIDE DETAILS /AS-BUILTS OF RETAINING WALL FOUNDATION WHICH IS INDICATED TO BE REMOVED. WE NEED TO KNOW SIZE.


REPLY:

See attached as-built drawings provided by the VA



Warren Brown

Digitally signed by Warren J. Brown
DN: c=US, cn=Warren J. Brown, o=VAMC Detroit,
ou=Facility Engineering
Date: 2014.08.07 10:30:47 -04'00'



REPLY FROM:	Mark Adams, PE, C2AE	DATE:	August 6, 2014
ATTACHMENTS:		COPY TO:	

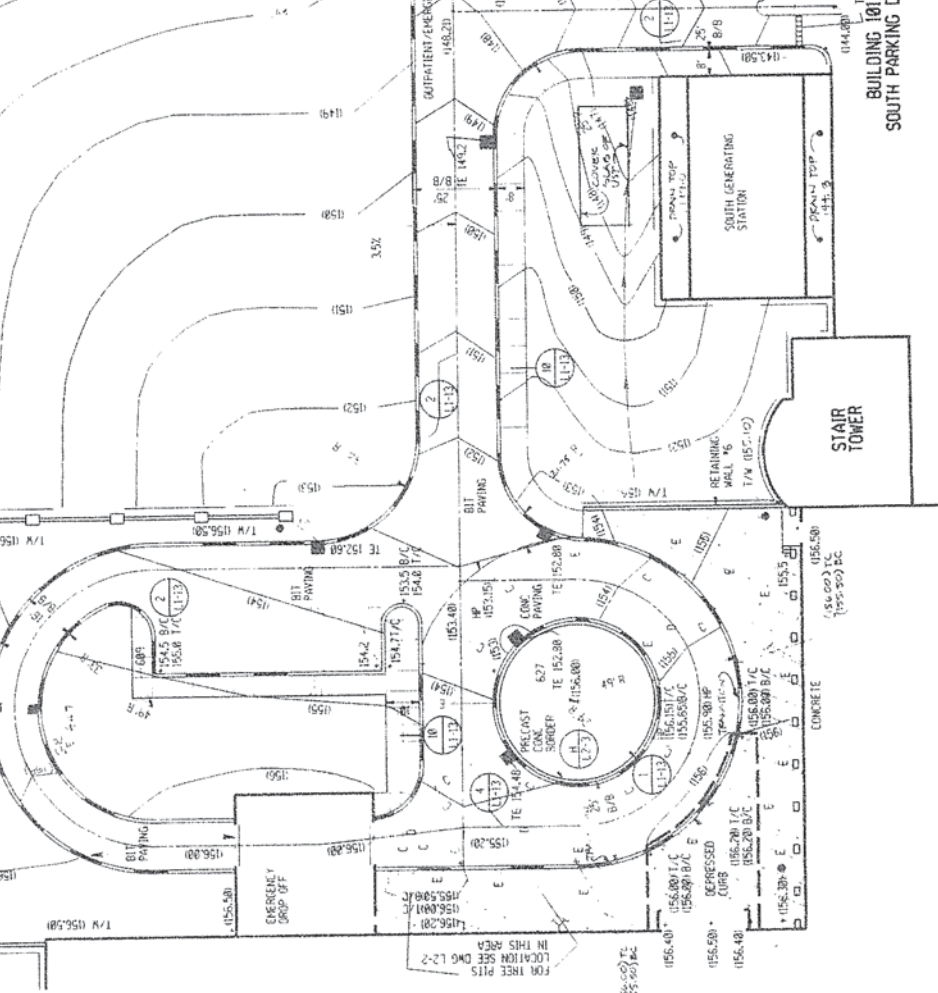


OUT PATIENT/EMERGENCY ENTRANCE


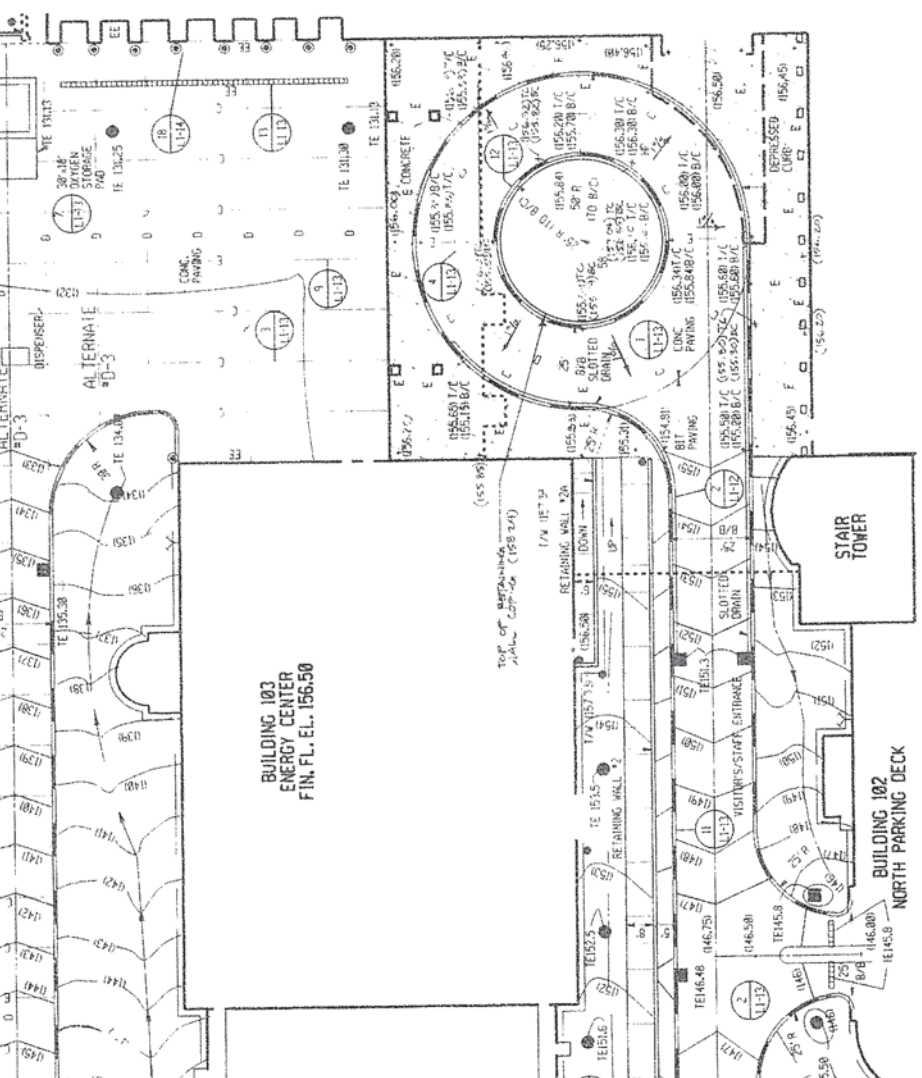
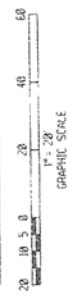


VISITOR/STAFF ENTRANCE

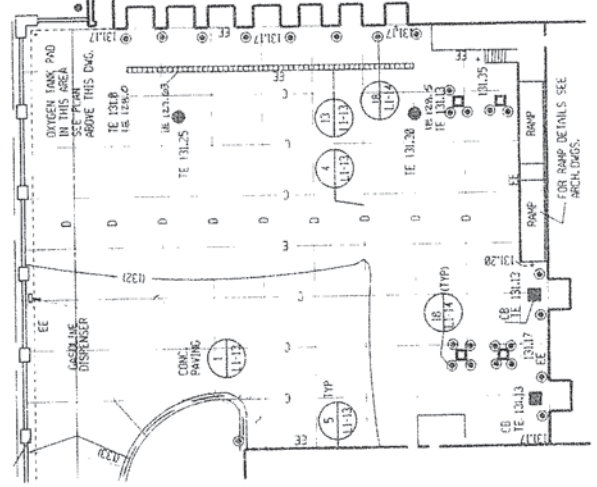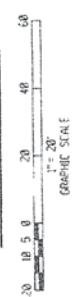

LOADING AREA

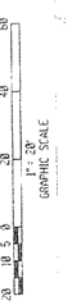

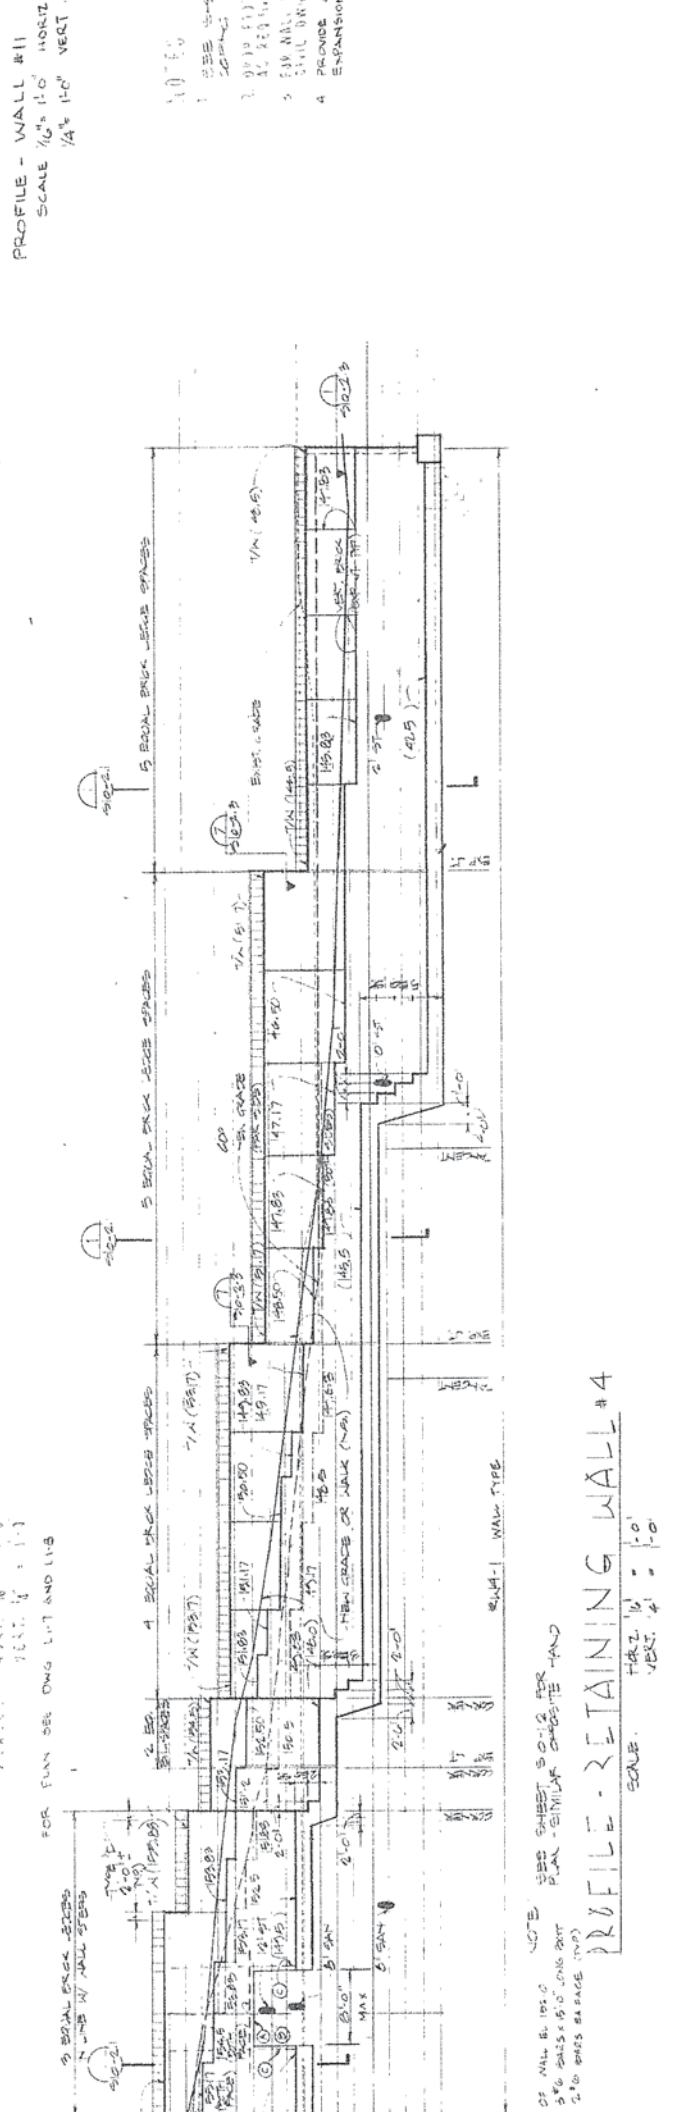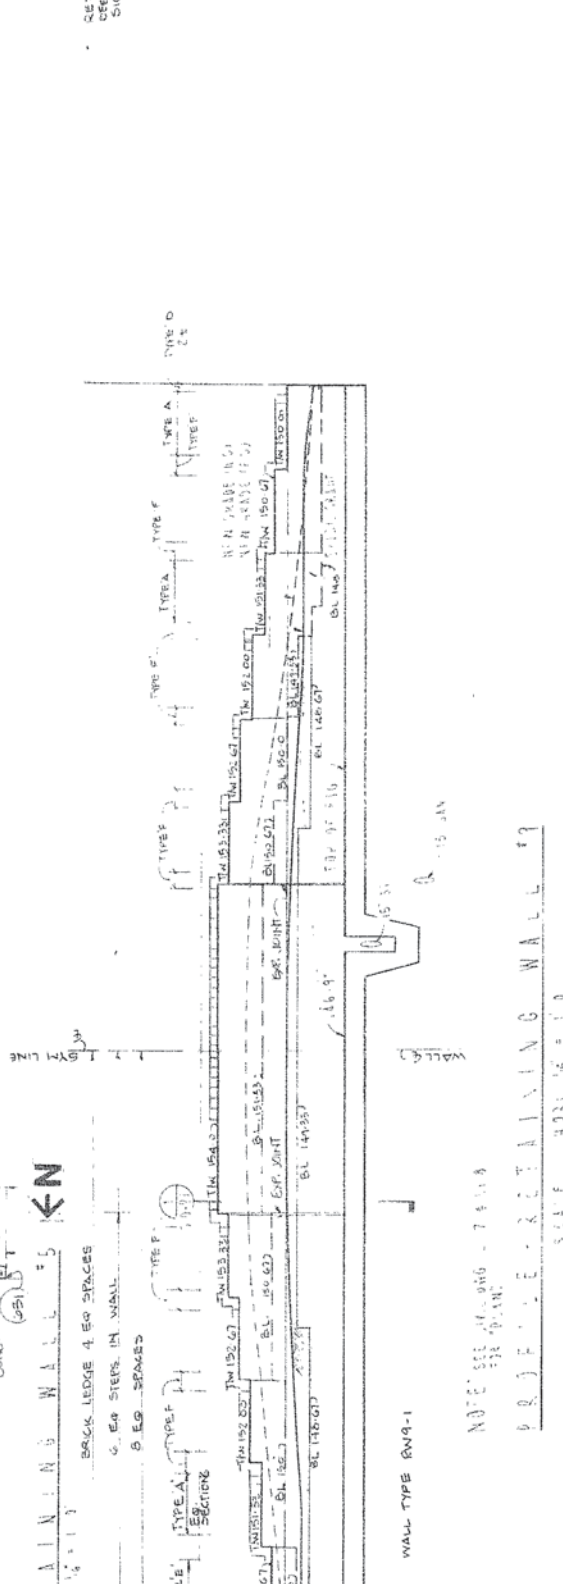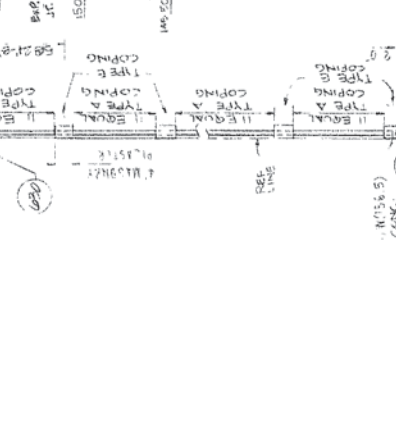

Page 18 of 18

