


three inches = one foot
one and one half inches = one foot
one inch = one foot
three quarters inch = one foot
one half inch = one foot
three eighths inch = one foot
one quarter inch = one foot
one eighth inch = one foot

ASBUILT SURVEY

VAMC FRESNO
2615 E. CLINTON AVENUE
FRESNO, CA 93703

SHEET 1 OF 1

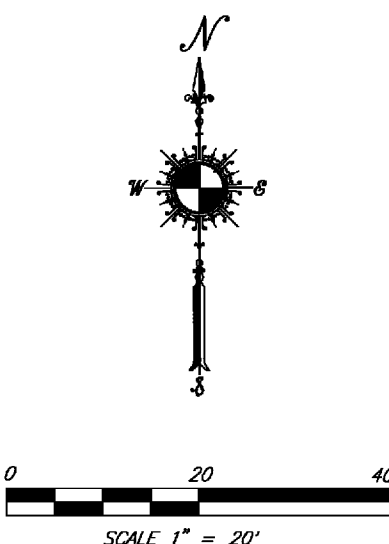

LEGEND (existing features):

	ASPHALT CONCRETE (AC)
	CONCRETE (CONC)
	GRAVEL
	STRUCTURES(BLDG) w/OVERHANG
	FUTURE PROPOSED STRUCTURE
	SPOT ELEVATION & DESCRIPTION
	SURVEY CONTROL POINT
	SURVEY BENCH MARK
	NAIL AND TIN SURVEY POINT
	ELECTRICAL (E)
	TELEPHONE OR COMMUNICATIONS (TEL)
	UTILITY PULL BOX (PB)
	HIGH MAST LIGHT POLE
	FENCE LIGHT
	UTILITY POLE (UP)
	CITY ANCHOR (CITY)
	APPROXIMATED UNDERGROUND UTILITY LINE(S)
	OVERHEAD UTILITY LINE(S)
	WATER LINE (6")
	IRRIGATION LINE (15")
	EXISTING FENCE
	EXISTING GROUND FLOW LINE
	FIRE DEPARTMENT CONNECTION (FDC)
	WATER METER (WM)
	WATER VALVE (WV)
	FIRE HYDRANT (FH)
	GAS METER (GM)
	GAS VALVE (GV)
	SANITARY SEWER MANHOLE (SSMH)
	SANITARY SEWER CLEANOUT (SSCO)
	GUARD POST (GP)
	STORM DRAIN MANHOLE (SDMH)
	DRAIN INLET (DI)
	STORM DRAIN LINE (SD)
	TREE
	ANGLE POINT (AP)
	BACK OF WALK (BW)
	CROWN CORNER (COR)
	EXISTING GROUND OR TURF (EG)
	EDGE OF PAVEMENT (EP)
	EDGE OF TRAVELWAY (ETW)
	FLOWING (FL)
	FINISH FLOOR (FF)
	FINES (FNC)
	GRADE BREAK (GB)
	MOWSTRIP (MS)
	STORM DRAINAGE PIPE (SD)
	SIDE WALK (SW)
	TOP BACK OF CURB (TBC)
	TOP FACE OF CURB (TFC)
	TOP OF WALL (TW)
	MONTEREY COUNTY RECORD (M.C.R.)
	FOUND (FD)
	CALCULATED POSITION (CALC.)
	NOT TO SCALE (NTS)


(C) CITY OF FRESNO
SEWER MANHOLE
CONTACT CITY OF FRESNO
BEFORE COMMENCING
ANY WORK. (SEE NOTE
#4 BELOW)

VERTICAL CONTROL

FOUND CHISELED X IN SIDEWALK NORTHEAST CORNER OF FRESNO AND CLINTON AVENUE
ELEV. = 305.08'

BASIS OF BEARINGS:

LOCAL AND ASSUMED DATUM

 CENTRAL VALLEY ENGINEERING AND SURVEYING 2132 HIGH STREET SELMA, CA 93662 WWW.CV&S.COM Tel: (559) 891-8811 Fax: (559) 891-8815 Email: info@cv&s.com	DATE OF SURVEY	05/01/2014
	JOB NO.	12053
	DRAWING NAME	ASBUILT SURVEY
	DRAWN BY:	N.SAIGUA/C.MOJA
	DATE:	05/06/14
	REVISION DATE:	
	SHEET NO.	1 OF 1

NOT TO SCALE
FOR REFERENCE ONLY

CONSULTANTS:		ARCHITECT/ENGINEERS:		Drawing Title TOPOGRAPHIC SURVEY REFERENCE	Project Title Mental Health Psychosocial Rehab Recovery and Health Care for Homeless Veteran Center	Project Number 570-217	Office of Construction and Facilities Management: Department of Veterans Affairs
				Approved: Project Director	Location 2615 E. CLINTON AVE, FRESNO, CA 93703	Building Number 37	
				Date 08/11/2014	Checked RFA	Drawn JSD	
						Drawing Number VF101	
						Dwg. 6 of 197	