


OVERALL FLOOR PLANS

TO HELP WITH AREA

LOCATIONS OF SMALLER
PLANS

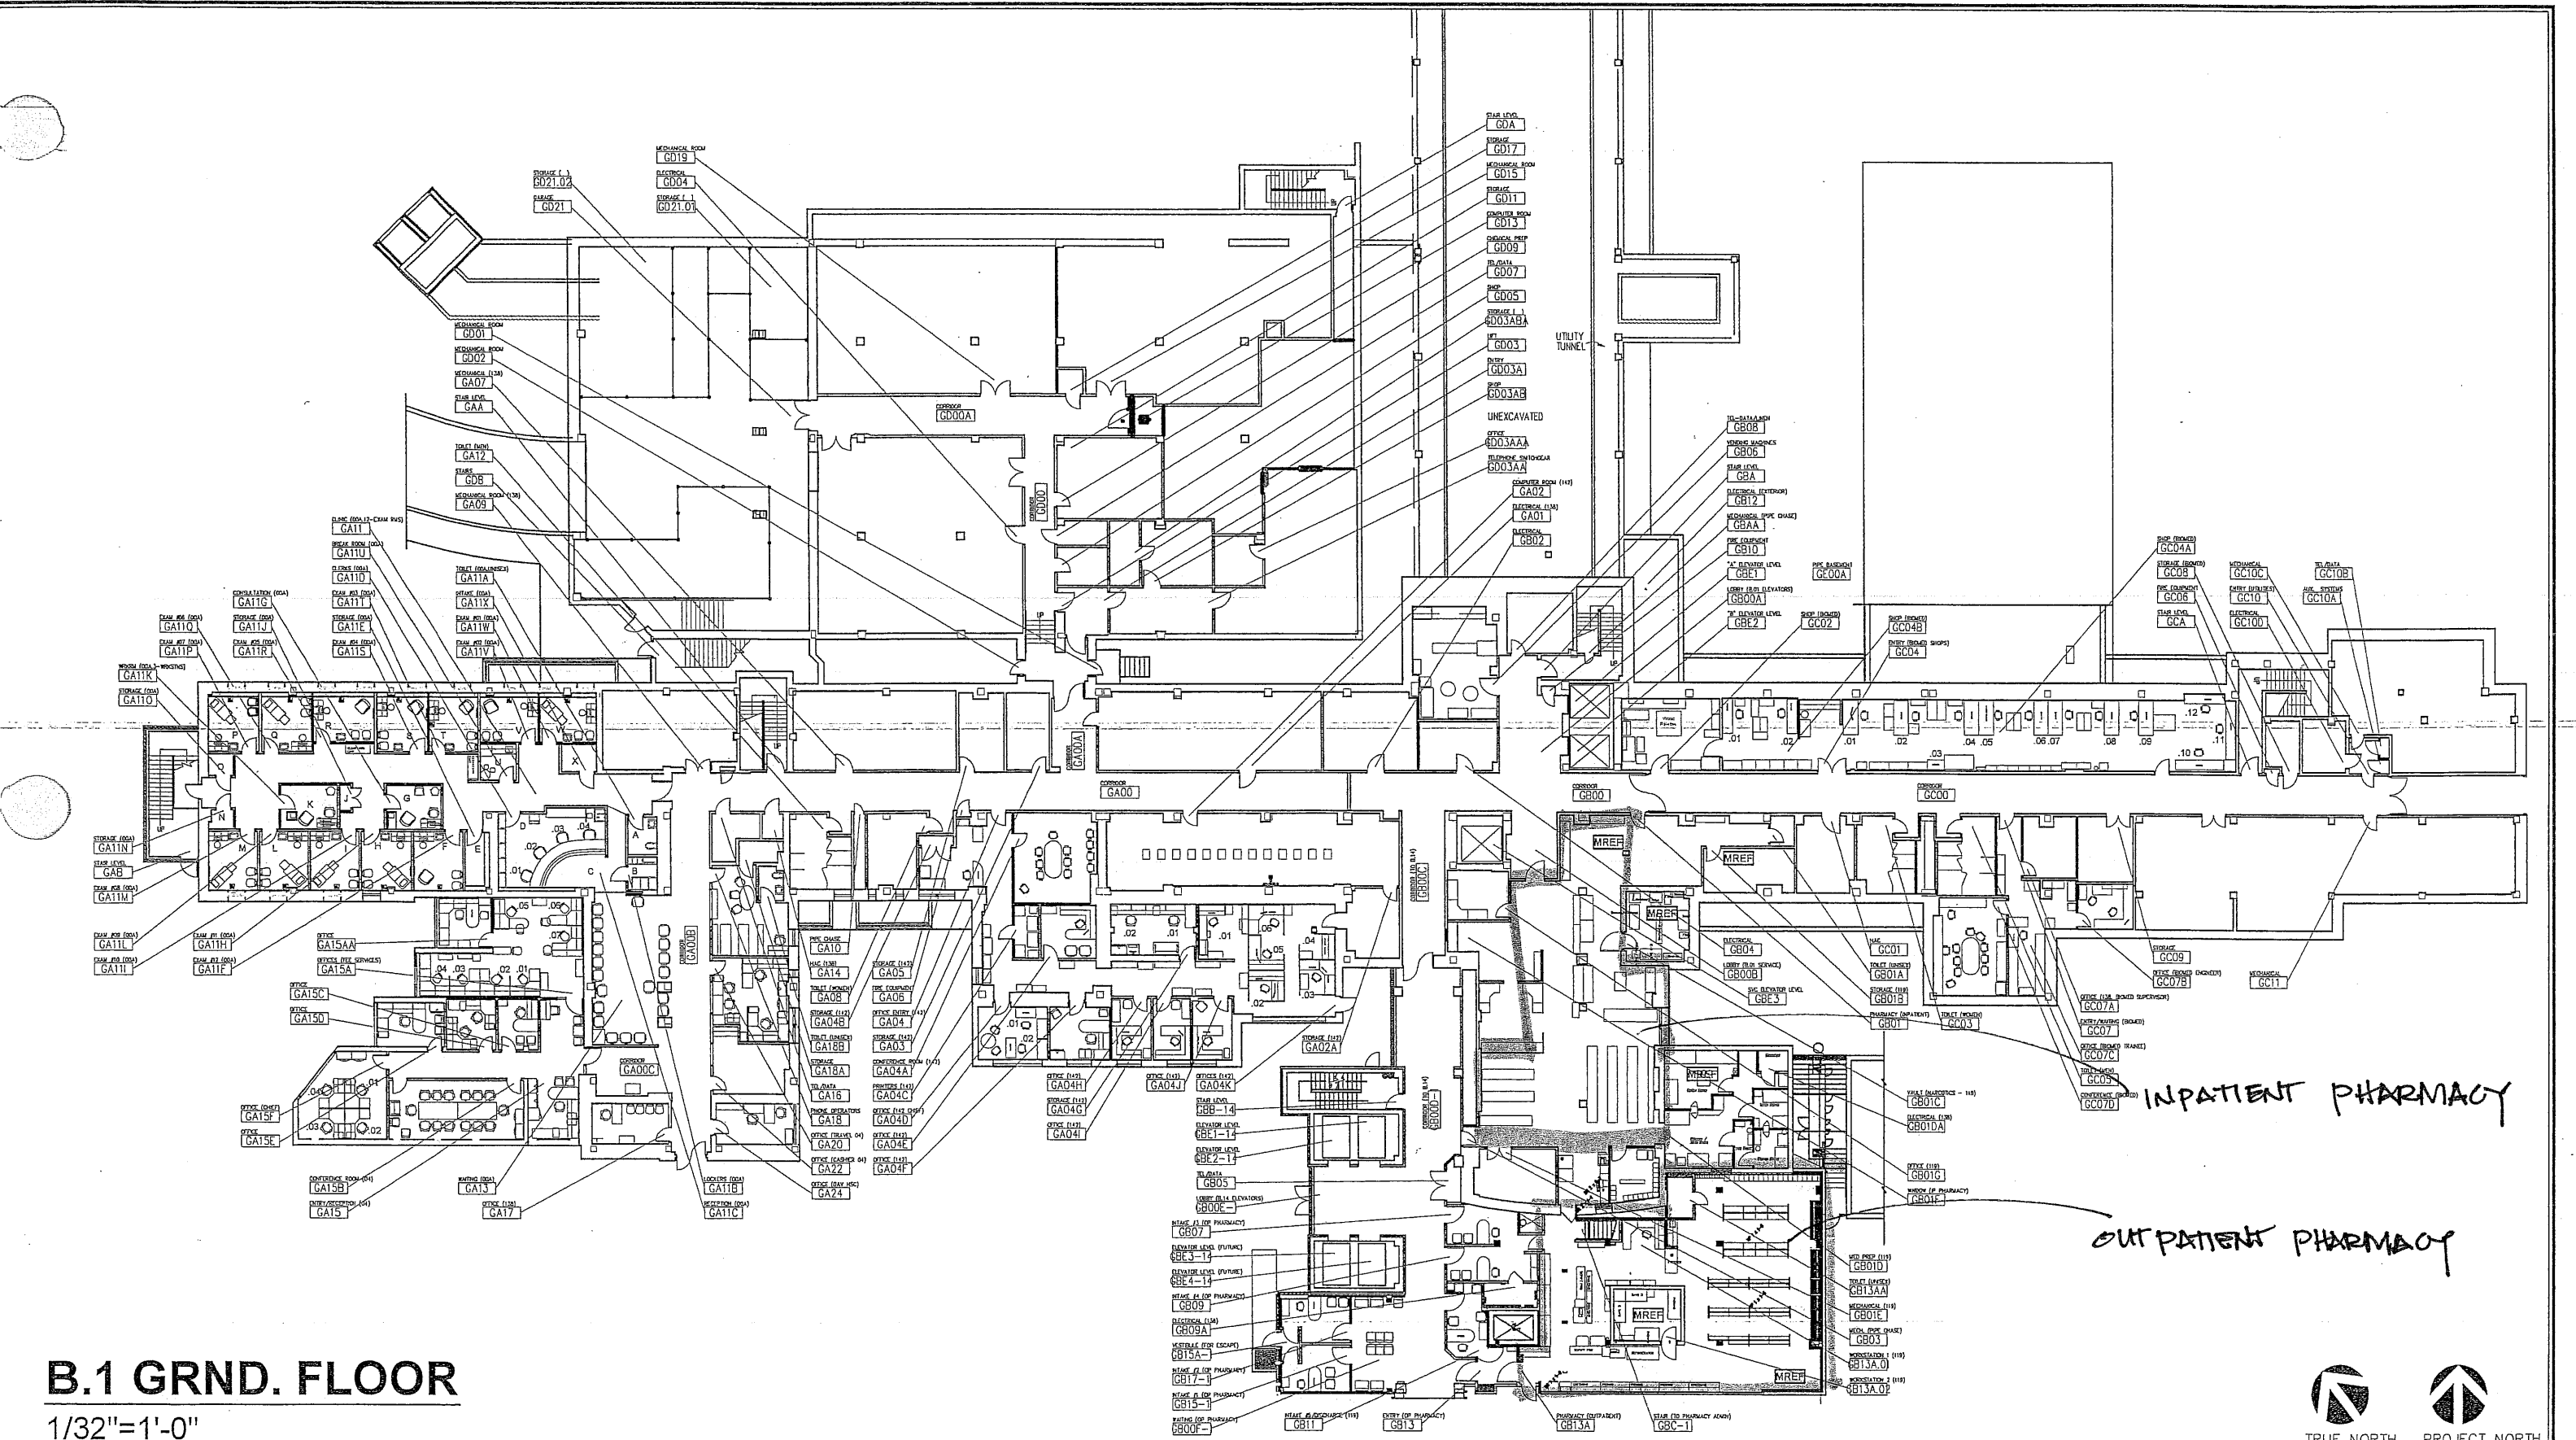


B.1 GRND. FLOOR

1/32"=1'-0"


INPATIENT PHARMACY

OUTPATIENT PHARMACY

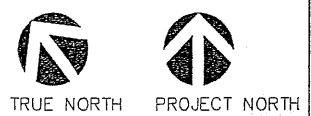

CAD Information CAD/B.9/ARCH/B.-A-1.DWG		Drawing Title B.1 GROUND FLOOR PLAN		Project Title ARCHITECTUAL ASBUILTS		Date 01/13
Approved:		Approved: Medical Center Director		Drawn C RYAN	Building Number B. 1	Project No.
Approved:		Approved: Chief, Engineering		Checked	Location VAMC SIO ITAH	DRAWING No. A-1

Department of Veterans Affairs

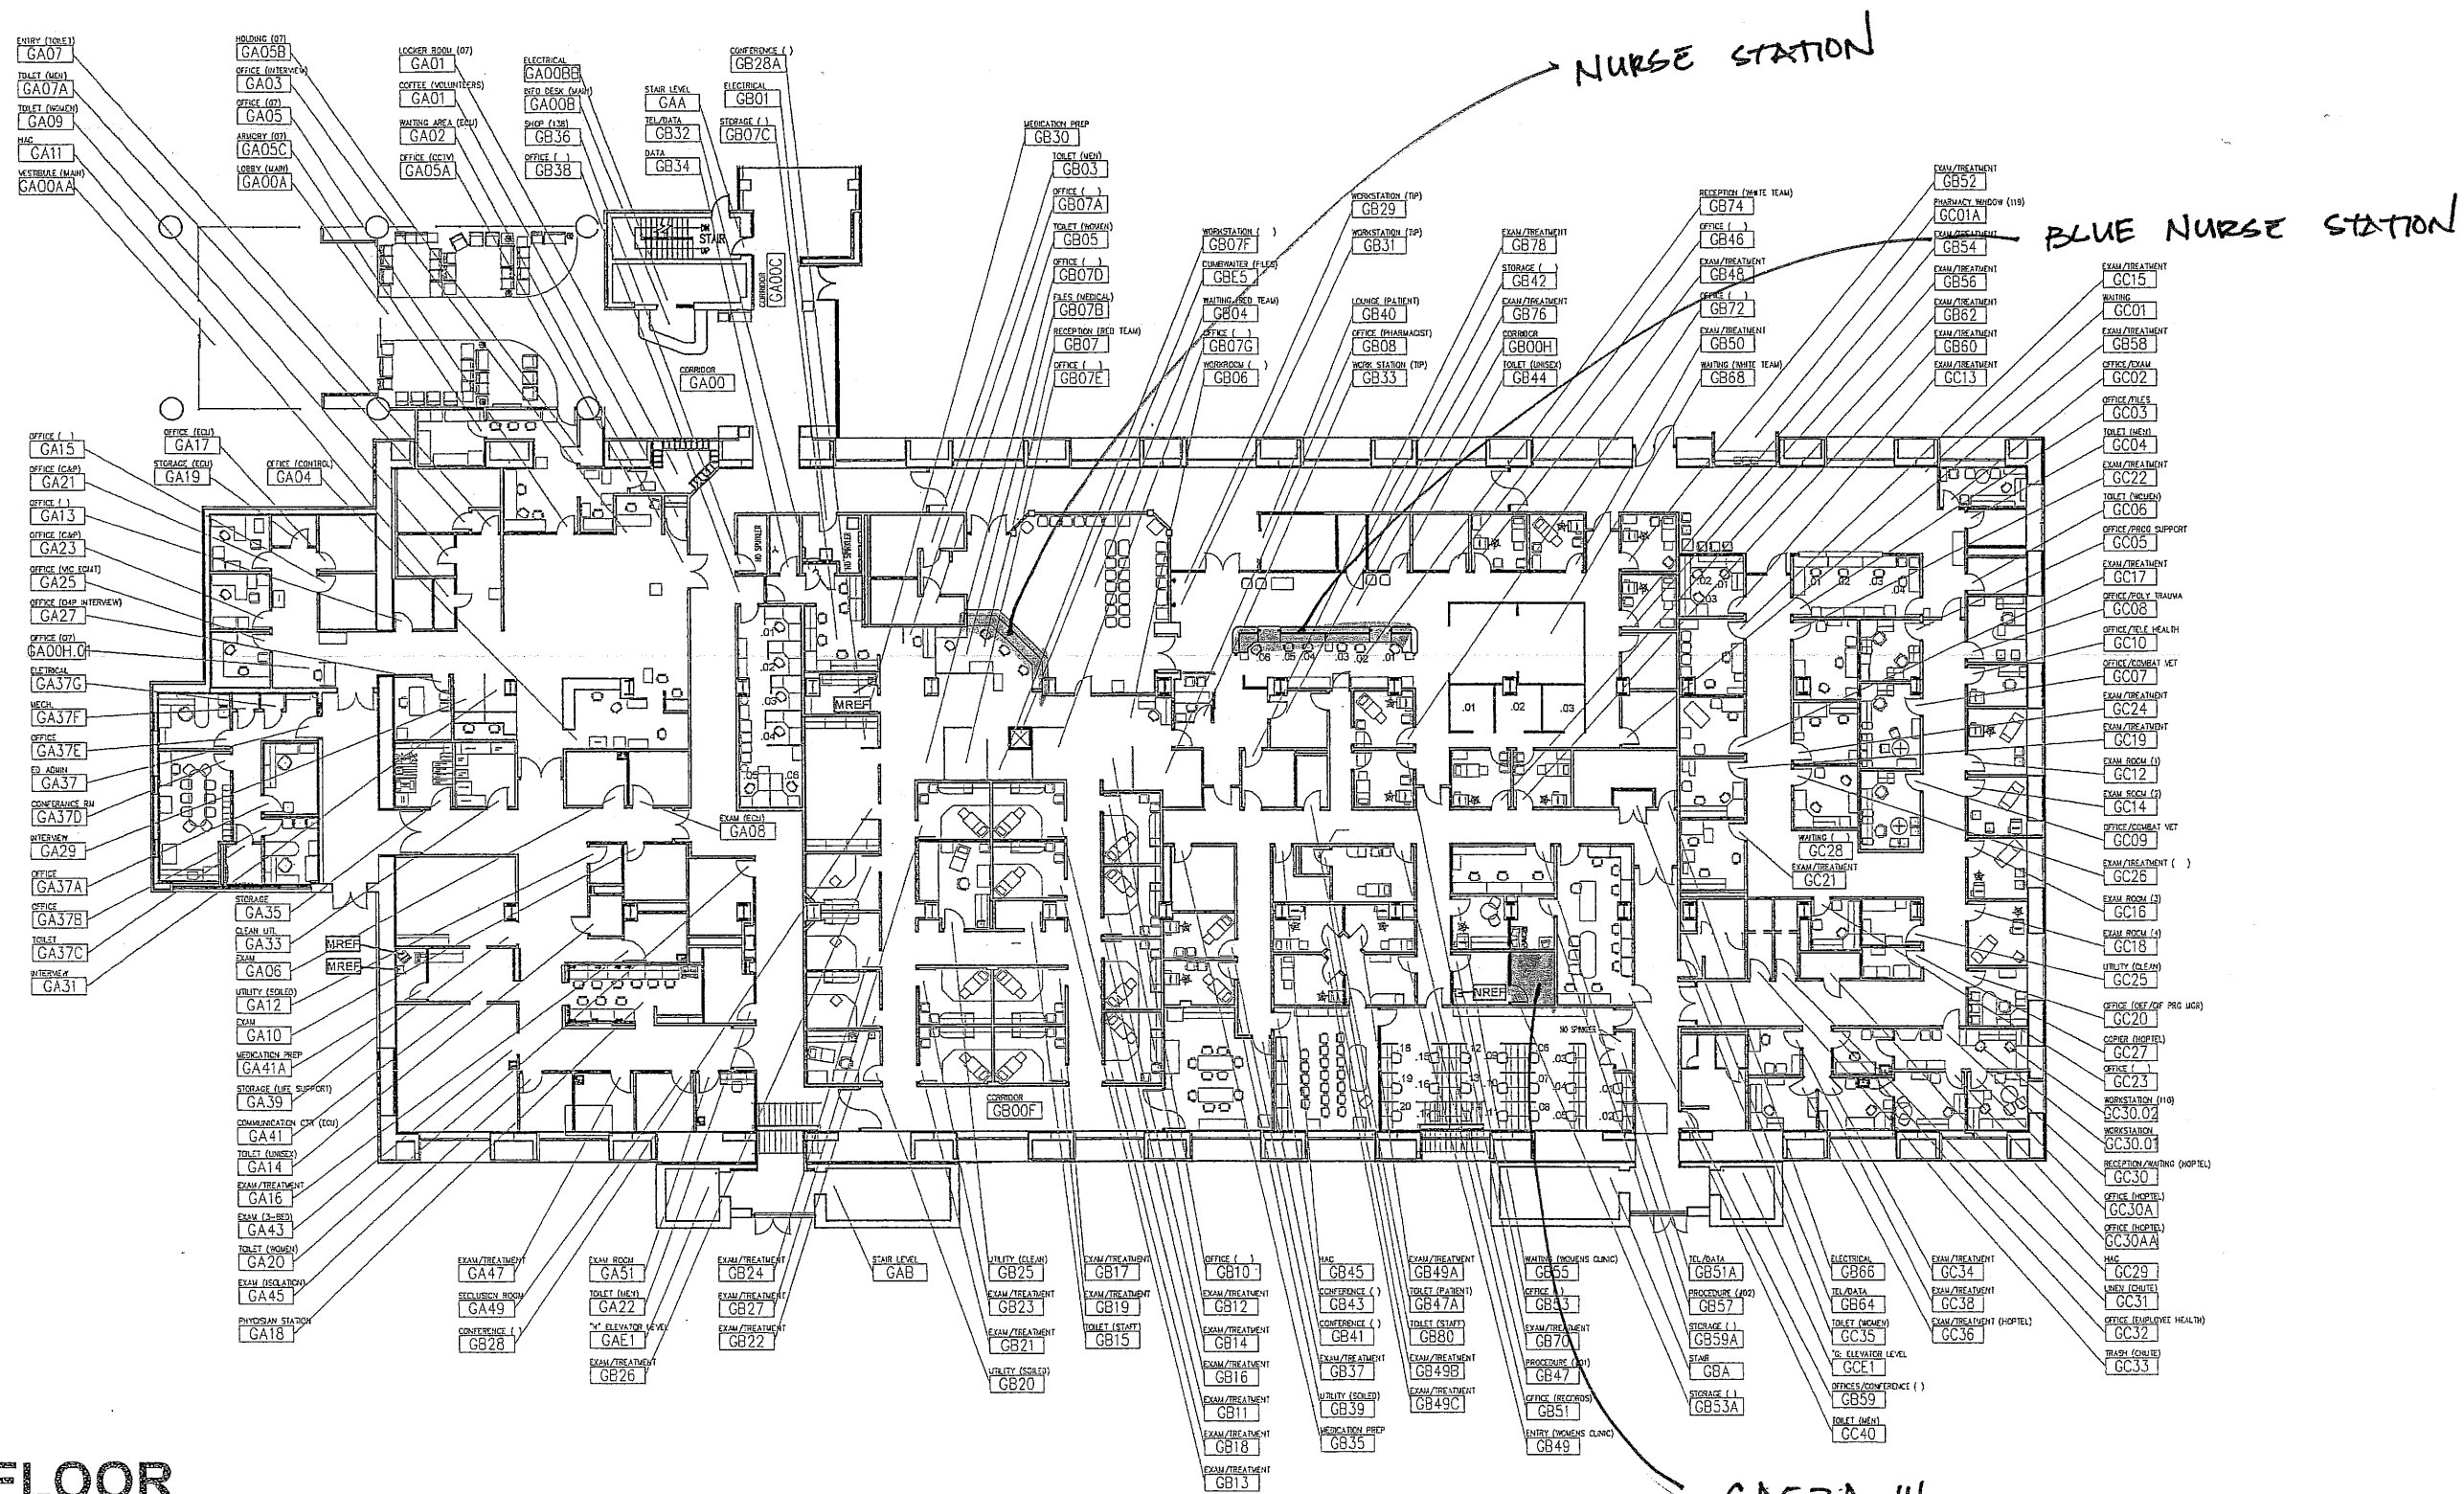

B.14 GRND FLOOR

1/32"=1'-0"

<div> <div>Re</div> <div>Date</div> </div>		<div> <div>CADD Information</div> <div>CAD/B.14/ARCHB.14-A-G.DWG</div> </div>	<div> <div>Drawing Title</div> <div>B.14 GRND FLOOR PLAN</div> </div>	<div> <div>Project Title</div> <div>ARCHITECTURAL ASBUILTS</div> </div>	<div> <div>Date</div> <div>11/07/06</div> <div>Project No.</div> <div></div> <div>DRAWING No.</div> <div>A-2</div> <div>Drw 2 of 6</div> </div>



B.1 FIRST. FLOOR

1/32"=1'-0"

RADIOLOGY

CT
WAITING

660-CSI-104
MRI Expansion
3500 GSF

PCS


660-CSI-102
Rehab & Prosthetics
Expansion
15000 GSF

PM & R
TEAM
→
EXAM

PROSTHETICS

Drawing Title: B.1 FIRST FLOOR PLAN		Project Title: ARCHITECTURAL ASBUILTS		Date: 07/13
Approved: Medical Center Director		Drawn: C RYAN	Building Number: B. 1	Project No.:
Approved: Chief, Engineering		Checked: ENGINEERING	Location: VAMC, SLC, UTAH.	DRAWING No. A-2
				Dwg. 2 of 8

Department of
Veterans Affairs

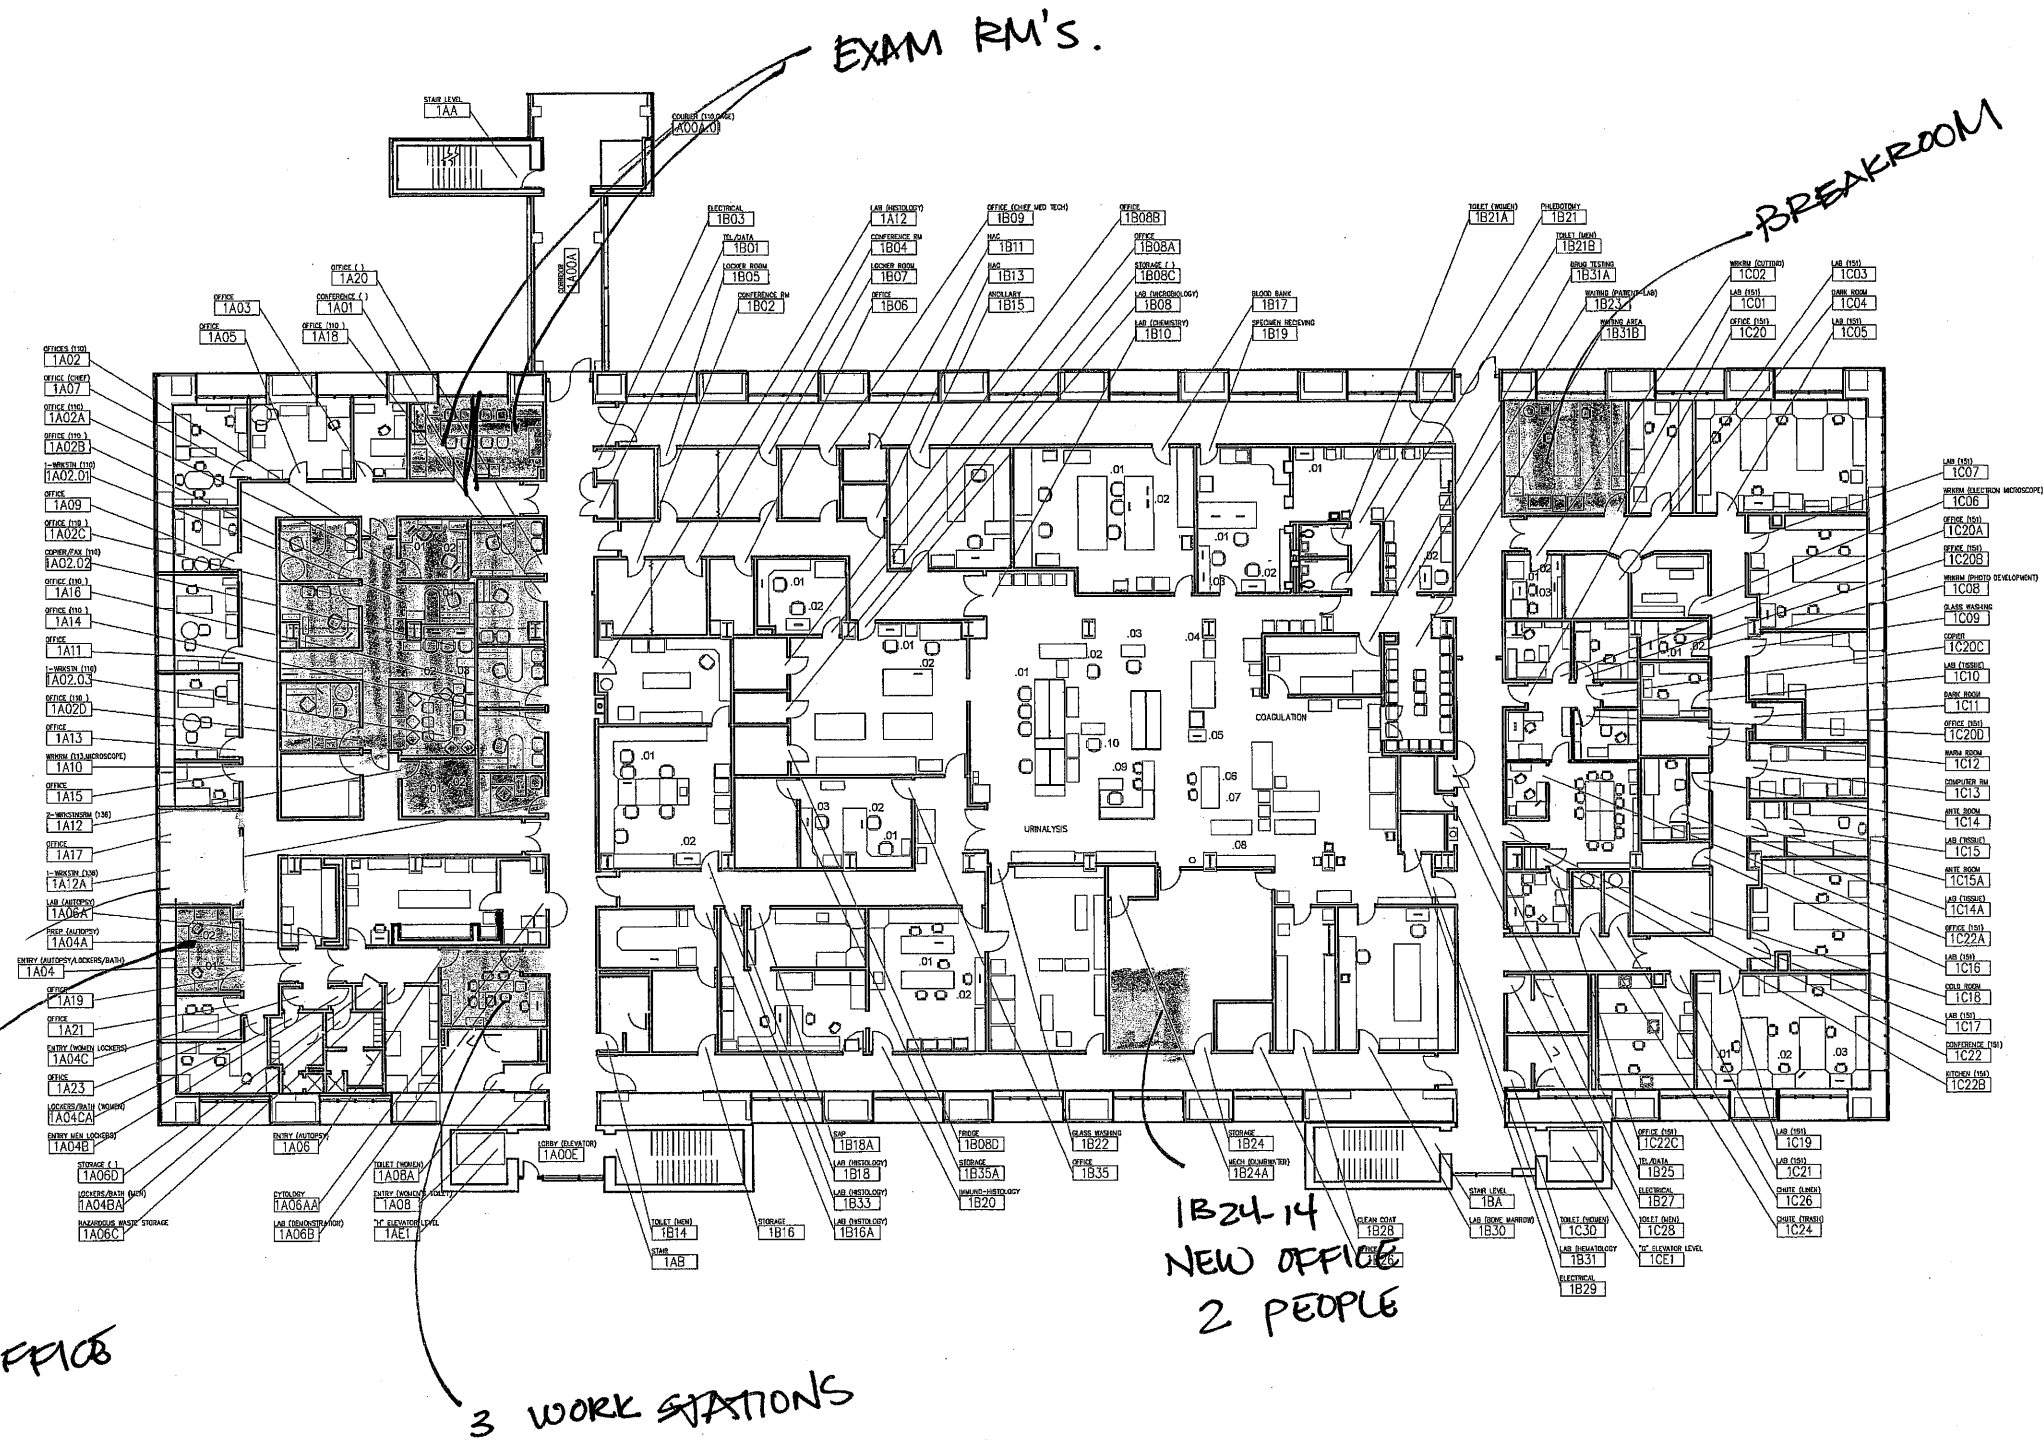


B.14 1st FLOOR

1/32"=1'-0"



<div> <div> <div></div> <div></div> </div> <div> <div></div> <div></div> </div> </div>	<div> <div></div> <div></div> </div>	<div> <div> <div>CADD Information</div> <div>CAD/B.14/ARCH/B.14-A-1.DWG</div> </div> <div> <div>Approved</div> <div></div> </div> <div> <div>Approved</div> <div></div> </div> </div>	<div> <div> <div>Drawing Title</div> <div>B.14 FIRST FLOOR PLAN</div> </div> <div> <div>Approved Medical Center Director</div> <div></div> </div> <div> <div>Approved Chief, Engineering</div> <div></div> </div> </div>	<div> <div> <div>Project Title</div> <div>ARCHITECTURAL ASBUILTS</div> </div> <div> <div>Building Number</div> <div>B. 14</div> </div> <div> <div>Location</div> <div>VAMC, SLC. UTAH.</div> </div> </div>	<div> <div> <div>Date</div> <div>01/13</div> </div> <div> <div>Project No.</div> <div></div> </div> <div> <div>Drawing No.</div> <div>A-3</div> </div> <div> <div>Sheet 3 of 6</div> <div></div> </div> </div>
--	--------------------------------------	---	--	--	--

Department of Veterans Affairs

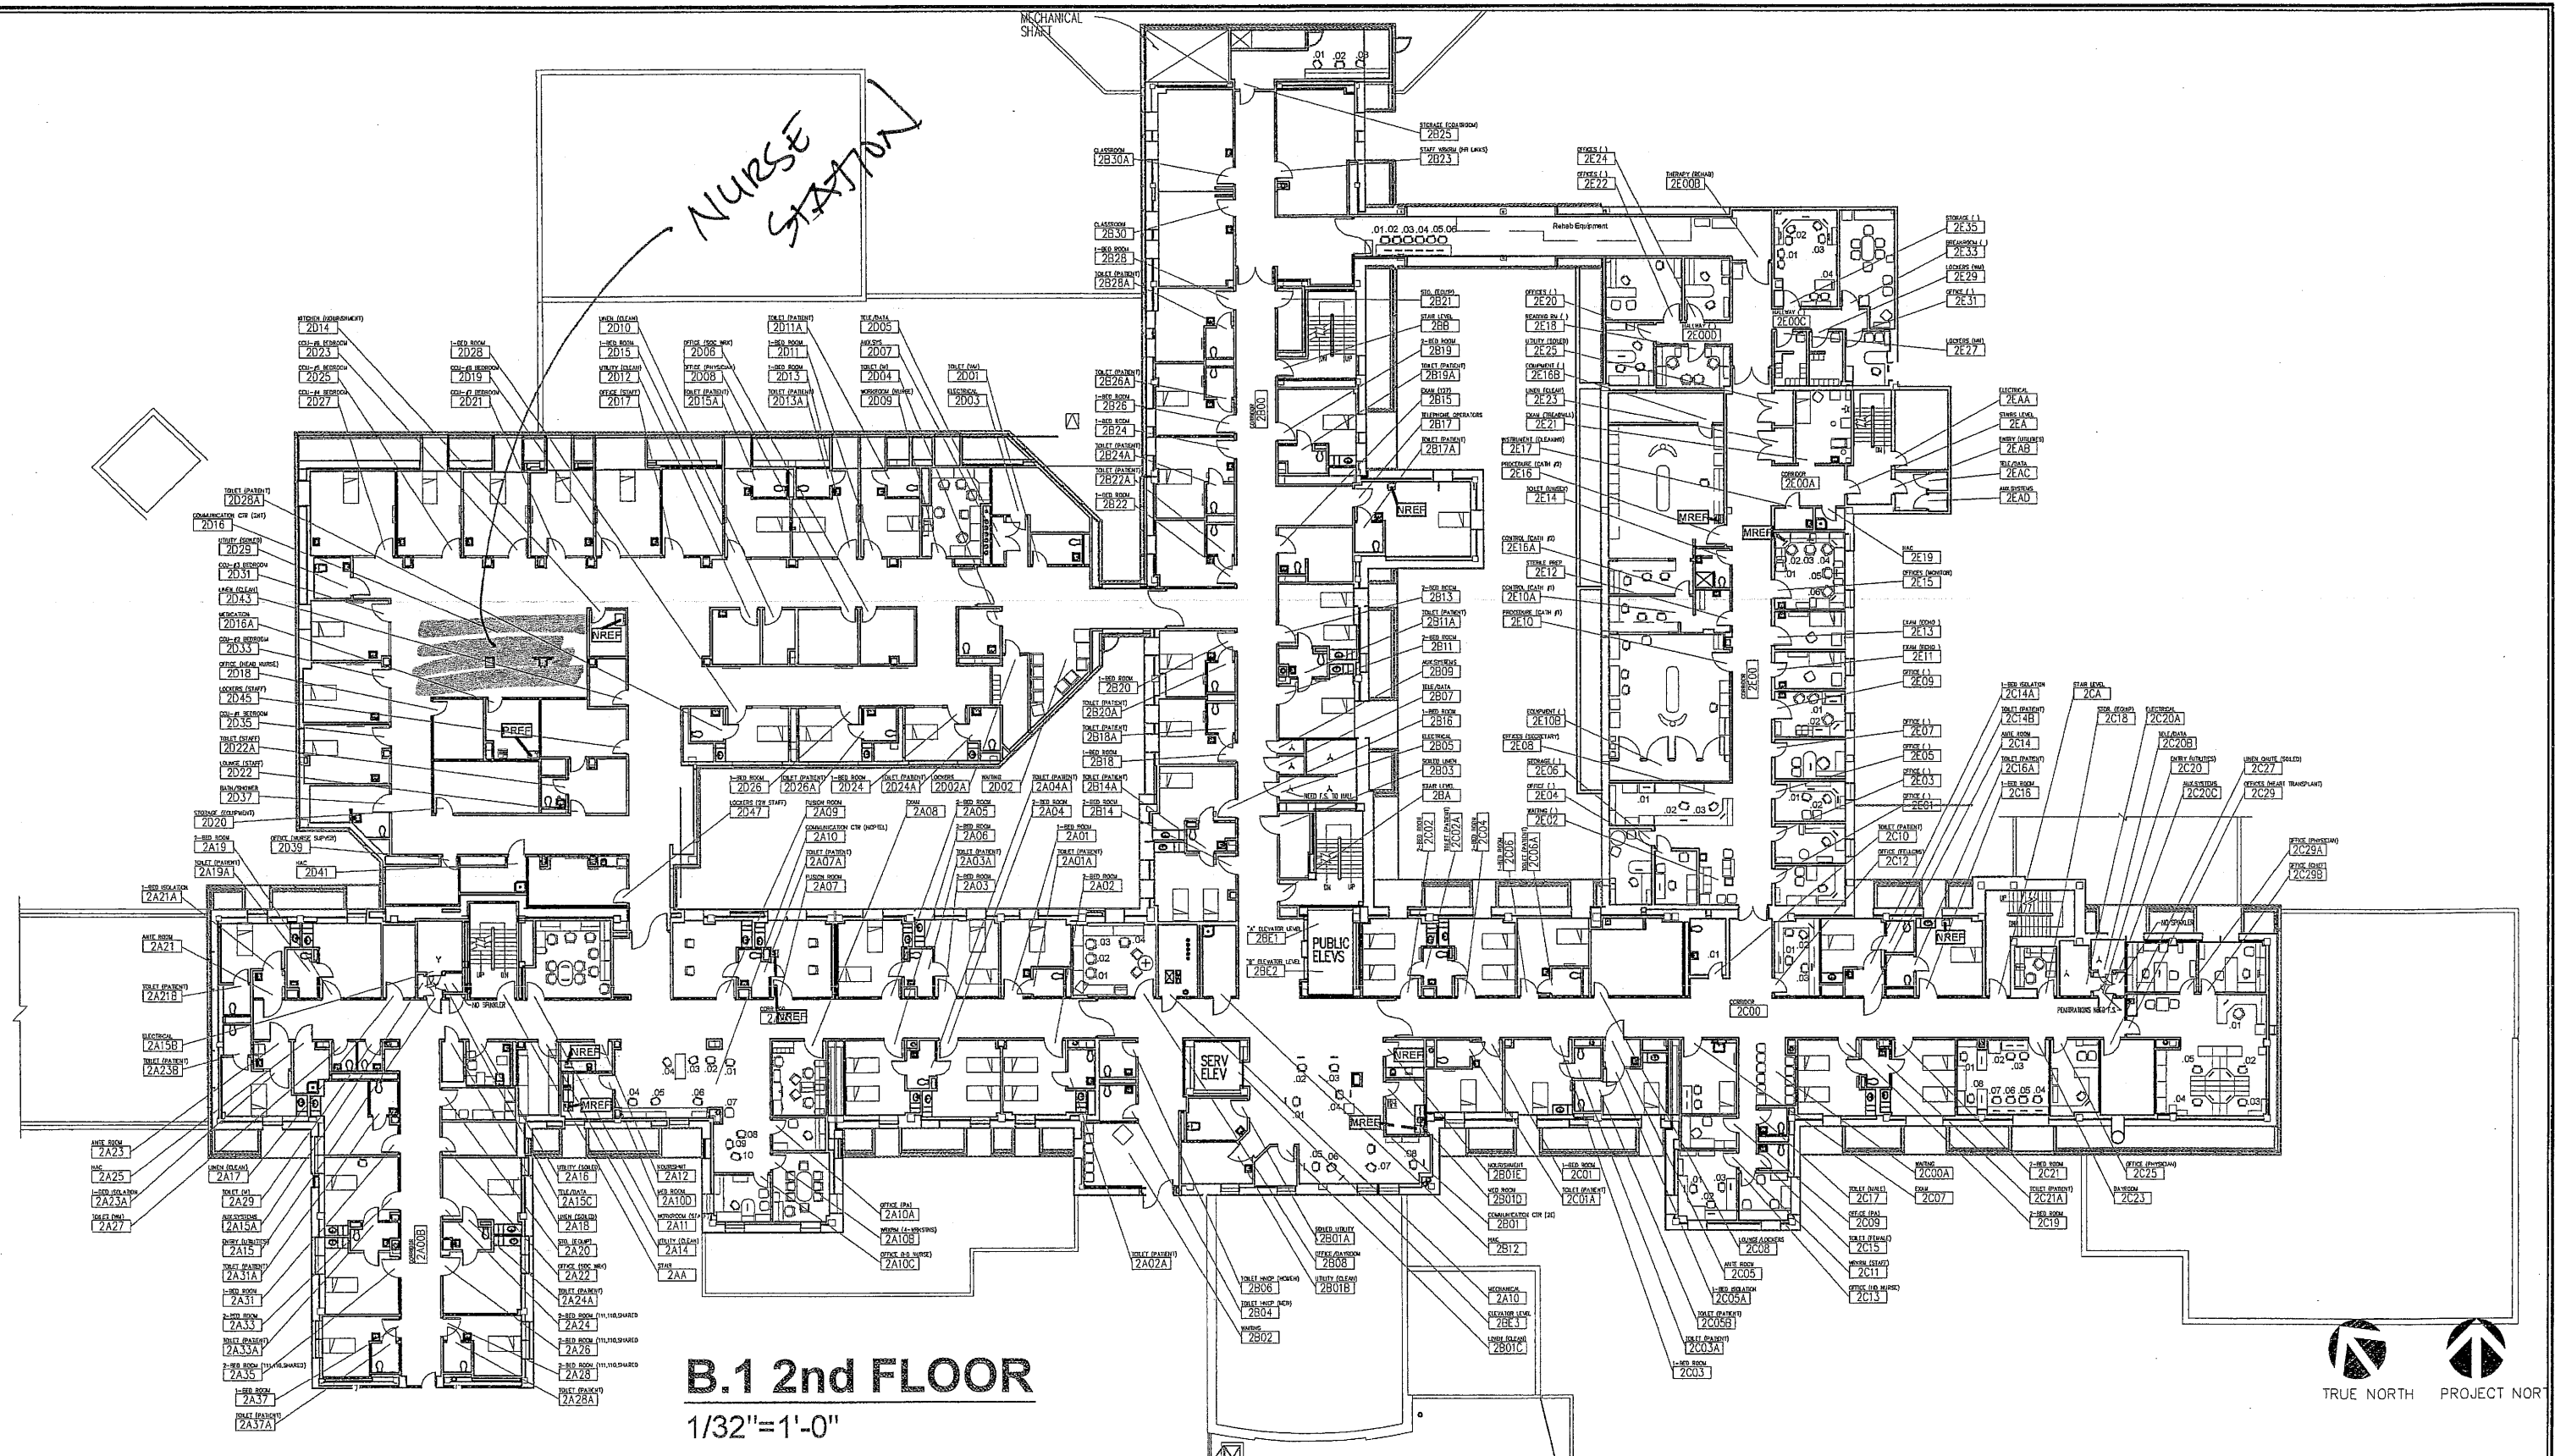


B.1 2nd FLOOR

$$1/32'' = 1' - 0''$$

TRUE NORTH PROJECT NORTH


CADD Information CAD/FY06/B1/ARCH/B1-A-2		Drawing Title <div style="text-align: center;">B.1 SECOND FLOOR PLAN</div>		Project Title <div style="text-align: center;">ARCHITECTURAL ASBUILTS</div>		Date <div style="text-align: center;">02/13</div>
Approved:		Approved: Medical Center Director		Draw <div style="text-align: center;">C RYAN</div>		Project No.
Approved:		Approved: Chief, Engineering		Building Number <div style="text-align: center;">B. 1</div>		DRAWING No. <div style="text-align: center;">A-3</div>
				Location <div style="text-align: center;">VAMC, SLC. UTAH.</div>		Dwg. 3 of 8

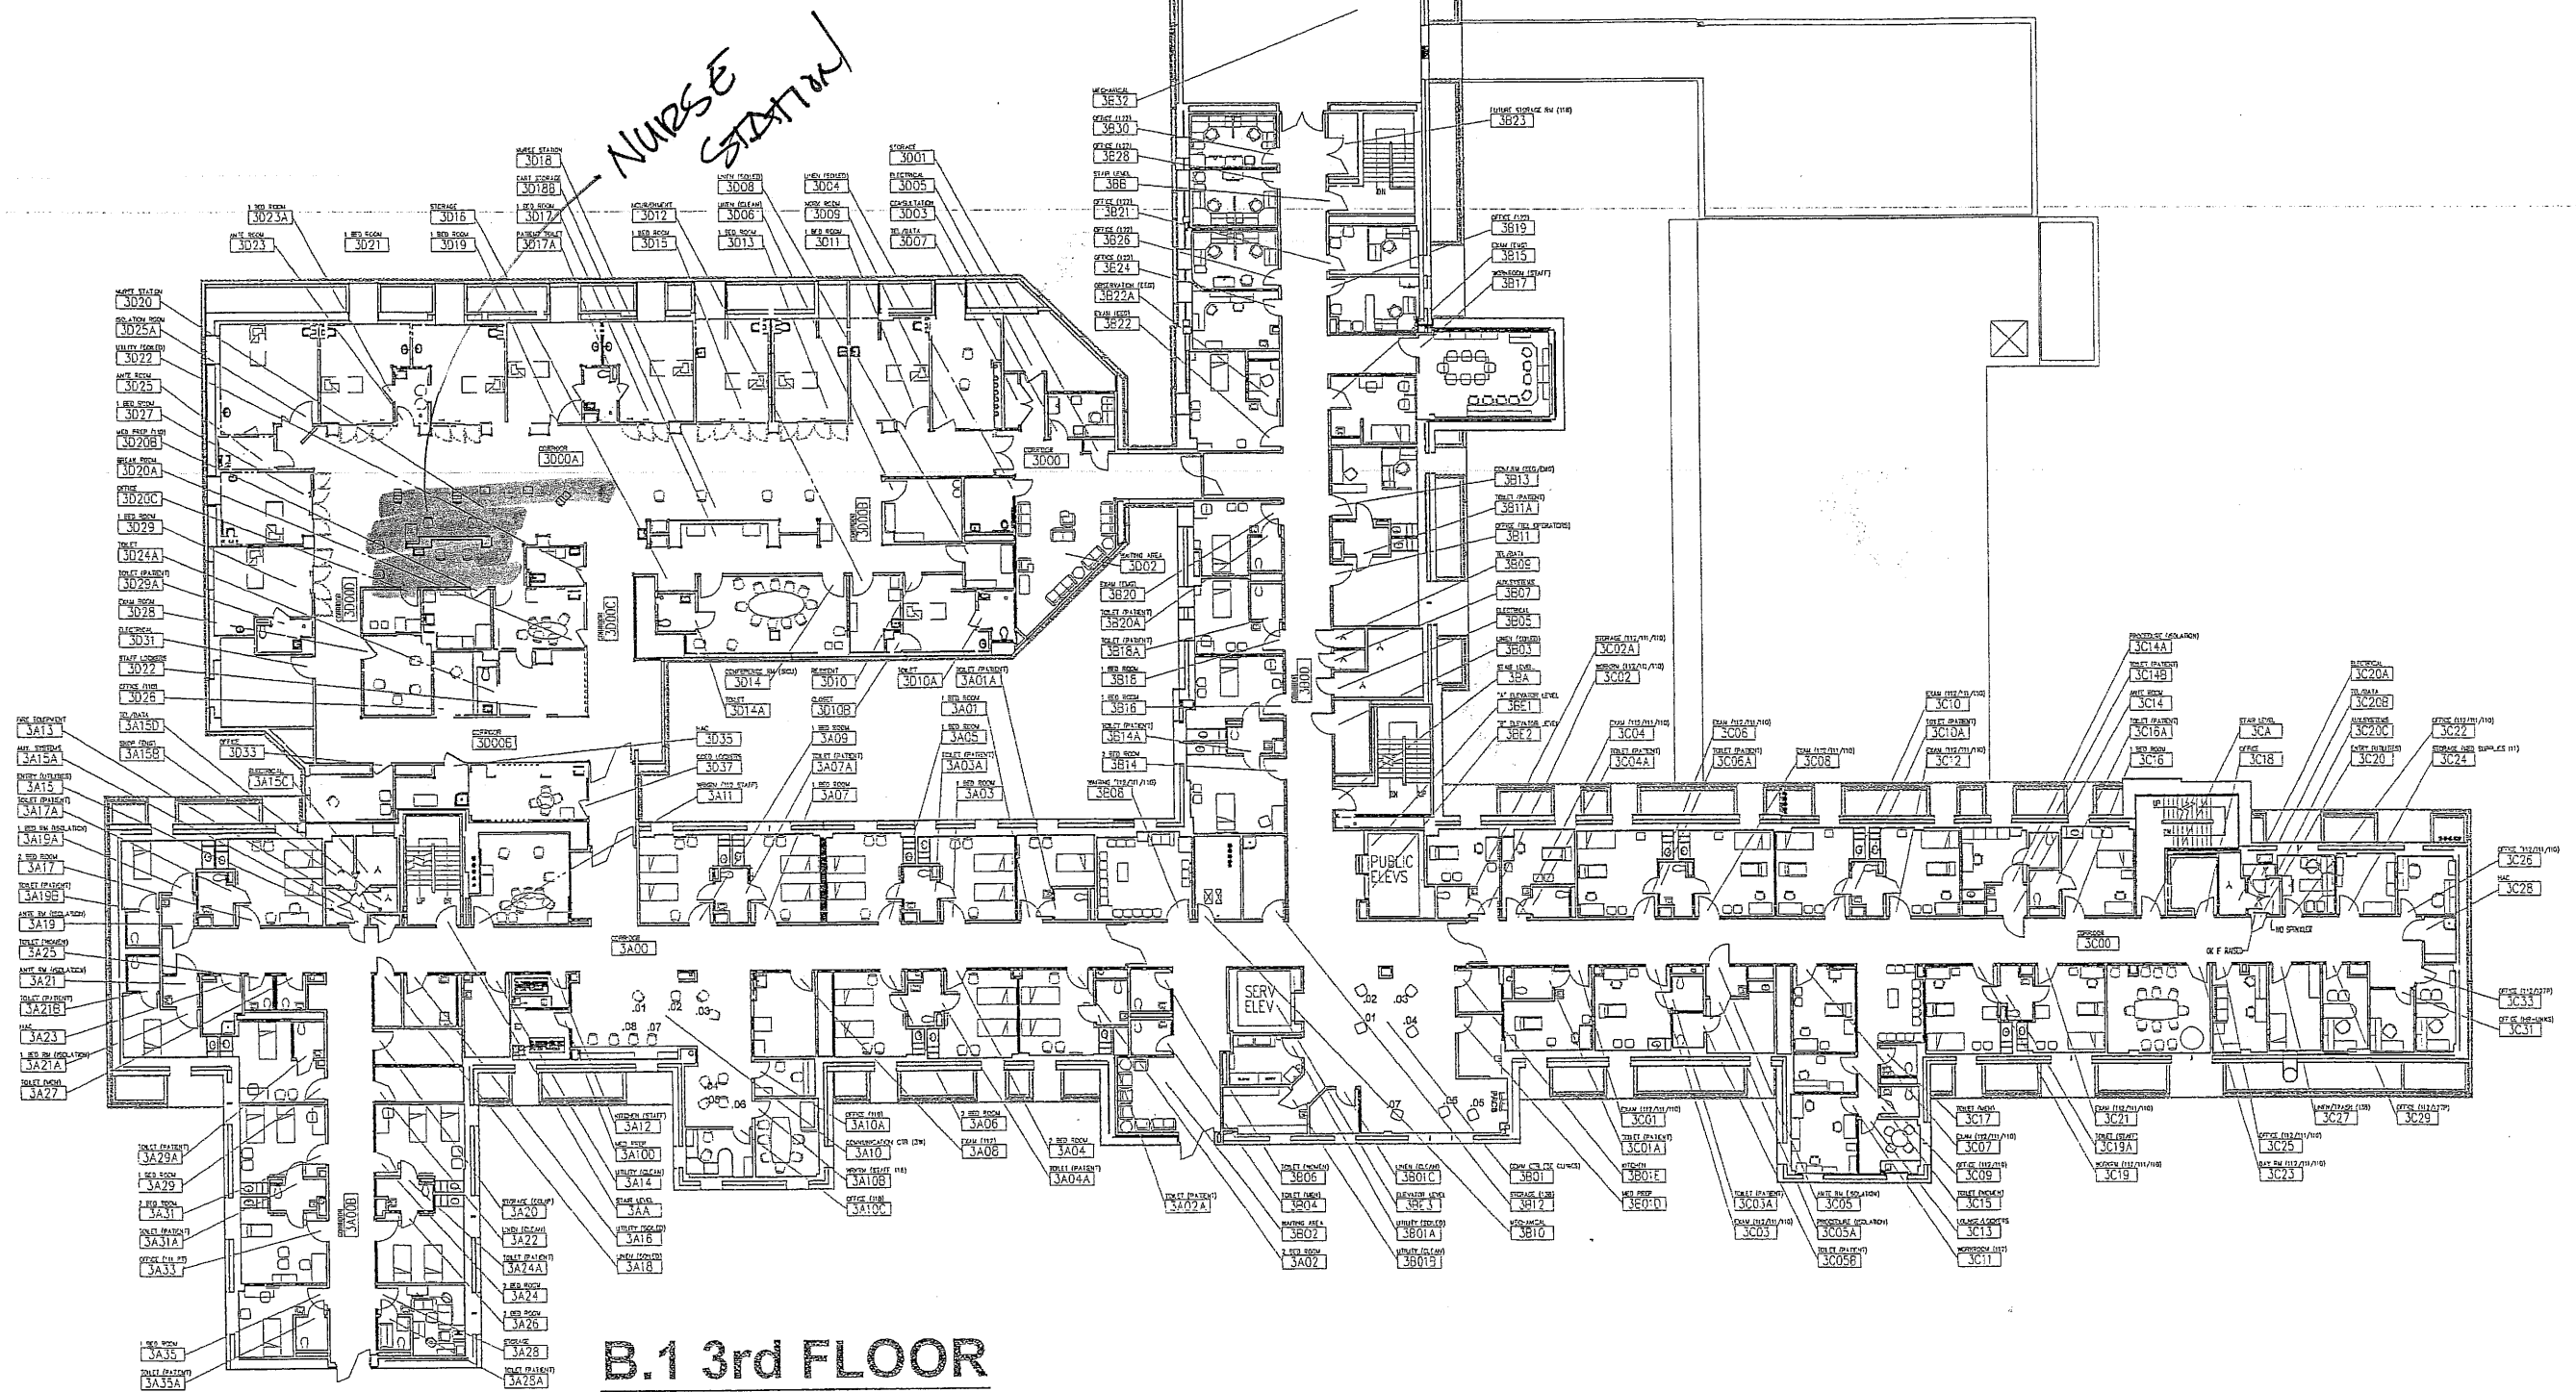


B.1 3rd FLOOR

1/32"=1'-0"

<p>CADD Information CAD/FY06/B1/ARCH/B1-A-G</p>	<p>Drawing Title: B.1 THIRD FLOOR PLAN</p>	<p>Project Title: ARCHITECTURAL ASBUILTS</p>	<p>Date: 02/13</p>
<p>Approved:</p>	<p>Approved: Medical Center Director C RYAN</p>	<p>Building Number: B. 1</p>	<p>DRAWING No. A-4</p>
<p>Approved:</p>	<p>Approved: Chief, Engineering</p>	<p>Location: VAMC, SLC, UTAH.</p>	<p>Page 4 of 8</p>

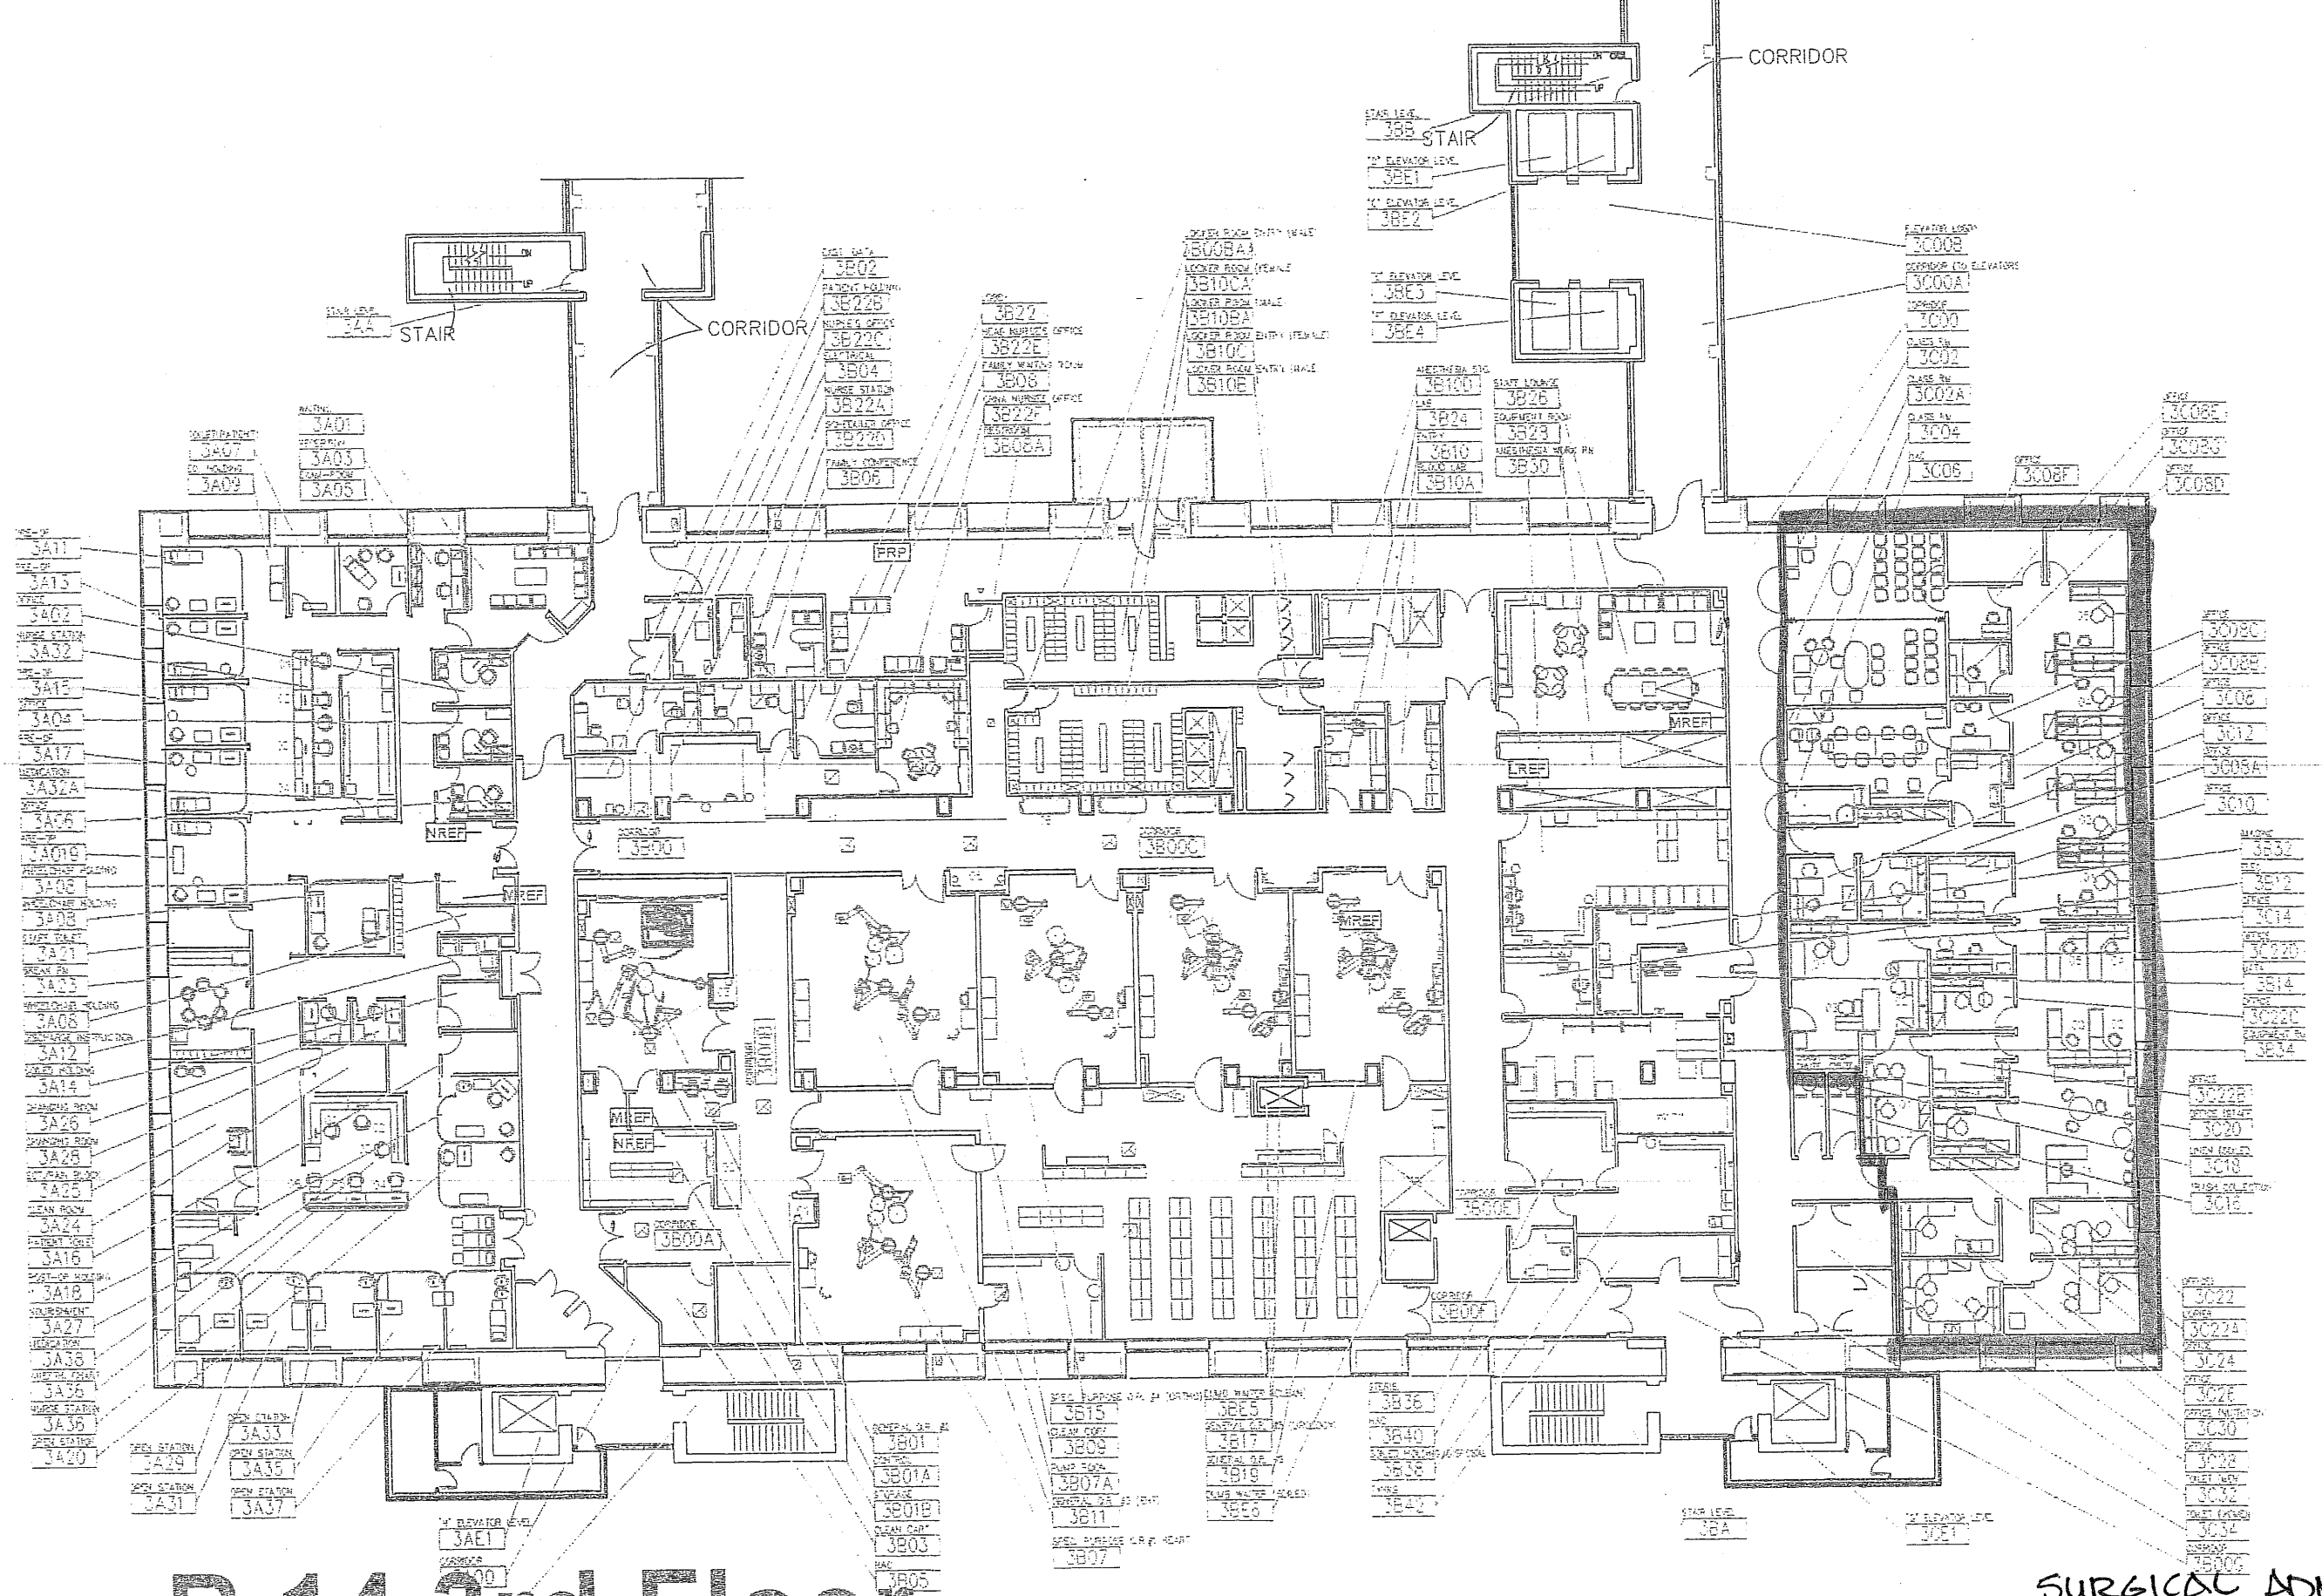

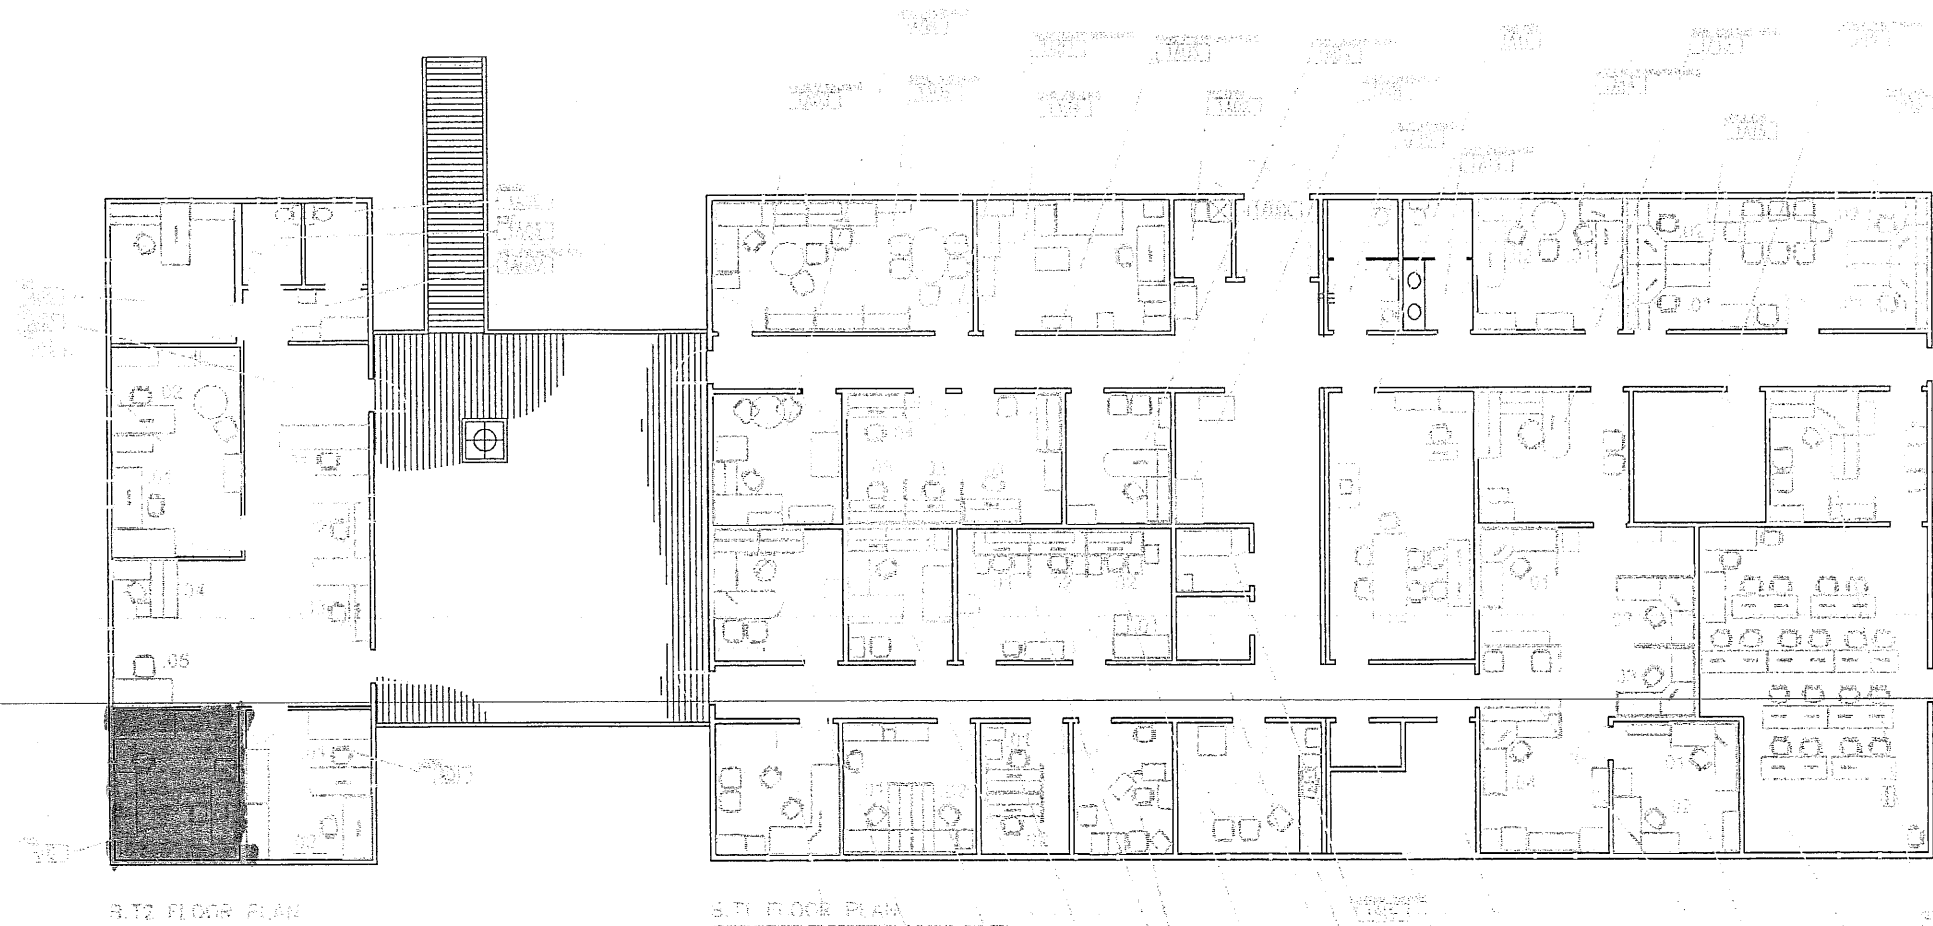

T.1 T.2 1 st FLOOR PLAN

1/16"=1'-0"

Revisions			CADD Information CAD/T.1 T.2/ARCH/BT1-A-1.DWG		Drawing Title B.50 GARDEN LEVEL		Project Title ARCHITECTURAL ASBUILTS		Date 8/30/06
			Approved:		Approved Medical Center Director		Drawn CRYAN	Building Number B. 50	Project No.
			Approved:		Approved Chief, Engineering		Checked	Location VAMC, SLC. UTAH.	DRAWING No. A-1
			Date						Dep. 1 of 1

Department of
Veterans Affairs

