



EAST ELEVATION

SECTION C-C


WEST ELEVATION

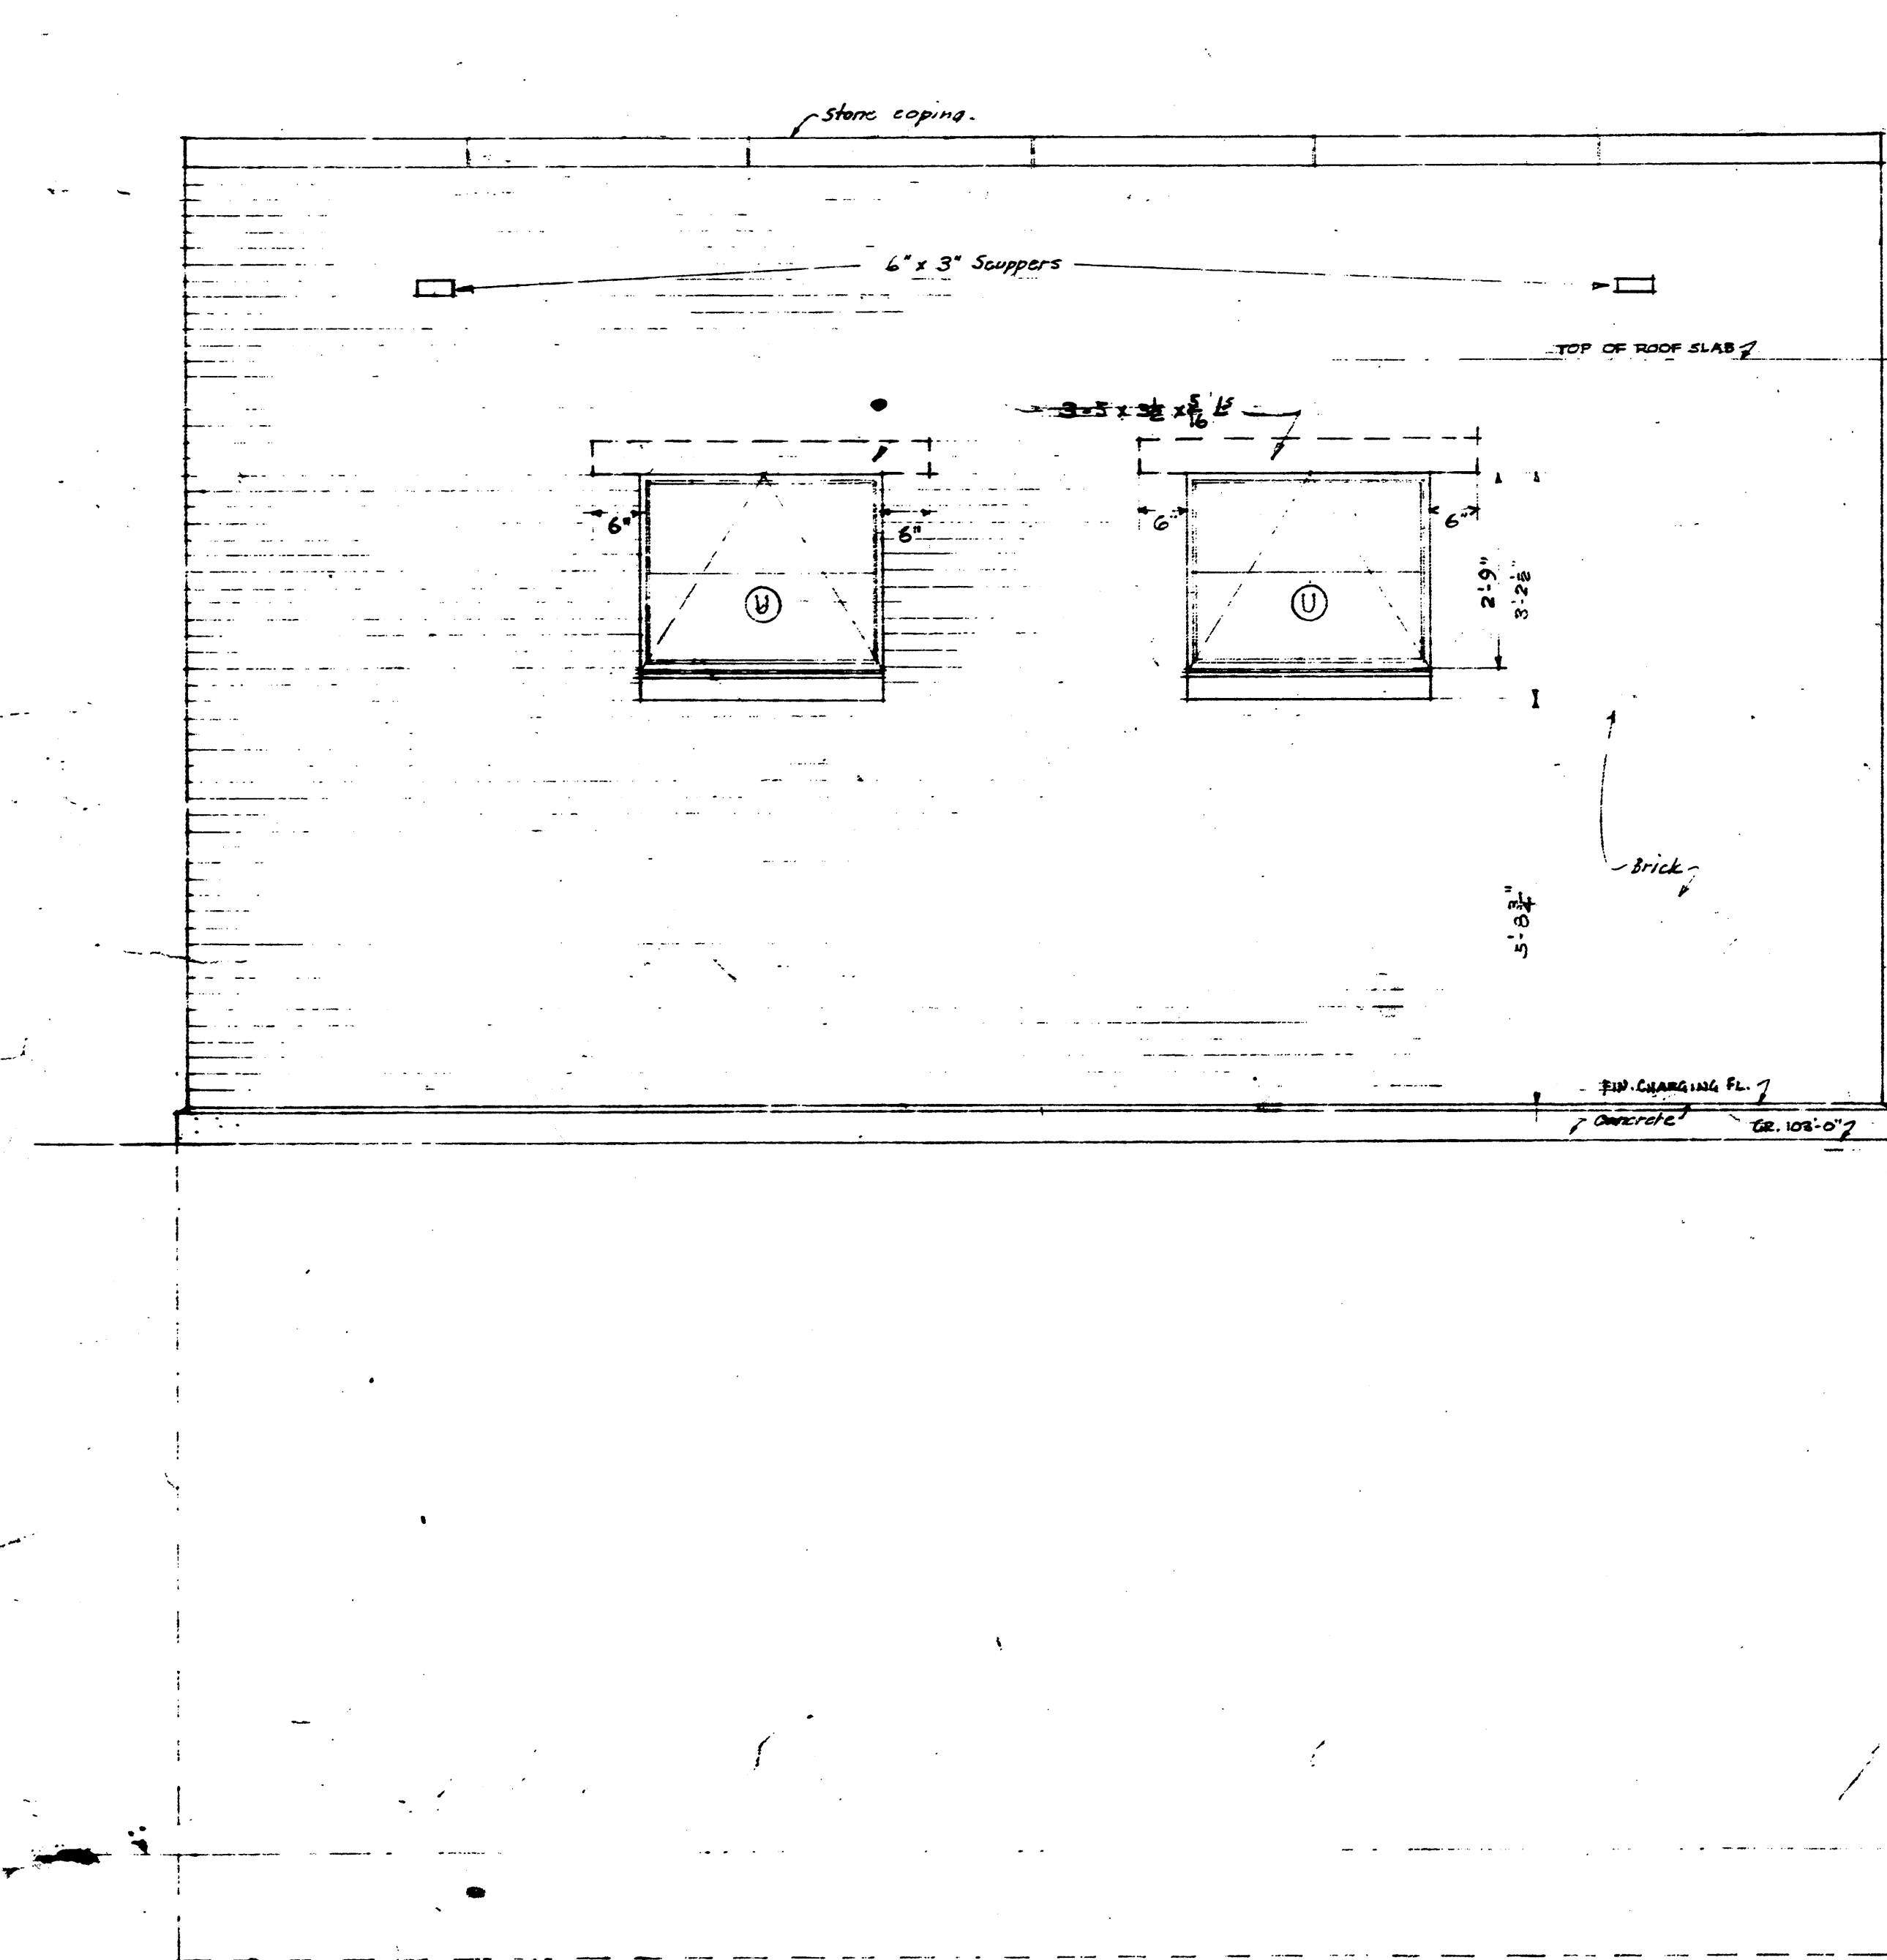

SOUTH ELEVATION

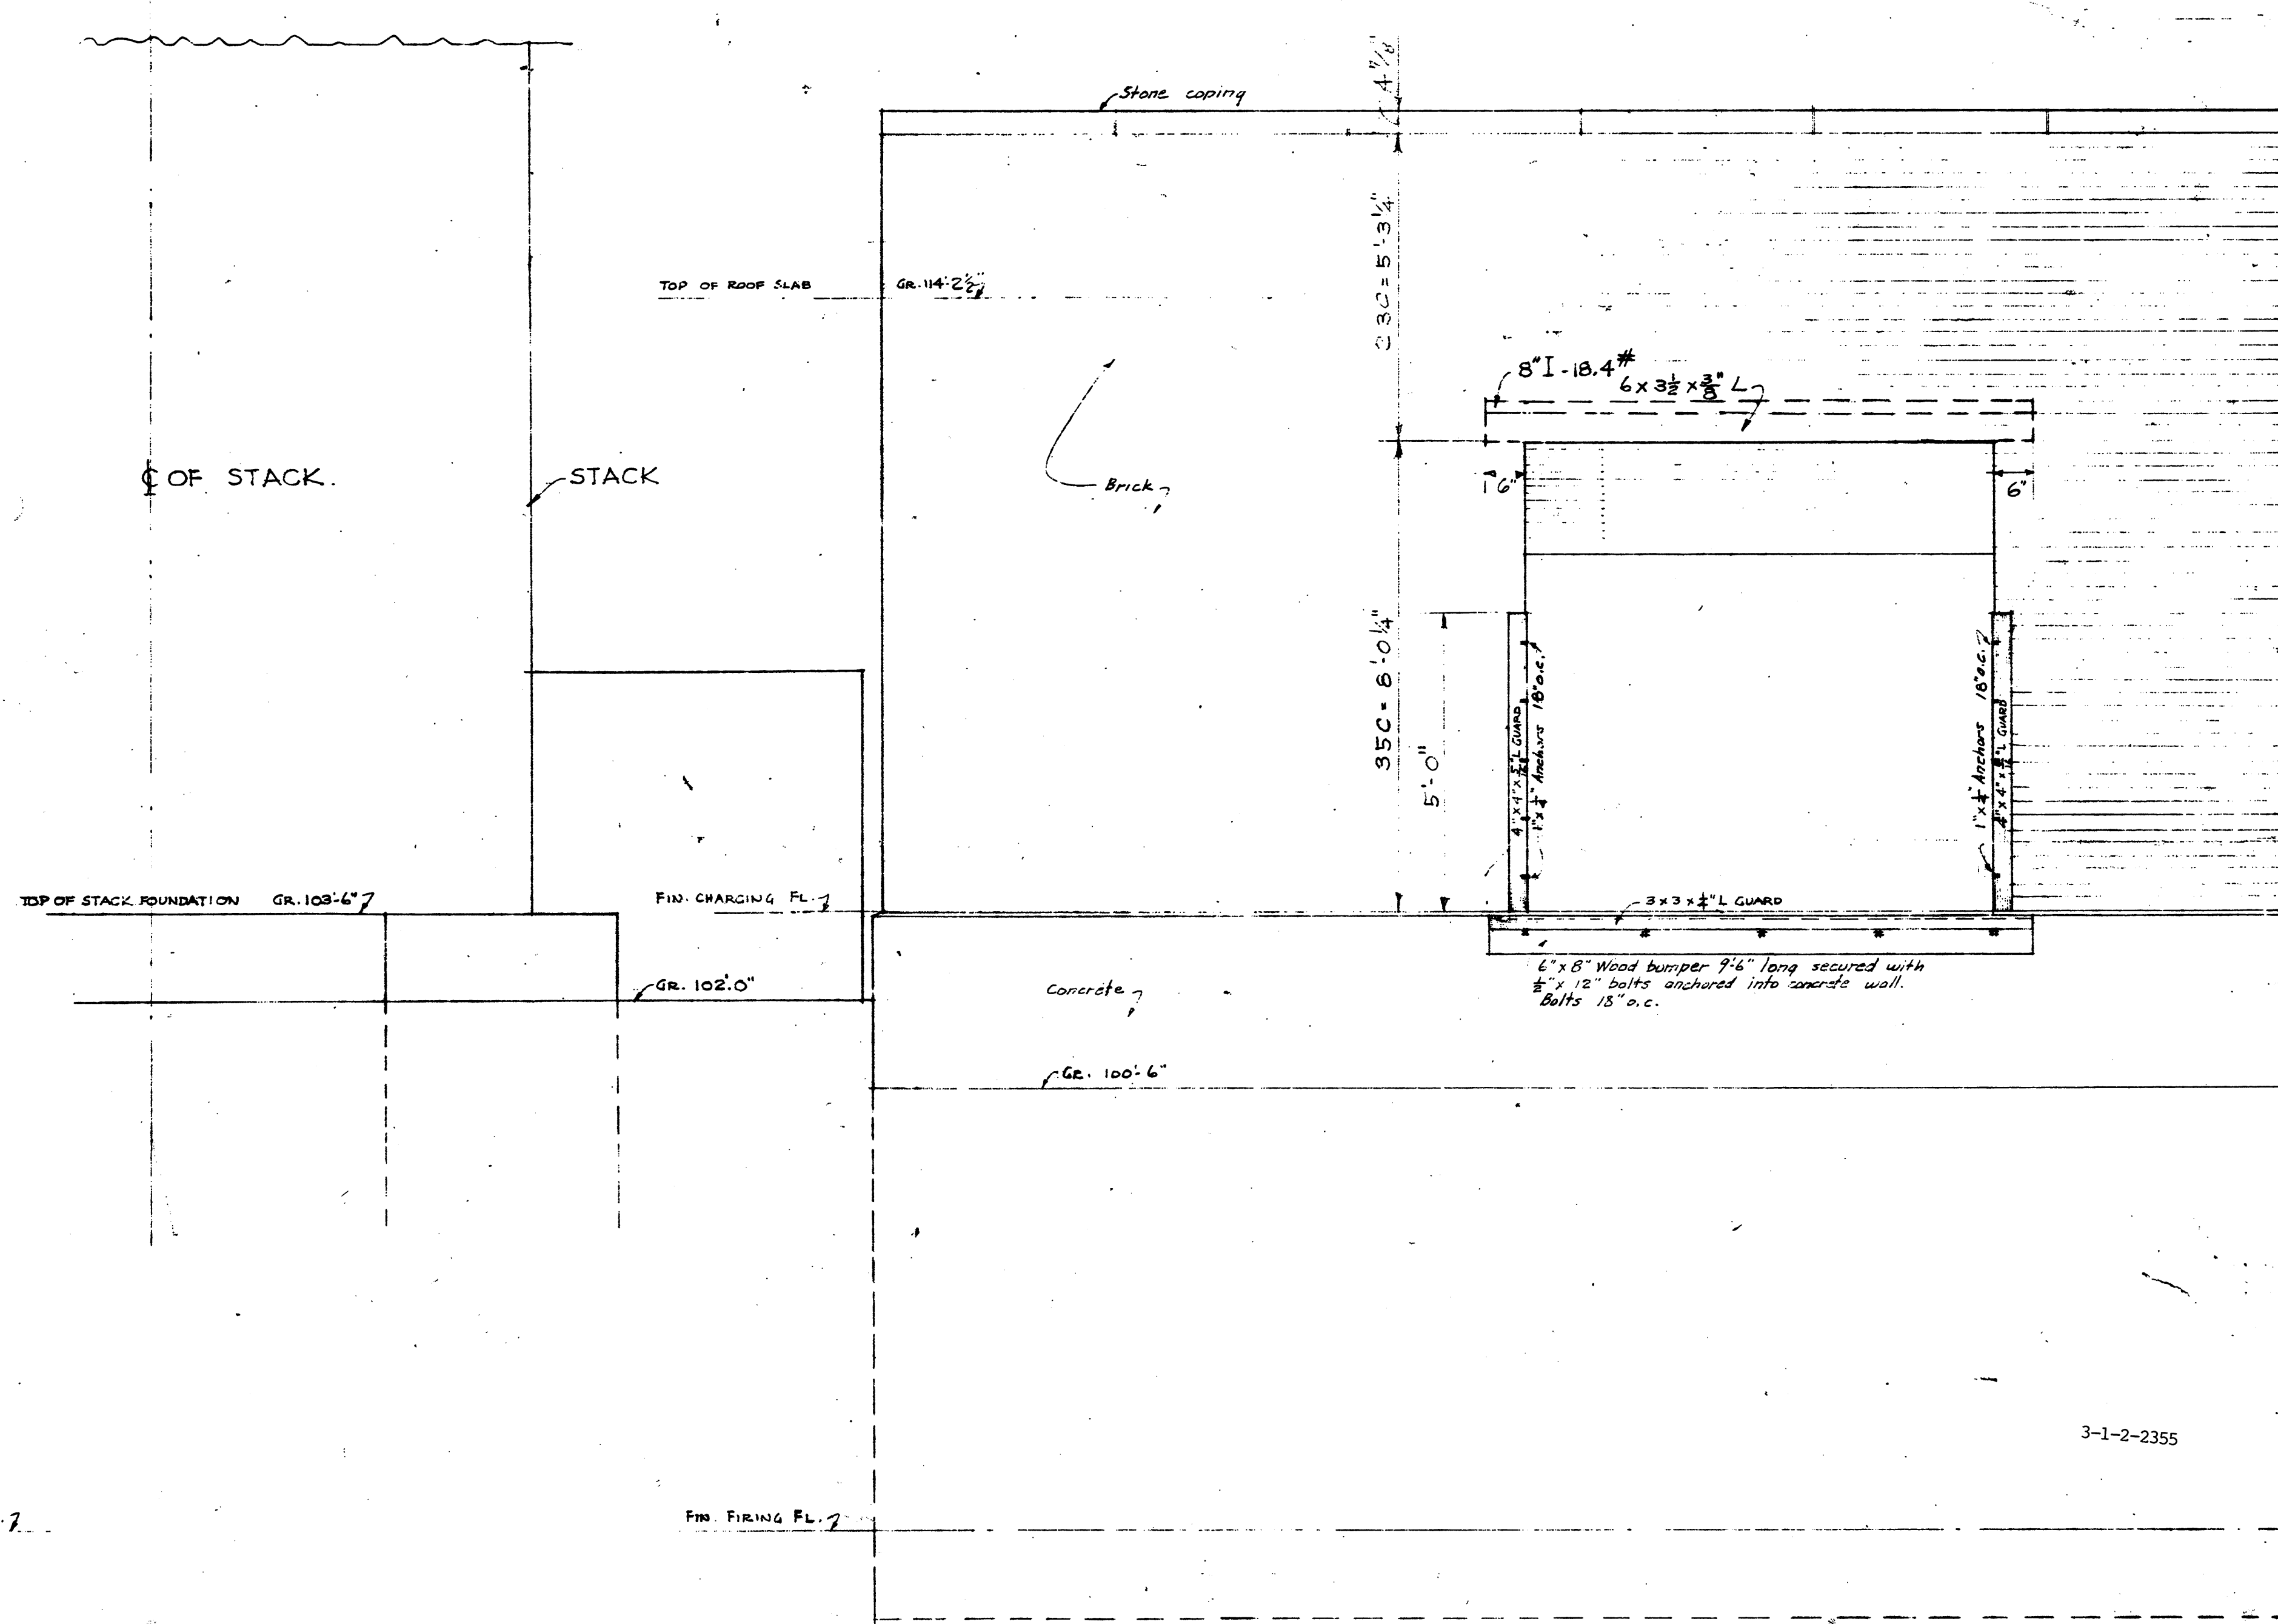

NORTH ELEVATION

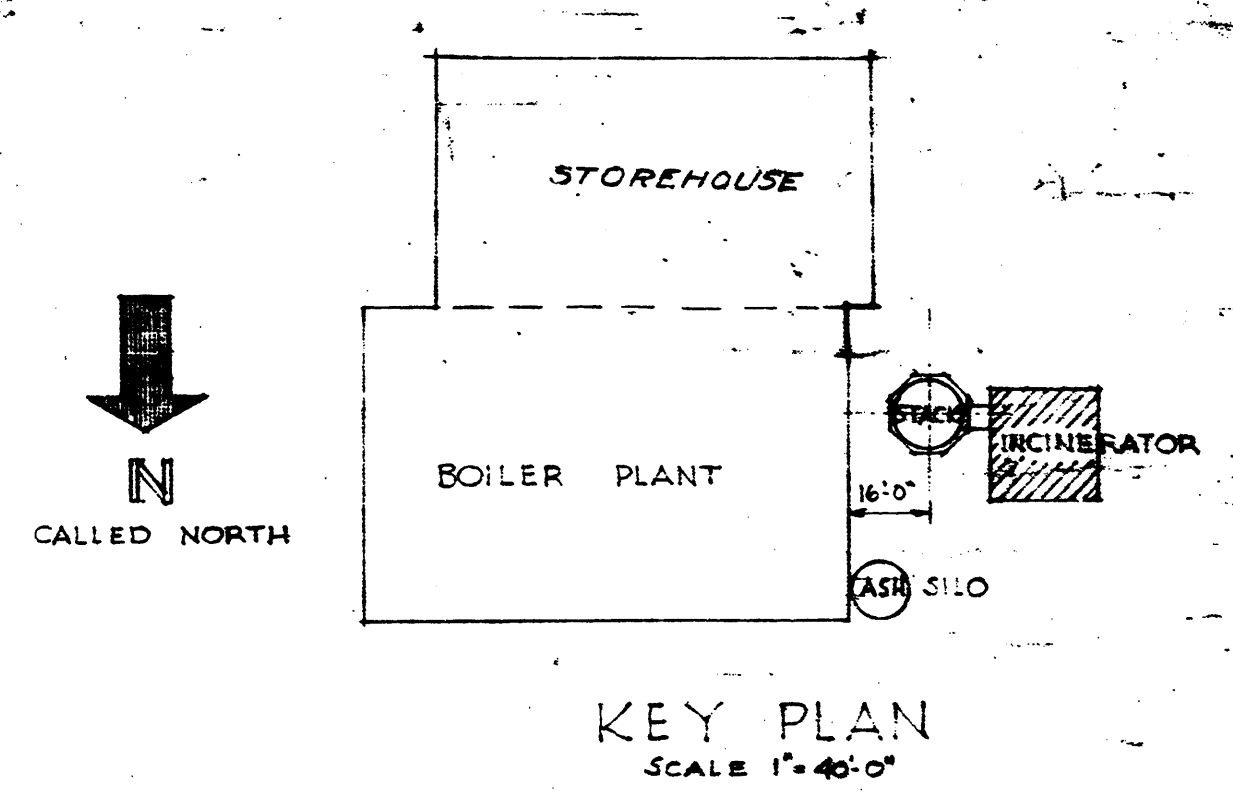

NOTE:  
1. SEE DWG. 36-15-A1 FOR PLANS  
2. SEE DWG. 36-15-S1 FOR  
STRUCTURAL DETAILS  
3. DOORS:  
All masonry clearout door 7' x 7' 6" Min. Hgt.  
Surf. to 1st floor 7' x 7' 6" Min. Hgt.  
To 2nd floor 7' x 7' 6" Min. Hgt.  
Machine Clearing Door 7' x 7' 6" Min. Hgt.

GRAPHIC SCALES

1" = 1'-0"

REVISION	DATE	DESCRIPTION
1		REVISED TO AS-BUILT DRAWING

WILLIAM A. RILEY  
ARCHITECTS - ENGINEERS  
BOSTON, MASS.

DEPARTMENT OF THE ARMY  
CORPS OF ENGINEERS  
NEW ENGLAND DIVISION  
BOSTON, MASS.

VETERANS ADMINISTRATION HOSPITAL  
WEST HAVEN, CONN.

INFLAMMATION & SECTION