

## MPD Tree Relocation

### Attachment 1 - Tree Identification Numbers

#### Trees to be Relocated

ID number	Species *
1056	Coast Redwood
1057	Coast Redwood
1058	Coast Redwood
1060	Coast Redwood
1061	Coast Redwood
No Tag #1	Coast Redwood
No Tag #2	Coast Redwood

\* Species identified by the VAPAHCS Menlo Park Division Tree Inventory & Management Plan - 2012, dated October 2012, prepared by Bartlett Tree Experts.




Source: Esri, DigitalGlobe, GeoEye, i-cubed, USDA, USGS, Getmapping, Aerogrid, IGN, IGP, swisstopo, and the GIS Community

## Attachment 2: Redwood Trees to be Relocated


- Redwood Tree to be Relocated
- ▨ Redwood Tree Relocation Area:  
Exact location to be determined  
by the COR in the field



1:4,800

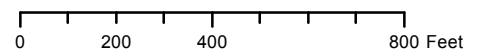

Attachment 3: Tree Relocation - Reference Drawing

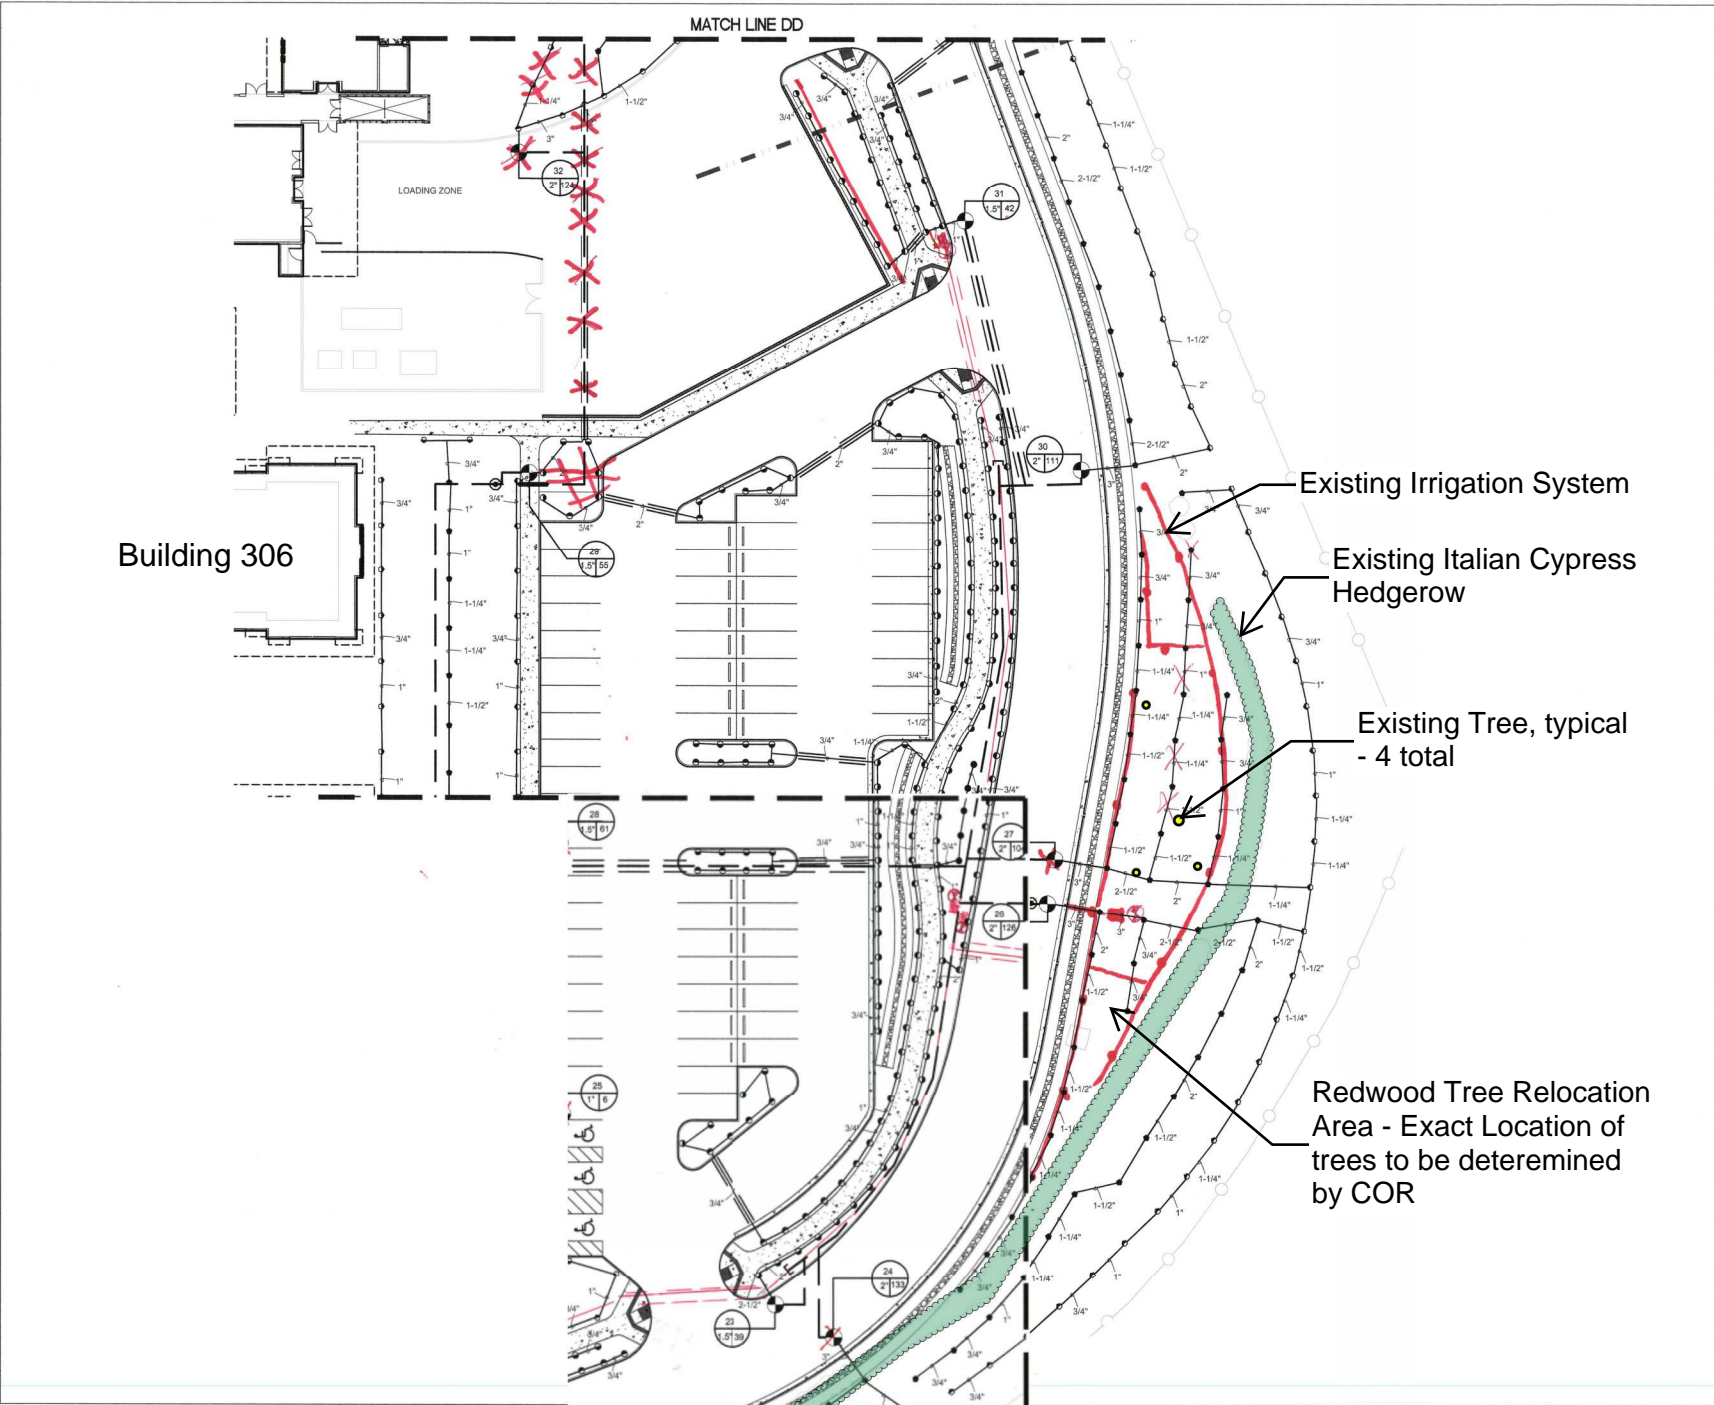

800 BAY BUILDING SAN FRANCISCO CALIFORNIA 94133  
TEL: (415) 862-7276 FAX: (415) 862-7230 www.meiarchitects.com



VA PALO ALTO  
HEALTH CARE SYSTEM  
MENLO PARK DIVISION  
NEW LOOP ROADWAY

DSA PROJECT NO. 640-08-141M  
CONTRACT NO. -



CONSULTANTS:

ROBERT LA ROCCA & ASSOCIATES, INC.  
URBAN DESIGN/LANDSCAPE ARCHITECTURE  
San Francisco, CA 94104  
P: (415) 777-5555 F: (415) 398-0344  
E: rla@robertla.com  
© 2008 Robert La Rocca & Associates, Inc.  
This drawing and all related documents, including the original and electronic files, are the property of Robert La Rocca & Associates, Inc. and shall remain confidential. No part of this drawing may be reproduced, stored in a retrieval system, or transmitted in any form or by any means, electronic, mechanical, photocopying, recording, or by any information storage and retrieval system, without the prior written consent of Robert La Rocca & Associates, Inc.

As-built  
5/15/12

PROGRESS DRAWING  
NOT FOR CONSTRUCTION

NO.	DATE	DESCRIPTION	BY
1	10.16.08	100% CD	HT
2	11.07.08	90% CD	HT
3	12.22.08	80% CD	HT
4	12.22.08	100% CD	HT

NO.	DATE	DESCRIPTION	BY
1	10.16.08	100% CD	HT
2	11.07.08	90% CD	HT
3	12.22.08	80% CD	HT
4	12.22.08	100% CD	HT

ISSUES AND REVISIONS

PROJECT NO.: 053	DRAWN BY: HT
DATE: OCTOBER 16, 2008	CHECKED BY: RL

KEY PLAN



SHEET TITLE:  
**PARTIAL  
IRRIGATION PLAN**

SCALE: 1" = 20'-0"  
SHEET NO.:

**L-4.4**

FILE: J:\PROJECTS\DWGS\DWG  
Drawings and written material appearing herein constitute original and confidential work of the architect and may not be duplicated, used or disclosed without written consent of the architect.