


BOILER HOUSE LOWER FLOOR PLAN
SCALE = 1/4" = 1'-0"

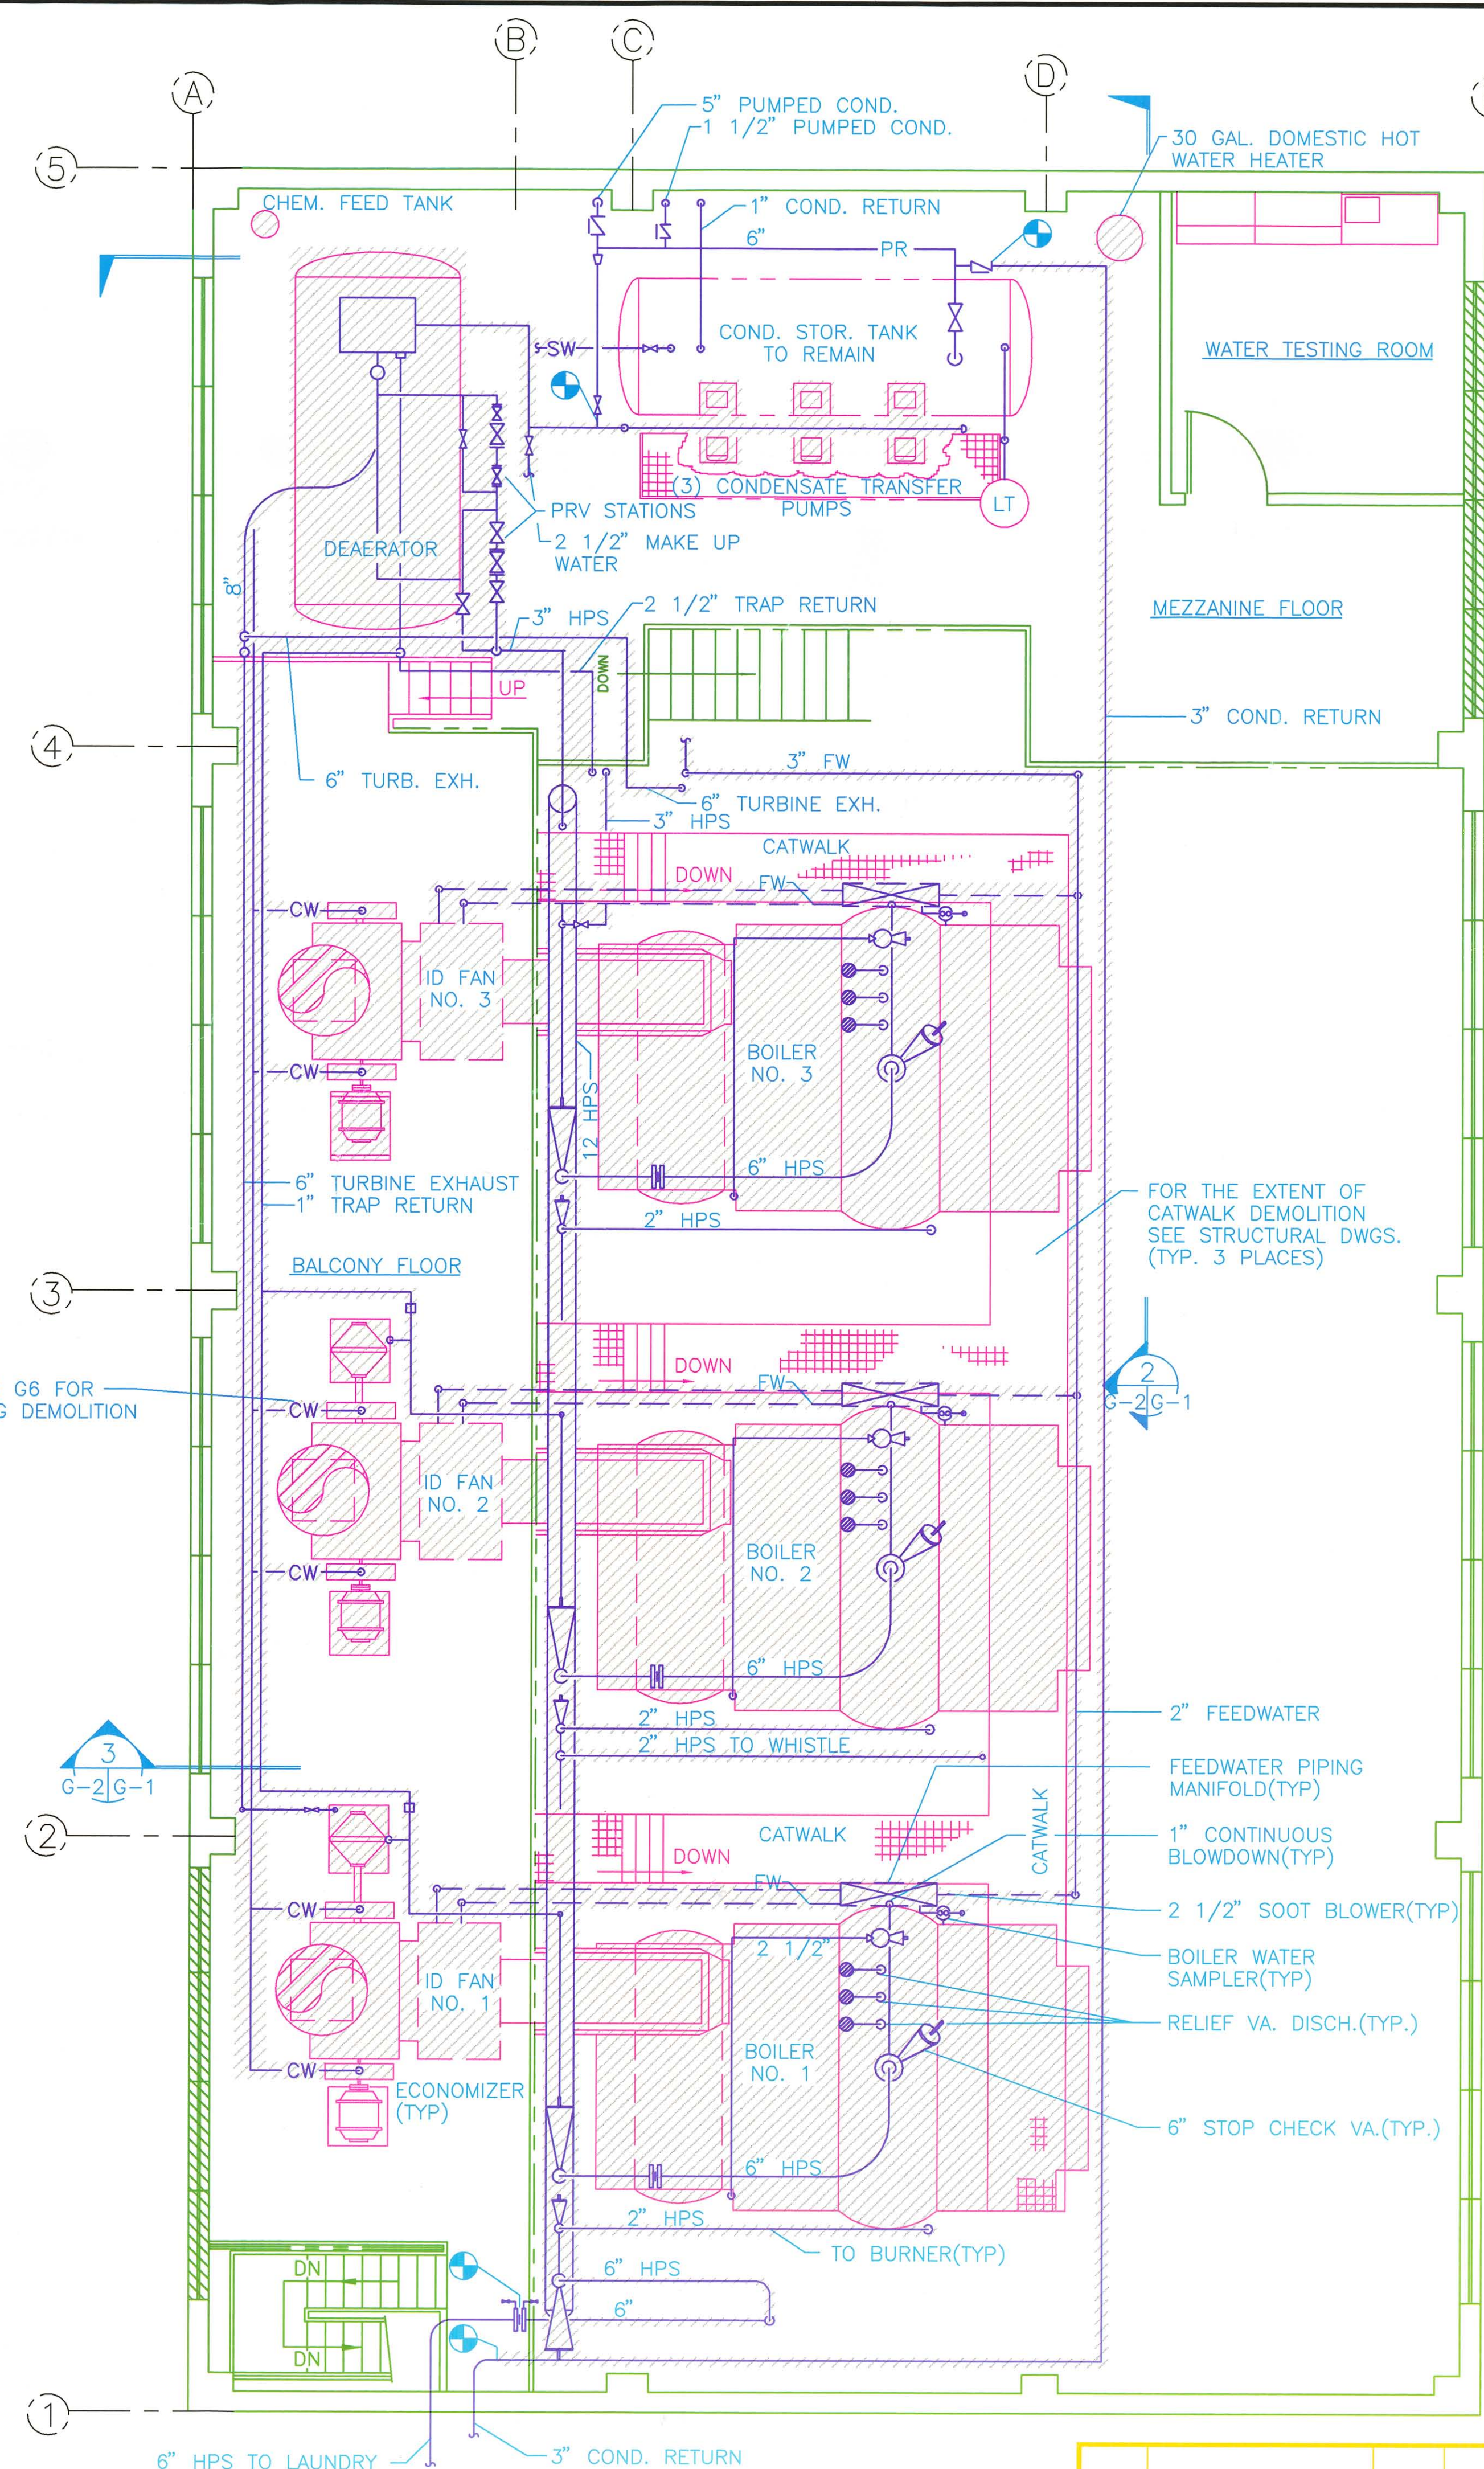

BOILER HOUSE UPPER FLOOR PLAN
SCALE = 1/4" = 1'-0"

NOTE:
1. SEE DWG G-2 FOR ELECTRICAL, MECH. DEMOLITION & ASBESTOS REMOVAL NOTES.

LEGEND

- LIMIT OF DEMOLITION UNLESS COVERED BY NOTES
- REMOVE DURING DEMOLITION AND REPLACE AFTER COMPLETION OF CONSTRUCTION

ASBESTOS REMOVAL

1. ENCLOSE BUILDING. REMOVE ASBESTOS CONTAINING MATERIAL PRIOR TO DEMOLITION.
2. FLOOR TILE AND MASTIC CONTAINS ASBESTOS AND IS TO BE REMOVED.
3. ALL INSULATING MATERIAL IS ASSUMED TO CONTAIN ASBESTOS AND IS TO BE REMOVED.

Job Title:		REPLACE BOILERS PALO ALTO	
Sheet Title:		ASBESTOS REMOVAL/ DEMOLITION PLANS	
VETERANS' ADMINISTRATION MEDICAL CENTER STATION 640, PALO ALTO, CA 94304			
Drawn By:	S.A. COLACCHIA	Checked By:	
Submitted By:		Approved By:	
Scale: 1/4" = 1'-0"		Engineer:	
8415 KATELLA AVE. CYPRESS, CA 90530		J.H. WILLIAMS, INC. ENGINEERING 111 NEW MONTGOMERY ST., SUITE 600 SAN FRANCISCO, CA 94105	
As-Built By:		INTERSTATE CONSTRUCTION Electrical & Mechanical Contractors	
3909 Security Park Drive Rancho Cordova, CA 95742 Phone (916) 351-0622 Fax (916) 351-0950		Date: 9/20/95 Drawing No.: 40-G-1	
Proj. No.: 640-88-125-PA		Sheet 11 of 65	

	REISSUED FOR BID		7/12/93
	ISSUED FOR BID		12/16/93
SYMBOL	DESCRIPTION	INITIAL	DATE
	REVISION		