


Three eighths inch = one foot
One eighth inch = one foot
One quarter inch = one foot
Three sixteenths inch = one foot
One eighth inch = one foot
Three sixteenths inch = one foot
One quarter inch = one foot
Three eighths inch = one foot
One half inch = one foot
Three quarters inch = one foot
One inch = one foot
Two inches = one foot
Three inches = one foot

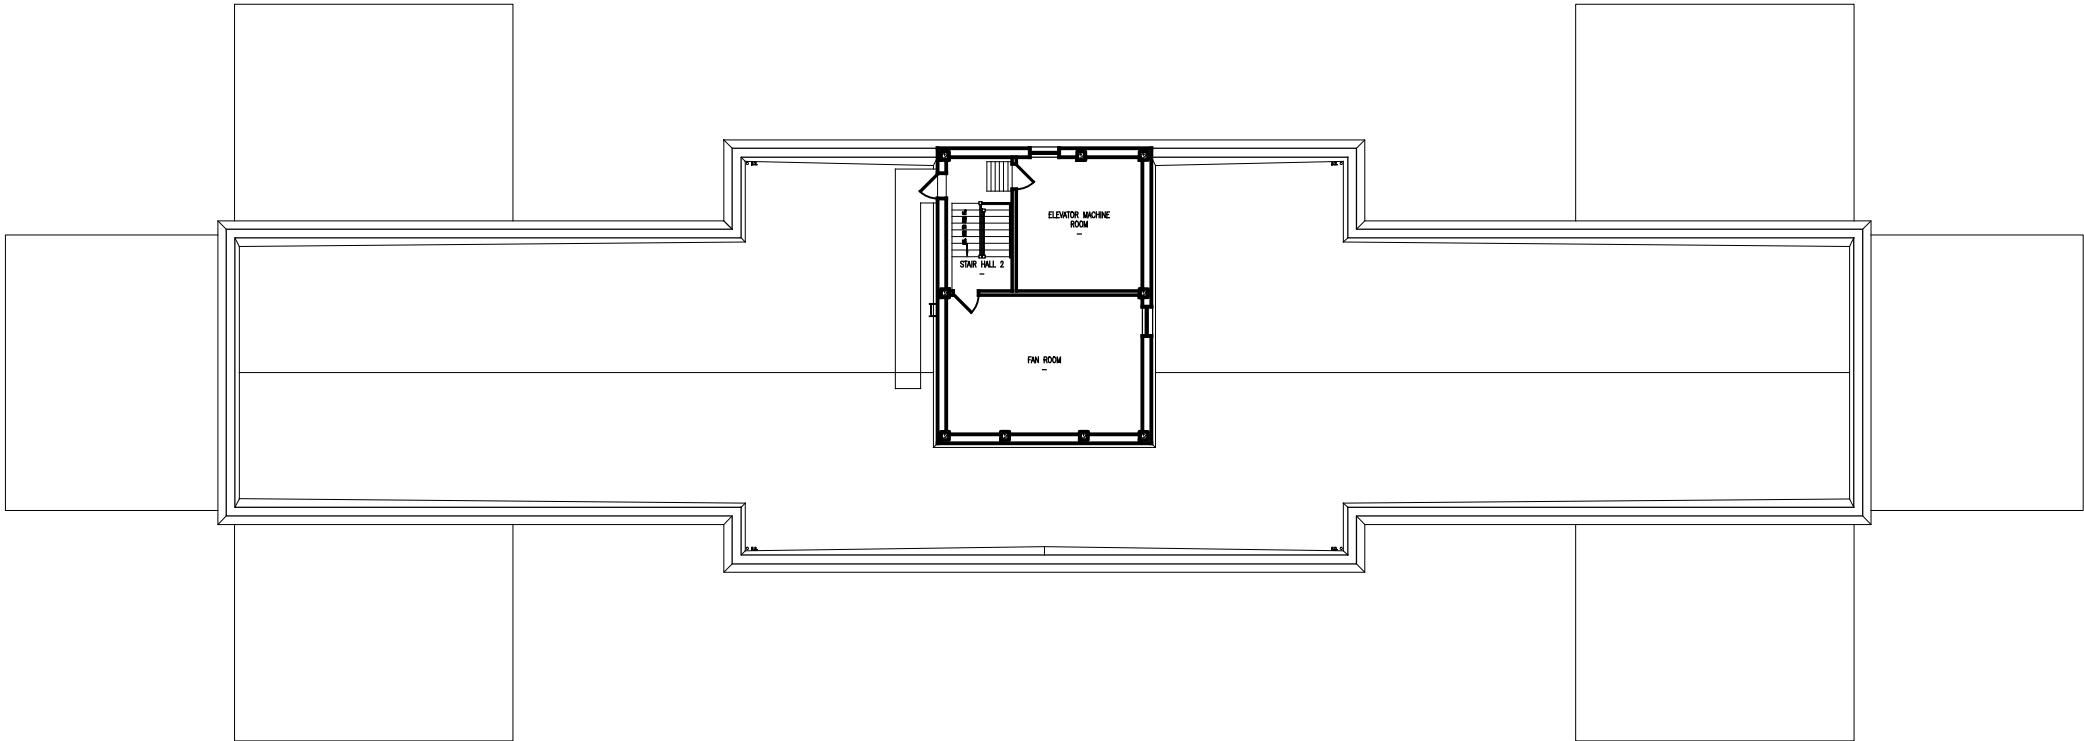

Space Occupancy Table							
Building	Floor	Room	Area	Department	Division	Careline	Description
30	PH	---	278.96 SF	COMMON SPACE	BLDG. SUPPORT SYST.	Common Space	ELEV. MCH. RM.
30	PH	---	450.72 SF	COMMON SPACE	BLDG. SUPPORT SYST.	Common Space	FAN ROOM
			729.68 SF				

1 HR FIRE RATED BARRIER

2 HR FIRE RATED BARRIER

NOTE 1: ALL VACANT SPACE IS AS NOTED UNLESS OTHERWISE SPECIFIED PENDING NEW LOCATION OF SPECIFIC CARELINE SERVICES PRIOR TO DATE OF THE SPACE STUDY.

NOTE 2: ALL CURRENT CARELINE SPACE STUDY IS AS INDICATED OR AS NOTED ON DRAWINGS. UNLESS OTHERWISE NOTED OR SPECIFIED FOLLOWING DATE OF STUDY.

<div>Carline Update01-15-2008</div> <div>Structural Update01-11-2008</div> <div>Title Block and Color Table Modifications10-28-2004</div> <div>As-Built (Indus Systems)Date</div>		<div>CONSULTANTS:</div> <div><div>Indus Systems, Inc.</div><div>2302, Main Street, Concord MA 01742</div><div>Tel: 978-461-5055</div><div>www.indus-systems.com</div></div>	<div>ARCHITECT/ENGINEERS:</div>	<div>NORTH:</div> <div></div>	<div>Drawing Title</div> <div>Architectural Plan</div> <div>Penthouse</div> <div>Scale: 1/8" = 1'-0"</div>	<div>Project Title</div> <div>As-Built</div>	<div>Project Number</div> <div>-</div>	<div>Building Number</div> <div>30</div>	<div>Drawing Number</div> <div>A-06</div>	<div>Office of Facilities Management</div>
					<div>Approved Director</div>	<div>Location</div> <div>Montrose, New York</div>	<div>Date</div> <div>02-28-2009</div>	<div>Checked</div>	<div>Drawn</div> <div>AM</div>	<div>DWG. 6 OF 7</div>