

Indus Systems, Inc.  
2352, Main Street, Concord MA 01742  
Tel: 978-461-0555  
www.indus-systems.com

Drawing Title  
FIRST FLOOR PLAN  
ARCHITECTURAL


Approved:  
Approved:

Project Title  
AS-BUILT Drawings

Building Number  
139  
Location VAMC COATESVILLE

Date  
03-30-2011  
Project No.

Drawing No.

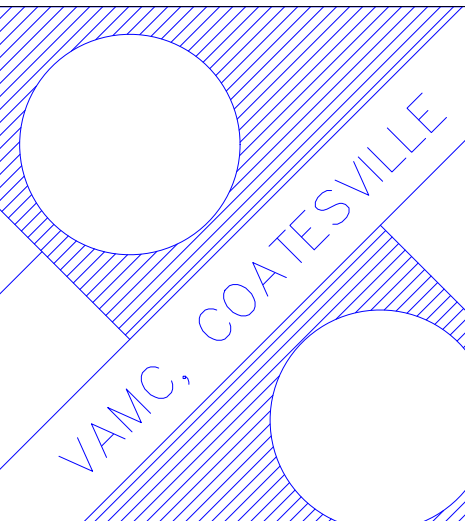

VA Department of Veterans Affairs