


MAP OF LOCATIONS  
CO1 / COE

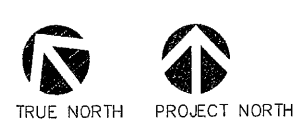


**B.14 1st FLOOR**


1/32"=1'-0"

Revisions	CADD Information CAD/B.14/ARCH/B.14-A-1.DWG		Drawing Title <b>B.14 FIRST FLOOR PLAN</b>		Project Title <b>ARCHITECTURAL ASBUILTS</b>		Date 01/15
	Approved: _____		Approved Medical Center Director		Building Number B. 14		Project No.
	Approved: _____		Approved Chief, Engineering		Checked C RYAN		DRAWING No. A-3
	Date				Location VAMC, SLC. UTAH.		Fig. 3 of 6


Department of Veterans Affairs

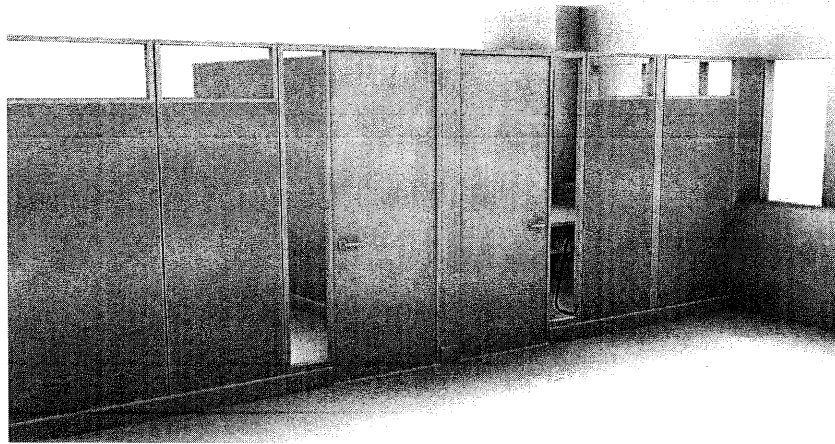


3D3  
3D VIEW  
SCALE: N.T.S.

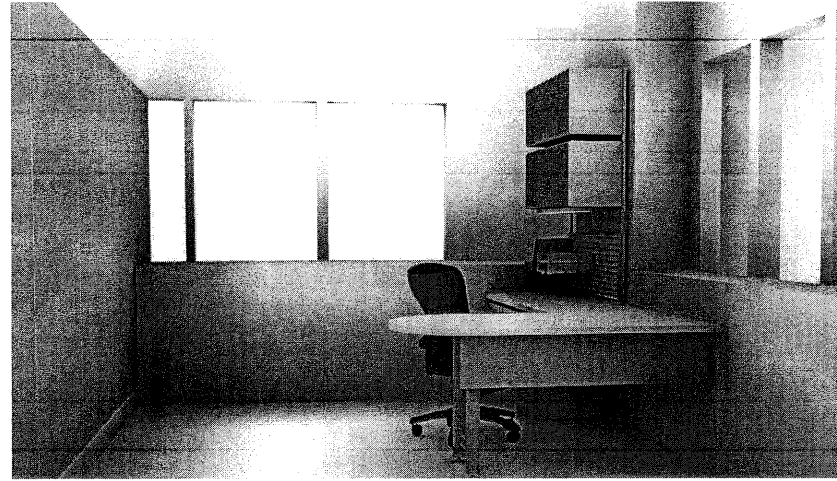

3D4  
3D VIEW  
SCALE: N.T.S.

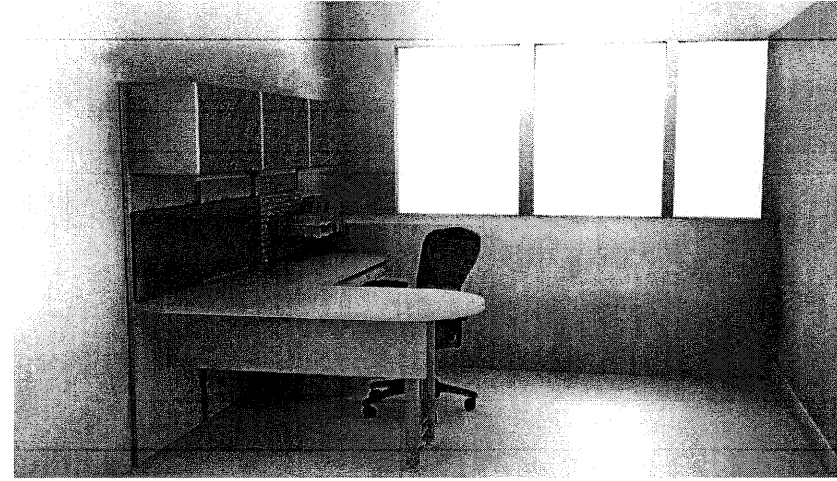


3D5  
3D VIEW  
SCALE: N.T.S.

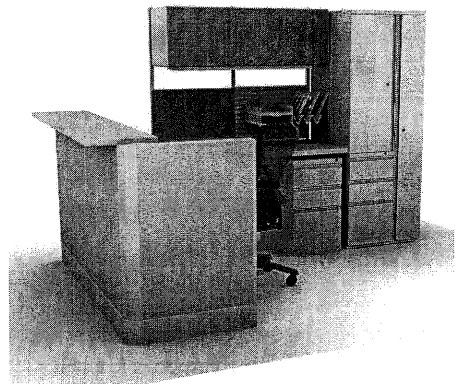

3D2  
3D VIEW  
SCALE: N.T.S.



3D1  
3D VIEW  
SCALE: N.T.S.

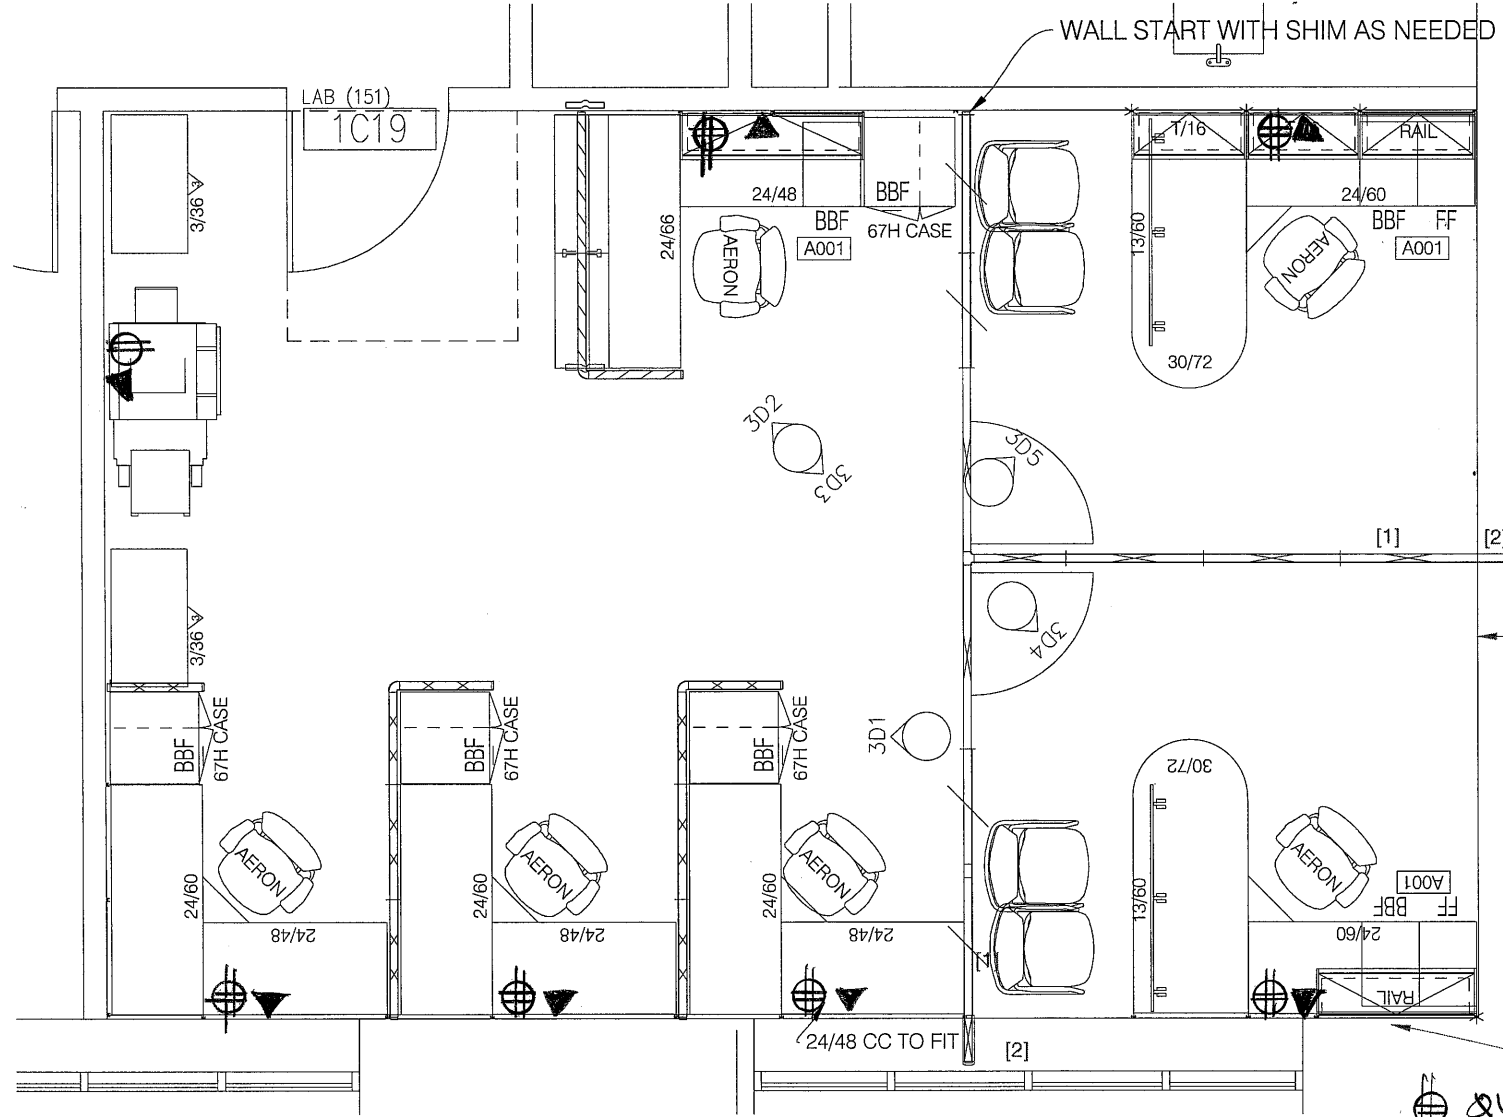

A FURNITURE PLAN 1C19  
SCALE: 1/4" = 1'-0"

NOTES:  
[1] 85H PANEL TO WALL START BELOW SILL WITH 34H WALL START & 34H CHG OF HT DRAW ROD  
[2] CUSTOM CUT PANEL ATTACHED TO STD 85H PANEL ABOVE WALL START: TOP LINES UP WITH 85H PANEL; BOTTOM OF PANEL CUT SO THAT PANEL WILL REST ON TOP OF SILL; CHG OF HT FIN. END ON EXPOSED END OF PANEL

SILL HEIGHT:  
35-3/4" (TYP.)

ACTUAL MEASUREMENT PER FIELD MEASURE:  
3'-11-3/4"

PER AM, A WALL EXISTS TO SUPPORT

QUAD OUTPUT & GANG BOX  
DATA SUITE (3) w/ UNIV. LINE

ACAD: 35697VAB14\_1  
Z-AXIS: 35697VAB14\_1  
ACT MGR: MM



VA - DR. CANNON OFFICES

VA BUILDING 14


CLIENT APPROVAL  APPROVED  APPROVED AS NOTED  NOT APPROVED  
I HAVE REVIEWED THESE PLANS AND THEY CONFORM TO OUR REQUIREMENTS. I UNDERSTAND THAT ANY MODIFICATIONS TO THESE PLANS WILL RESULT IN ADDITIONAL CHARGES.  
SIGNATURE: \_\_\_\_\_ DATE: \_\_\_\_\_

THE GRAPHIC MATERIAL AND DESIGN CONCEPTS ON THIS PAGE REMAIN AT ALL TIMES PROPERTY OF HENRIKSEN BUTLER DESIGN GROUP, LLC. REPRODUCTION OF THE MATERIAL AND DESIGN CONTAINED HEREIN IS PROHIBITED WITHOUT WRITTEN CONSENT OF HENRIKSEN BUTLER DESIGN GROUP, LLC.



DRAWN: KG  
DATE: 06.08.15  
REV: 07.07.15  
CORE: 35697



249 SOUTH 400 EAST  
SALT LAKE CITY, UT 84111  
www.henriksenbutler.com  
801.363.5681 tel  
801.359.4326 fax

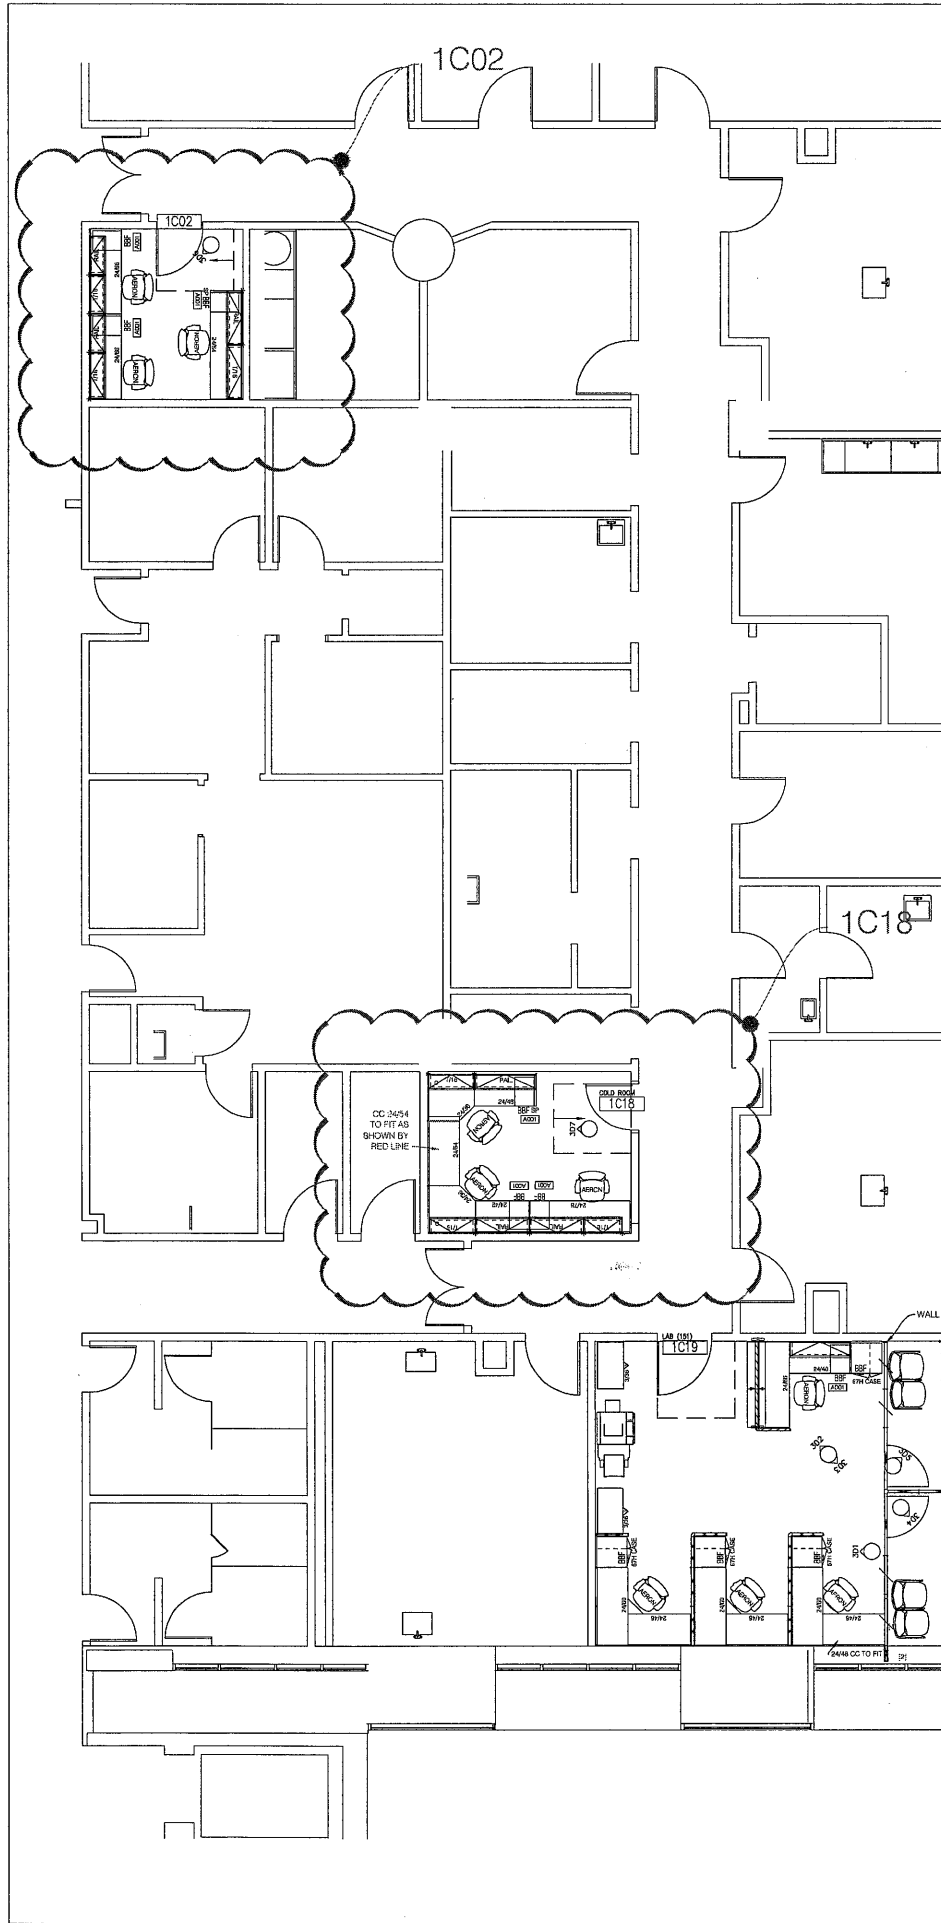


**A** 1C02 FURNITURE PLAN  
SCALE: 1/4" = 1'-0"

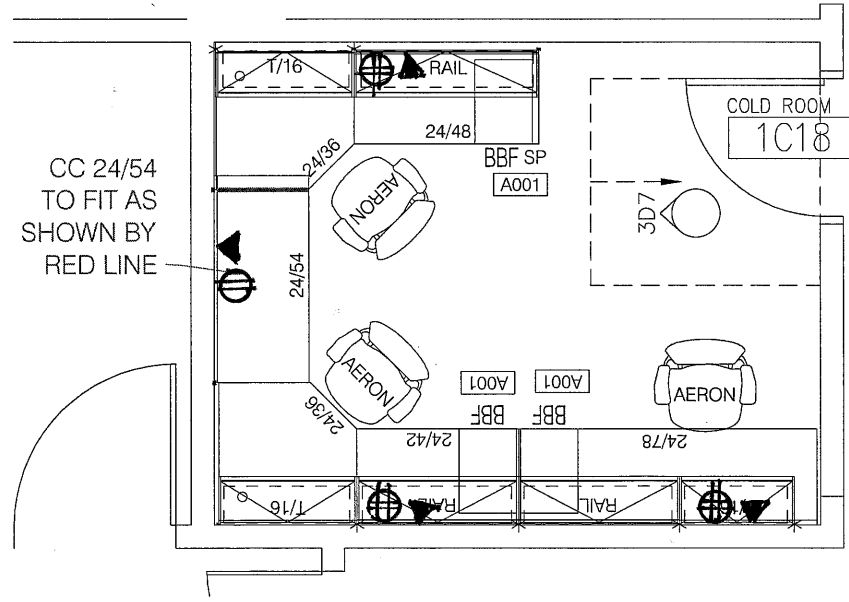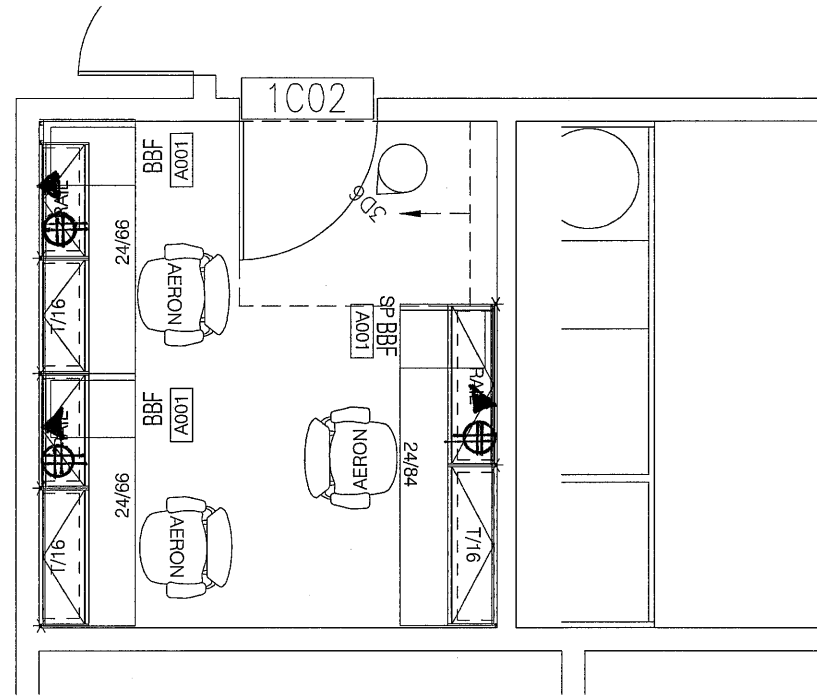

**B** 1C18 FURNITURE PLAN  
SCALE: 1/4" = 1'-0"

⊕ QUAD OUTLET - 4 GANG FOR  
⊕ DUPLEX OUTLET  
▼ DATA SUITE (3) w/ UNIV. LINE

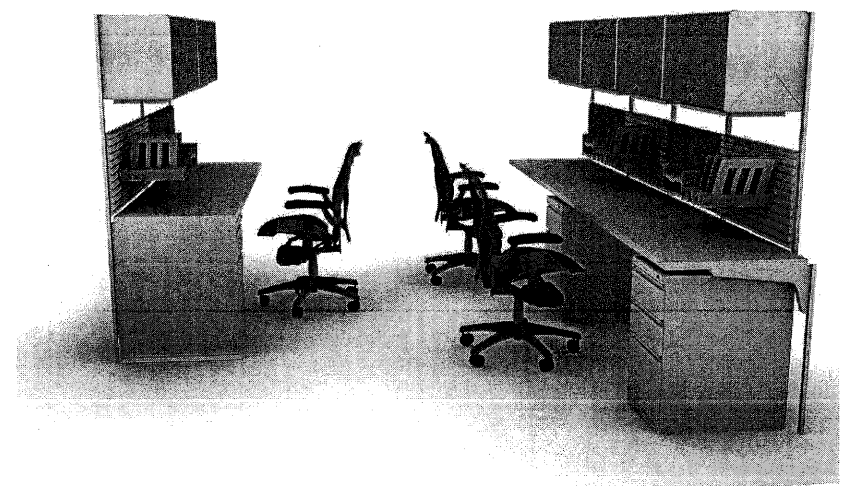

3D6 3D VIEW  
SCALE: N.T.S.



3D7 3D VIEW  
SCALE: N.T.S.

DRAWN: KG  
 DATE: 06.08.15  
 REV: 07.07.15  
 CORE: 35697

VA - DR. CANNON OFFICES

VA BUILDING 14

CLIENT APPROVAL  
 APPROVED  APPROVED AS NOTED  NOT APPROVED  
 I HAVE REVIEWED THESE PLANS AND THEY CONFORM TO OUR REQUIREMENTS.  
 I UNDERSTAND THAT ANY MODIFICATIONS TO THESE PLANS WILL RESULT IN ADDITIONAL CHARGES.  
 SIGNATURE: \_\_\_\_\_ DATE: \_\_\_\_\_

**HB** HENRIKSEN BUTLER  
 249 SOUTH 400 EAST  
 SALT LAKE CITY, UT 84111  
 801 363 5881 tel  
 801 359 4526 fax  
 www.henriksenbutler.com

ACAD: 35697VAB14\_1  
 Z-AXIS: 35697VAB14\_1  
 ACT MGR: MM



THE GRAPHIC MATERIAL AND DESIGN CONCEPTS ON THIS PAGE REMAIN AT ALL TIMES PROPERTY OF HENRIKSEN/BUTLER DESIGN GROUP, LLC. REPRODUCTION OF THE MATERIAL AND DESIGN CONTAINED HEREIN IS PROHIBITED WITHOUT WRITTEN CONSENT OF HENRIKSEN/BUTLER DESIGN GROUP, LLC.