

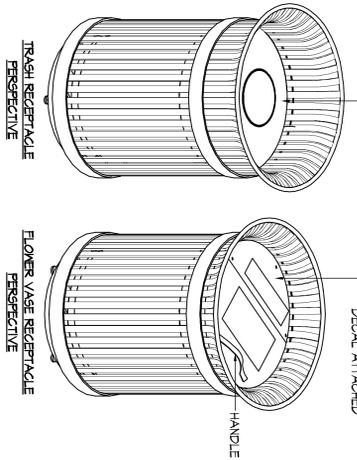


PLAN
1 WATERING STATION
SCALE: N.T.S.

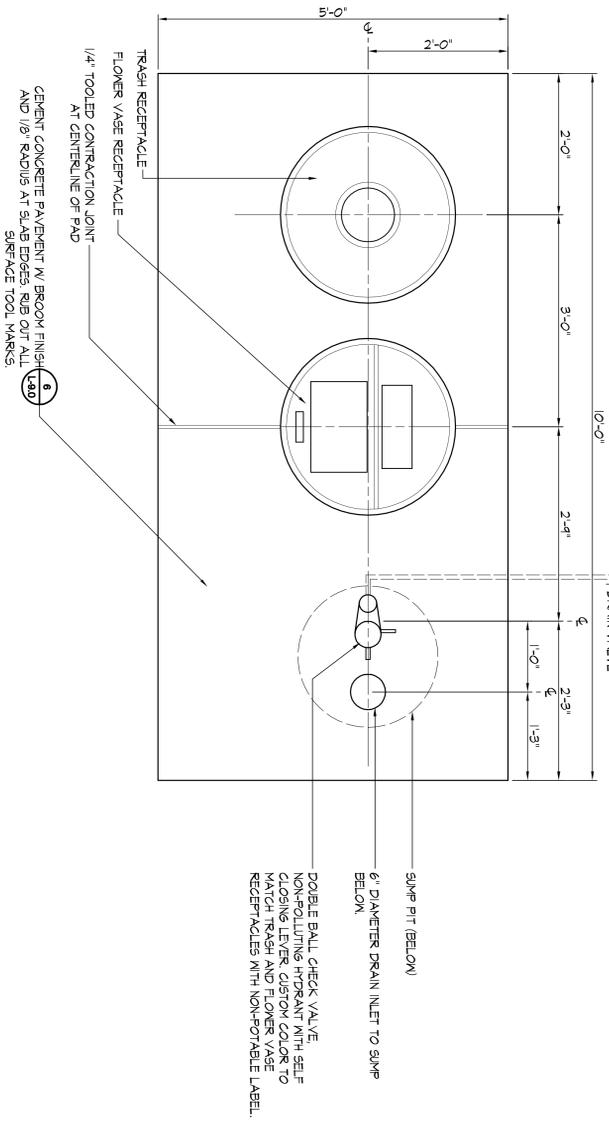

SECTION
2 WATERING STATION CONNECTION TO PRESSURE REGULATOR AND VALVES
SCALE: N.T.S.

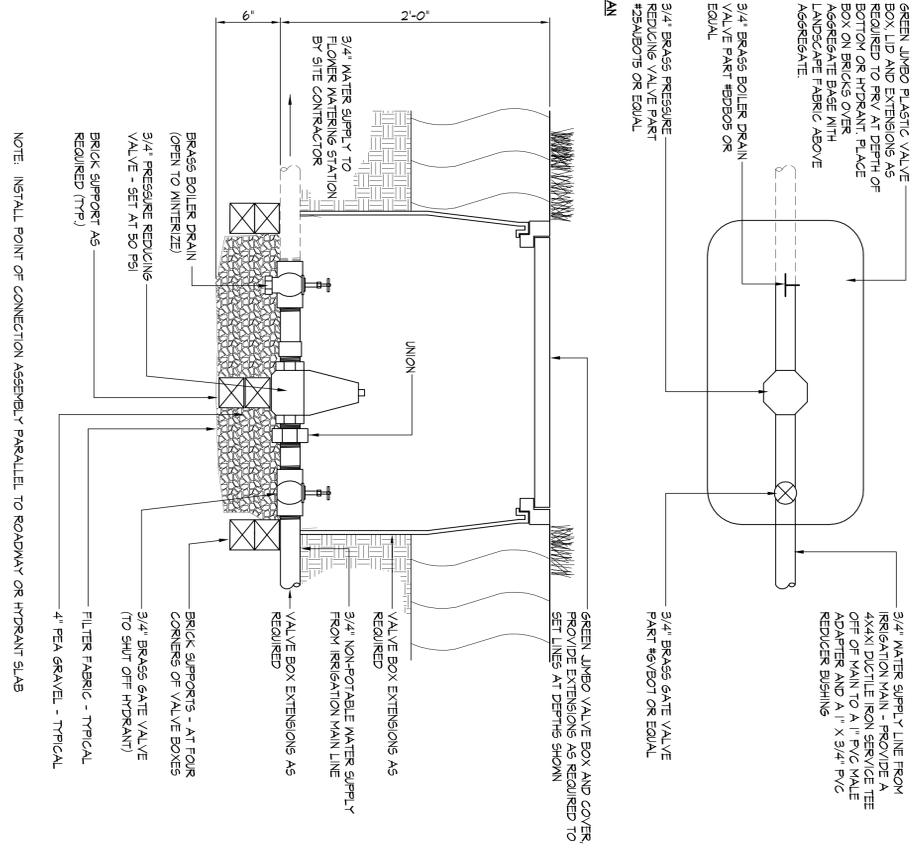

- The Department of Veteran Affairs does not permit adornments that are considered offensive, inconsistent with the dignity of the cemetery or considered hazardous to cemetery personnel.
- Floral arrangements that accompany the casket or urn at the time of burial will be placed on the completed gravesite.
- Fresh cut flowers may be placed on gravesite at any time. The National Cemetery of the Alleghenies will provide metal flower containers.
- Flowers will be removed from gravesites and disposed of by cemetery personnel when they become withered, faded or otherwise unsightly or when it becomes necessary to facilitate cemetery operations such as mowing, interments or any renovations.
- Permanent plantings, statues, vigil lights, breakable objects of any kind, and similar commemorative items are not permitted on gravesites at any time. Cemetery personnel will remove these and other hazardous objects.
- Artificial flowers will be permitted on gravesites during the period from October 10 through April 15. Artificial flowers and potted plants will be permitted on gravesites ten (10) days before and ten (10) days after Easter Sunday and ten (10) days after Memorial Day.
- During the Christmas season, Christmas wreaths, grave floral blankets and other such Christmas floral arrangements will be permitted commencing December 1 and allowed to remain on the grave through January 20 of each year. Grave floral blankets may not be larger than 2-feet by 3-feet.
- Floral items and other types of decorations will not be secured to the headstone or markers.

- NOTES:**
- ALL TEXT TO MATCH N.C.A. STANDARD SIZE AND FONT.
 - SUBMIT CAMERA READY TEXT WOOD-CUT FOR APPROVAL BY RESIDENT ENGINEER

Record Drawings	100/100NS	CONSULTANTS:	
PHASE ONE DEVELOPMENT	SITE DETAILS	NATIONAL CEMETERY ADMINISTRATION	
Project Title	NATIONAL CEMETERY OF THE ALLEGHENIES	Approved: Chief, Architectural & Engineering Division	Project Title
Project No.	925 CM 2001	Approved: Director, Technical Support Service	Building Number
Issue	January 16, 2006	Checked	Drawn
Project No.	925 CM 2001	Location	14-11-26 & 14-11-27
Project No.	925 CM 2001	Location	CEDAR TOWNSHIP WASHINGTON COUNTY, PA
Project No.	925 CM 2001	Project No.	L-9.6
Project No.	925 CM 2001	Project No.	084 of 107