

ZONE SEPARATION
LINE

ZONE 01-G-A CONTROL VALVE,
FLOW SWITCH, AND COMBINATION
INSPECTORS TEST/DRAIN
(ABOVE CEILING)

ZONE 01-G-A

HOSE VALVES
IN CORRIDOR
CLOSET

HOSE VALVE
IN STAIRWELL
CABINET

HOSE VALVES
IN CORRIDOR
CLOSET

SECTIONAL CONTROL
VALVE (NO TAMPER
SWITCH) IN TUNNEL
BELOW, ACCESS
FROM RM GA04

SECTIONAL CONTROL
VALVES (3) WITH
TAMPER SWITCHES
BELOW, ACCESS
FROM RM GD01

ACCESS HATCH FOR
CONTROL VALVES IN
TUNNEL BELOW


MAIN FEED CONTROL VALVE
(CLOSED, NO TAMPER
SWITCH) IN TUNNEL BELOW,
ACCESS FROM RM GA04

NOTE: FIRELINE #1 IS
OUT OF SERVICE

BUILDING 1 POST INDICATOR
VALVE WITH TAMPER SWITCH
(ON FIRELINE #1 OF 2 FOR
BLDG 1 AND TOWER, NOT FED
THROUGH PUMP) OUT OF
SERVICE


NOTE: FIRELINE #1 IS
OUT OF SERVICE

BUILDING 1 FREE
STANDING FDC

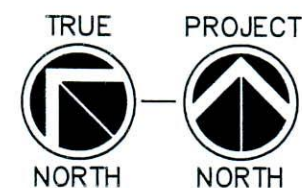

0 8' 16' 32'
SCALE: 1/16" = 1'-0"

KEY PLAN

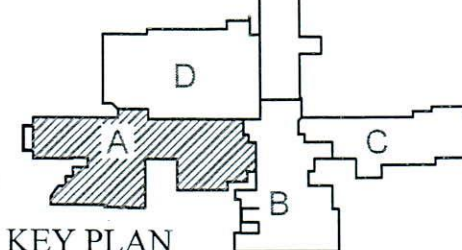

Revisions

Date
Date



324 South State Street, Suite 400
Salt Lake City, Utah 84111
801.328.5151
800.678.7077
FAX 801.328.5155
www.spectrum-engineers.com

Project Title
CAMPUS WIDE FIRE SPRINKLING TEST STATION
MODIFICATION AND DEFICIENCIES STUDY

Consultant Project No. 20100195

Drawn BXW

Checked JDD

Drawing Title
BUILDING 1
GROUND LEVEL
ZONE A

Date
08.03.2010
Project No.
660-10-110
Building No.
1

Drawing No.
F.01.1A
Dep. of XX
VAMC
TO QUALITY

Department of
Veterans Affairs

AS-BUILT RECORD DRAWINGS