

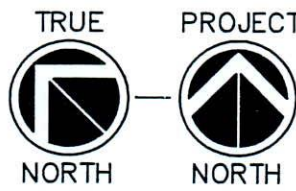


File Name: P:\2010\20100195\Drawings\Bldg 1\3Sheet\95F.01.1.dwg Last Plotted: 2010/11/01 12:29 PM By: jdd

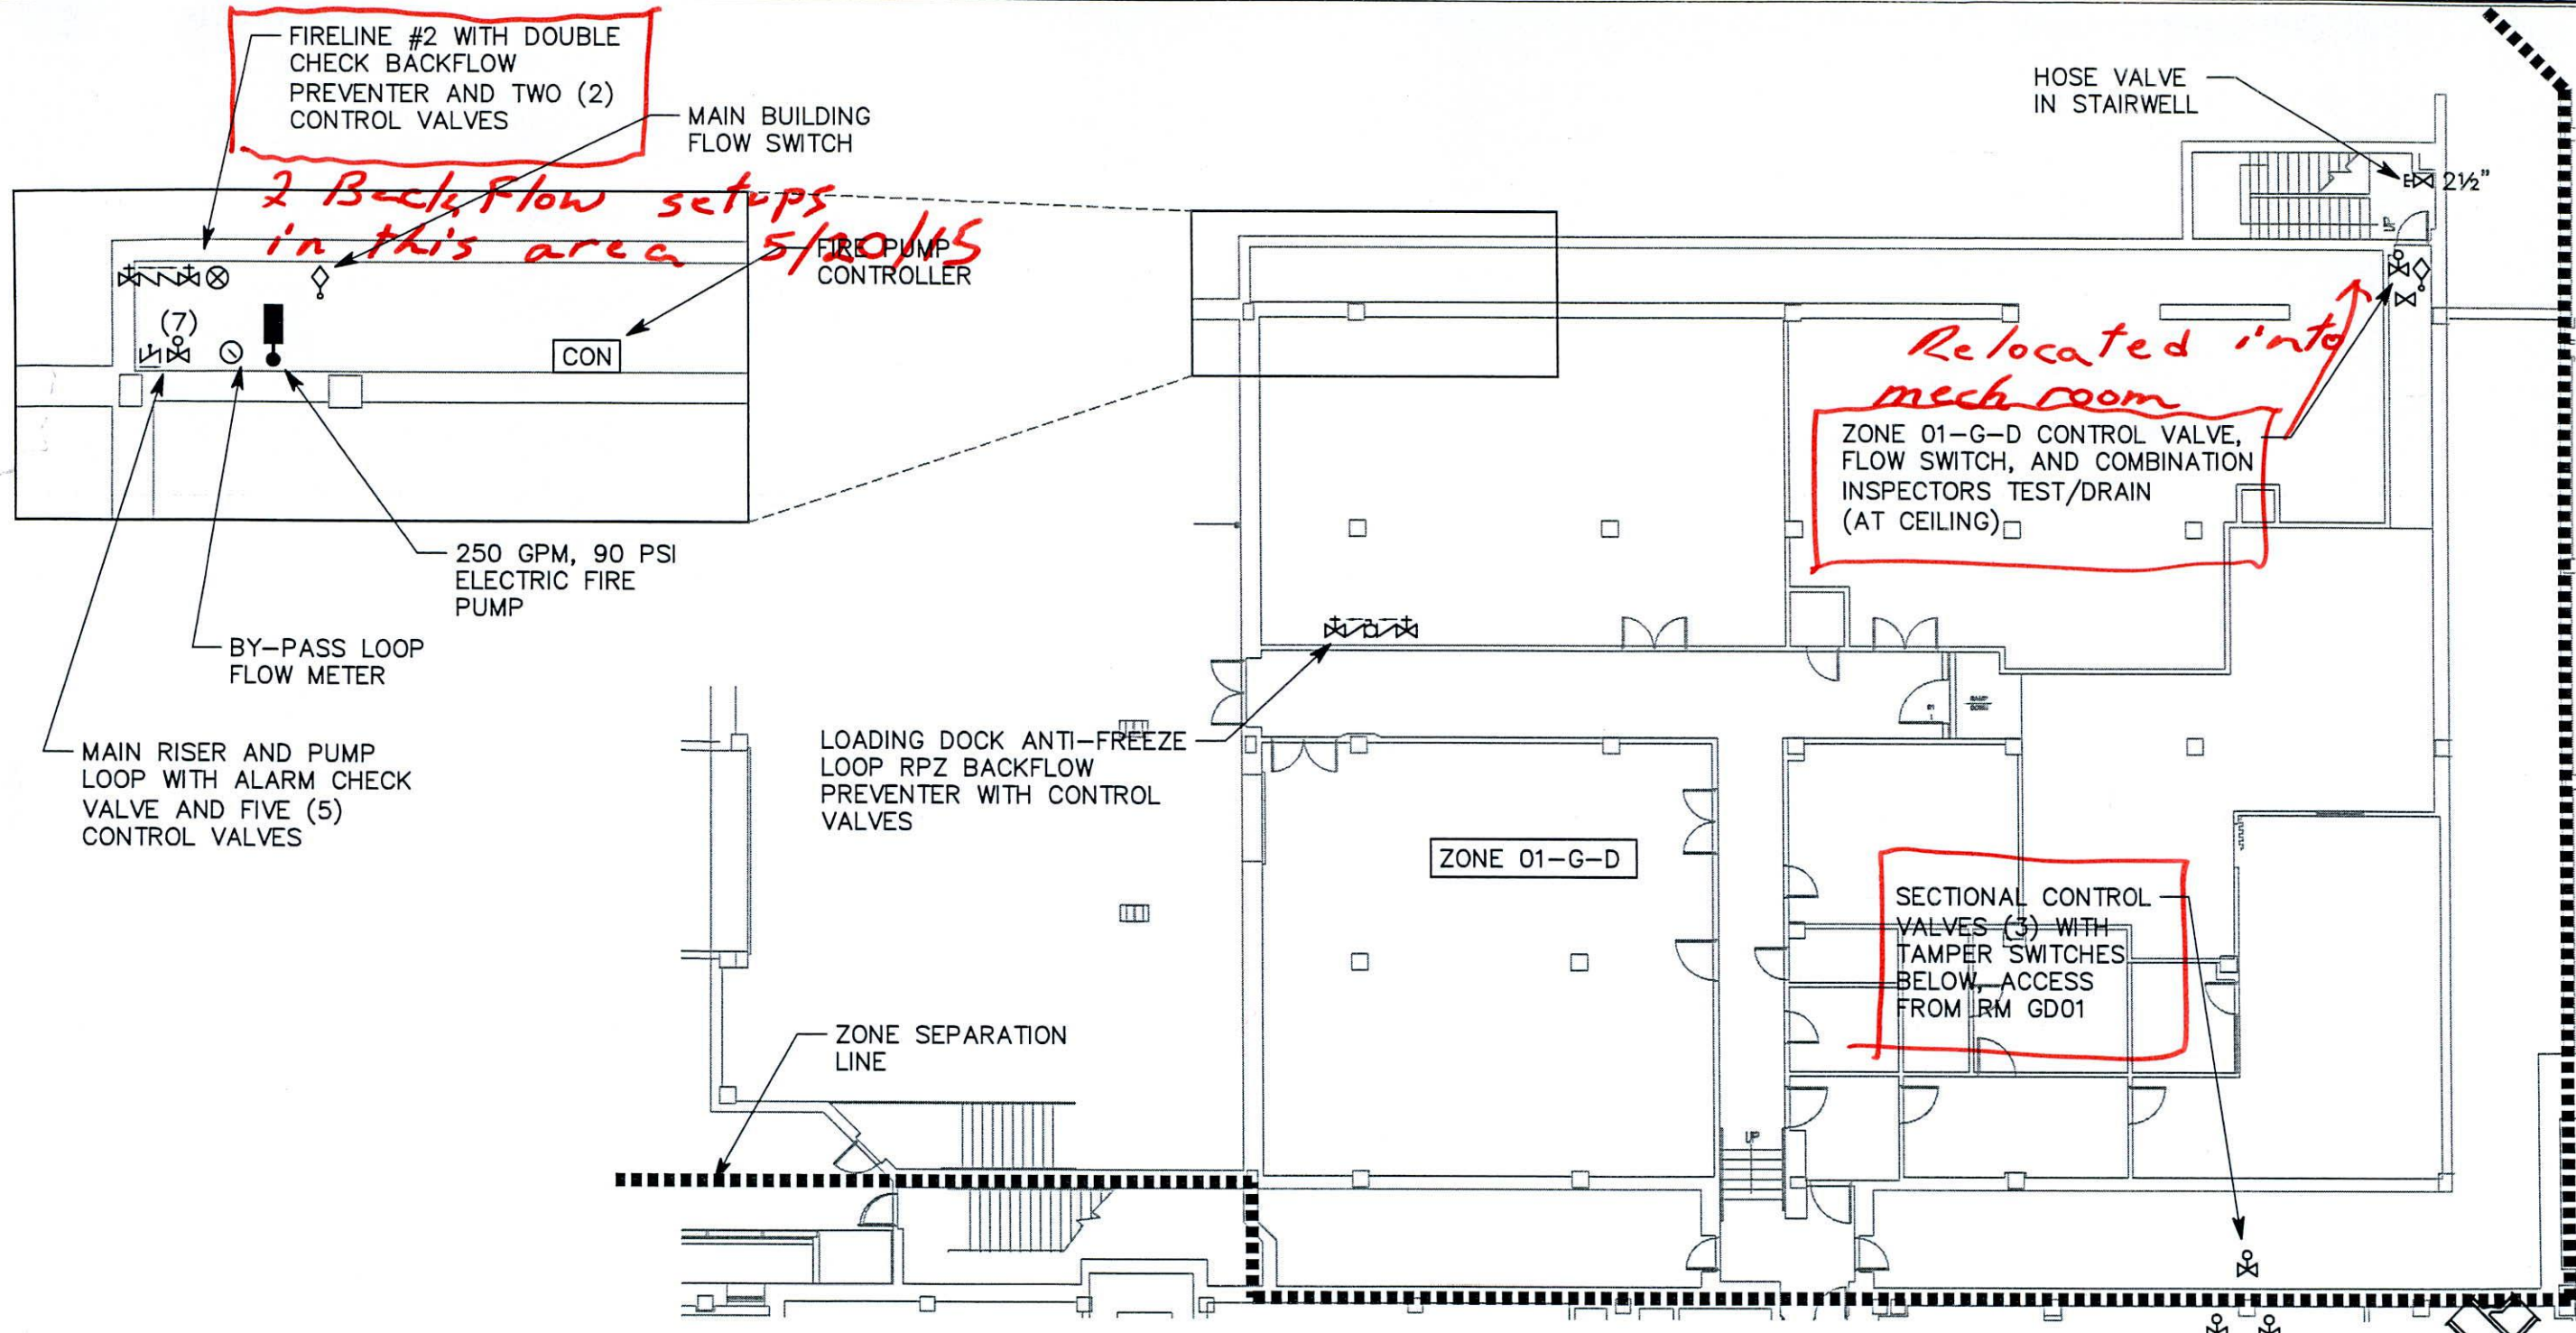

0 8' 16' 32'
SCALE: 1/16" = 1'-0"

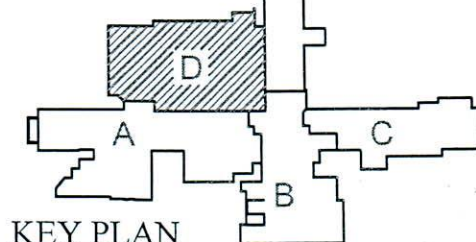

| Revisions | Date |
|-----------|------|
| | |

Consultant

324 South State Street, Suite 400
Salt Lake City, Utah 84111
801.328.5151
800.678.7077
FAX 801.328.5155
www.spectrum-engineers.com

Project Title
CAMPUS WIDE FIRE SPRINKLING TEST STATION
MODIFICATION AND DEFICIENCIES STUDY
Consultant Project No. 20100195
Drawn BXW
Checked JDD

Drawing Title
BUILDING 1
GROUND LEVEL
ZONE D

Date
08.03.2010
Project No.
660-10-110
Building No.
1

DRAWING No.
F.01.1D
Dep. OF XX


AS-BUILT RECORD DRAWINGS
Department of Veterans Affairs