

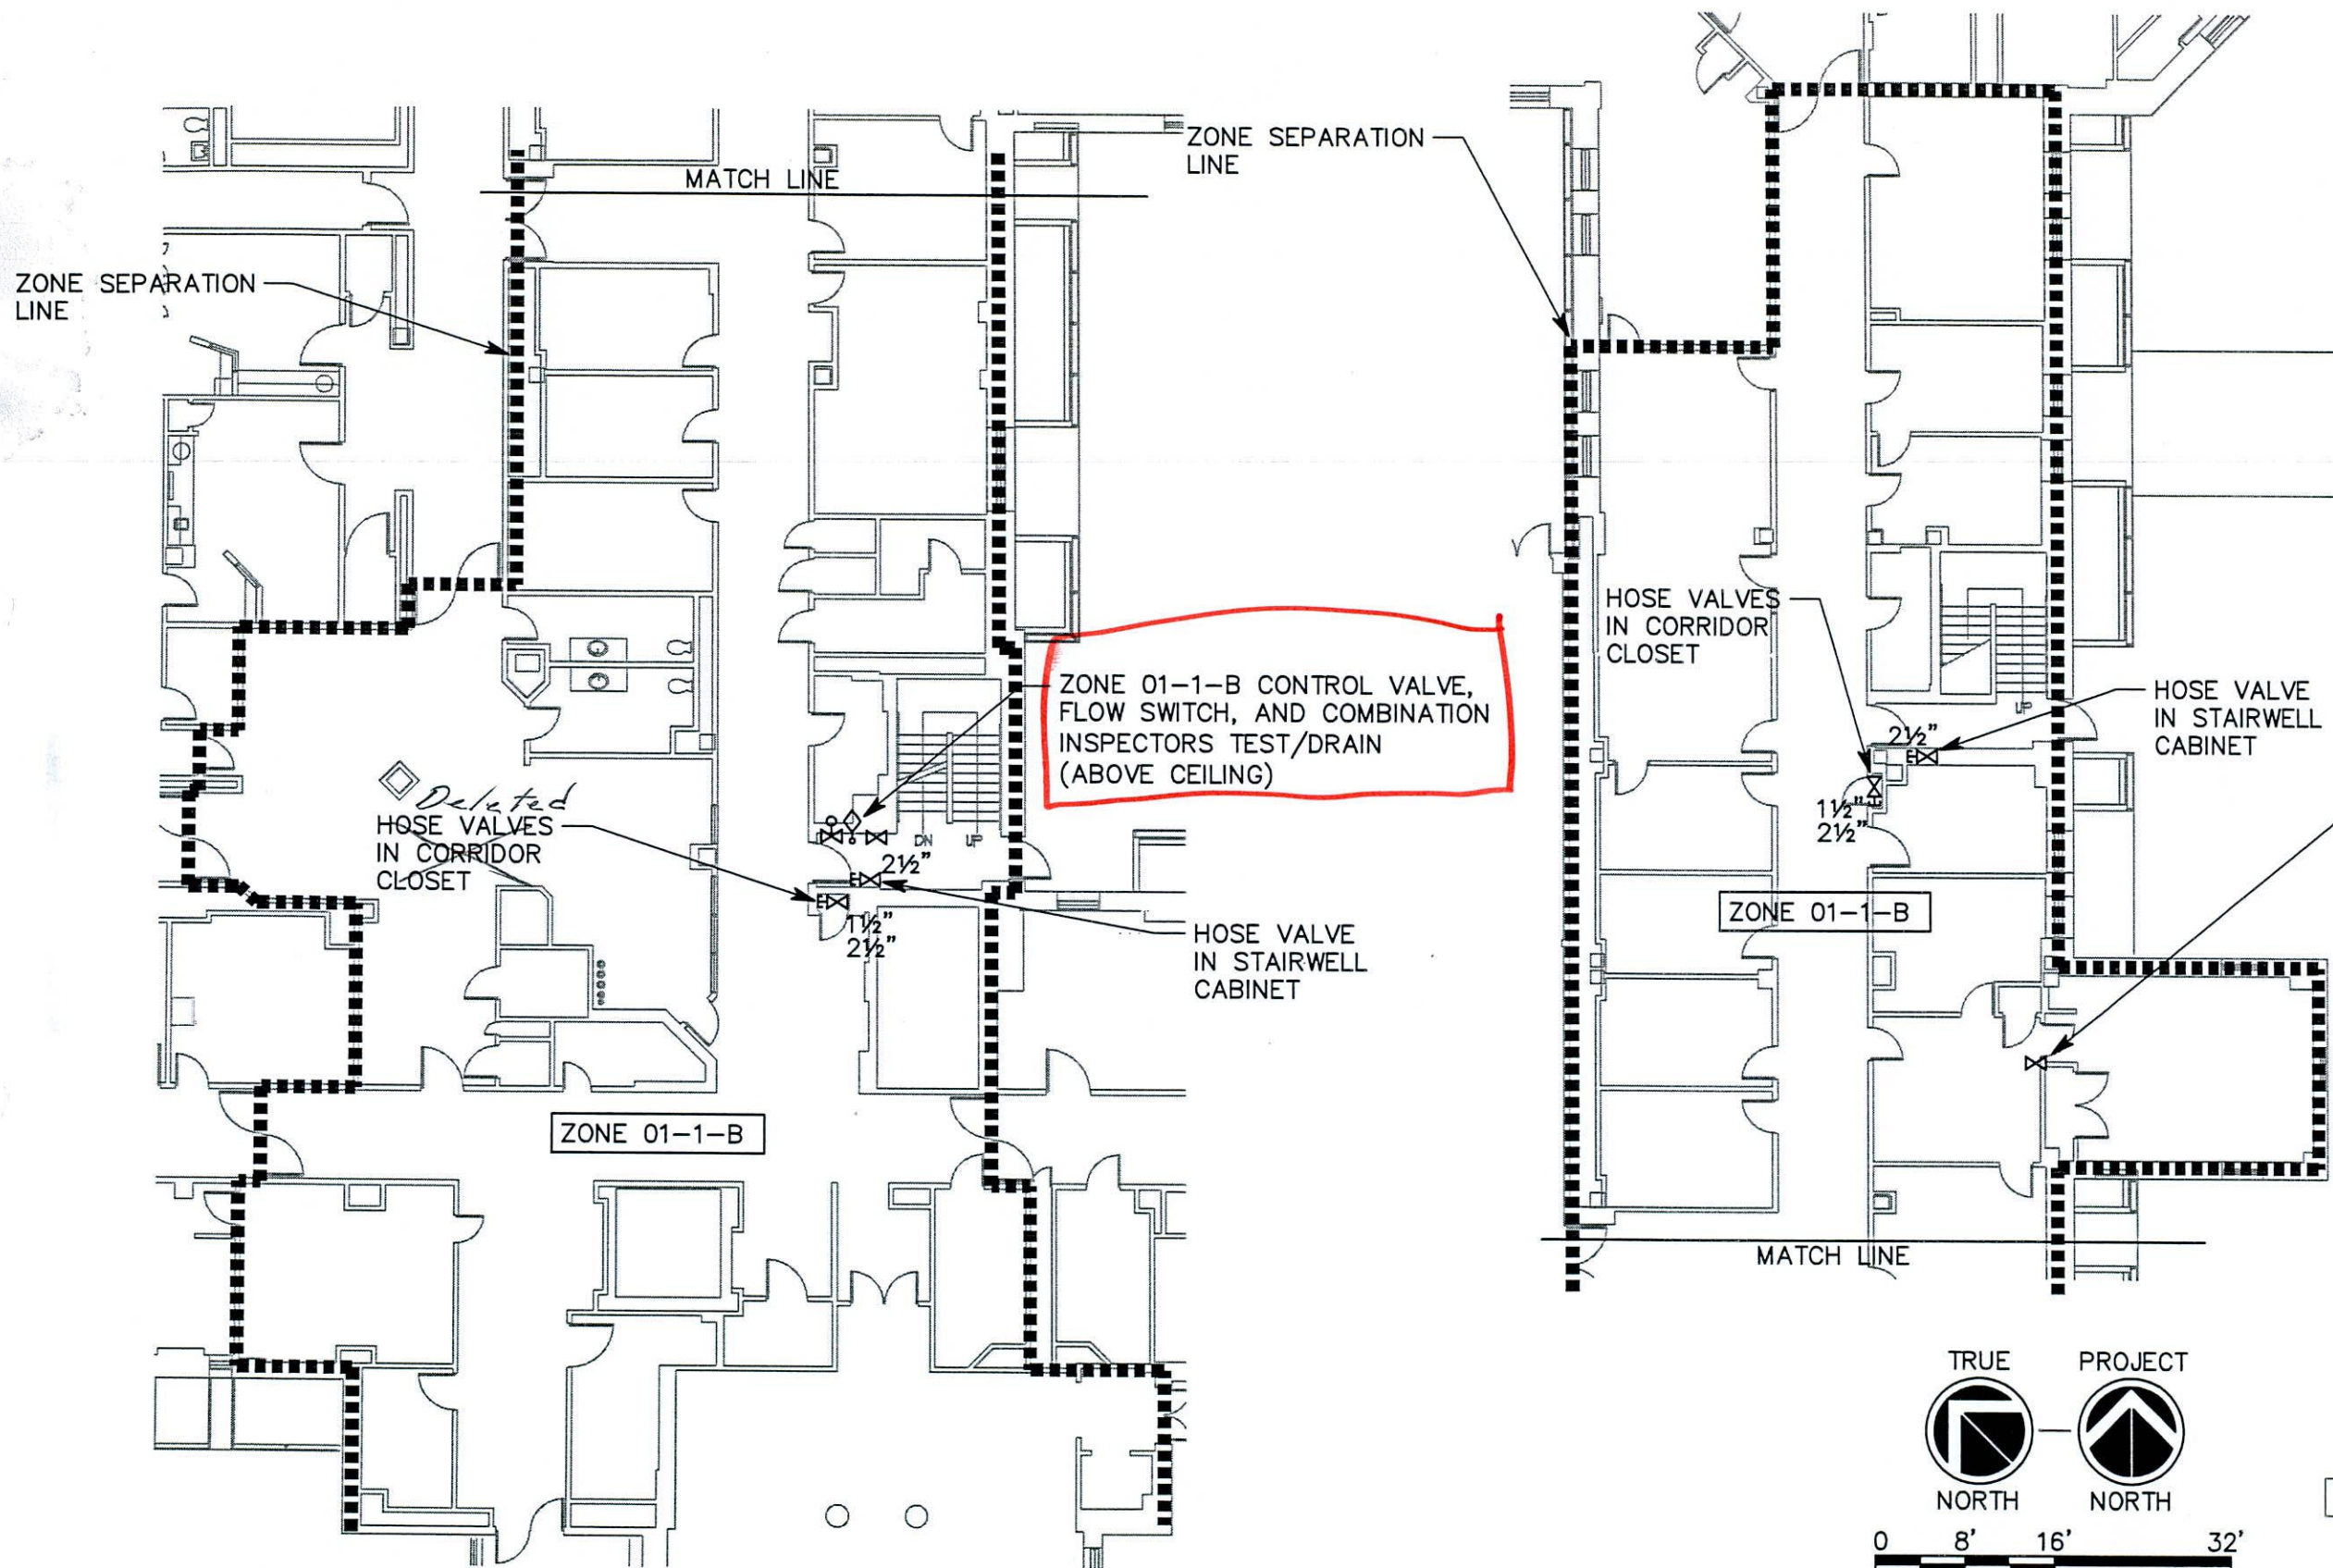


File Name: P:\2010\20100195\Drawings\Bldg 1\Sheet\95F.01.2b2.dwg Last Plotted: 2010/11/01 12:28 PM By: jdd

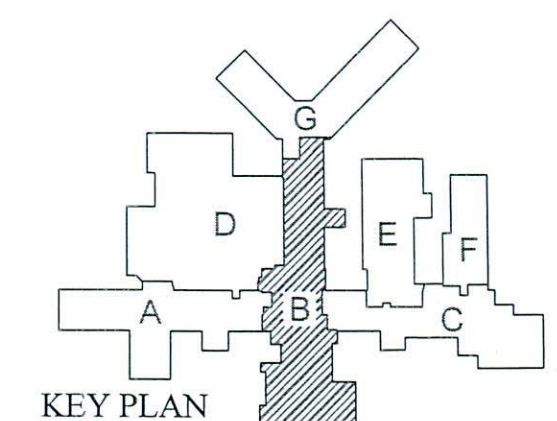

SECTIONAL OS&Y CONTROL VALVE (NO TAMPER SWITCH) IN TUNNEL BELOW, ACCESS FROM RM 1G20

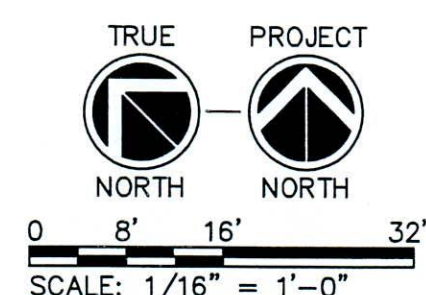

Revisions	Date	By

Consultant

SPECTRUM ENGINEERS
324 South State Street, Suite 400
Salt Lake City, Utah 84111
801.328.5151
800.678.7077
FAX 801.328.5155
www.spectrum-engineers.com

Project Title
CAMPUS WIDE FIRE SPRINKLING TEST STATION
MODIFICATION AND DEFICIENCIES STUDY
Consultant Project No. 20100195
Drawn BXW
Checked JDD

Drawing Title
BUILDING 1
FIRST LEVEL
ZONE B

Date
08.03.2010
Project No.
660-10-110
Building No.
1

DRAWING No.
F.01.2B2
Dep. Of XX


AS-BUILT RECORD DRAWINGS
Department of Veterans Affairs