

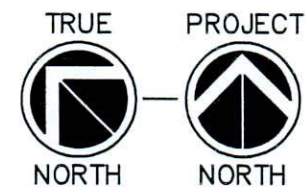


File Name: P:\2010\20100195\Drawings\Bldg 1\3Sheet\9SF.01.2e.dwg Last Plotted: 2010/11/01 12:28 PM By: jdd

ZONE SEPARATION
LINE

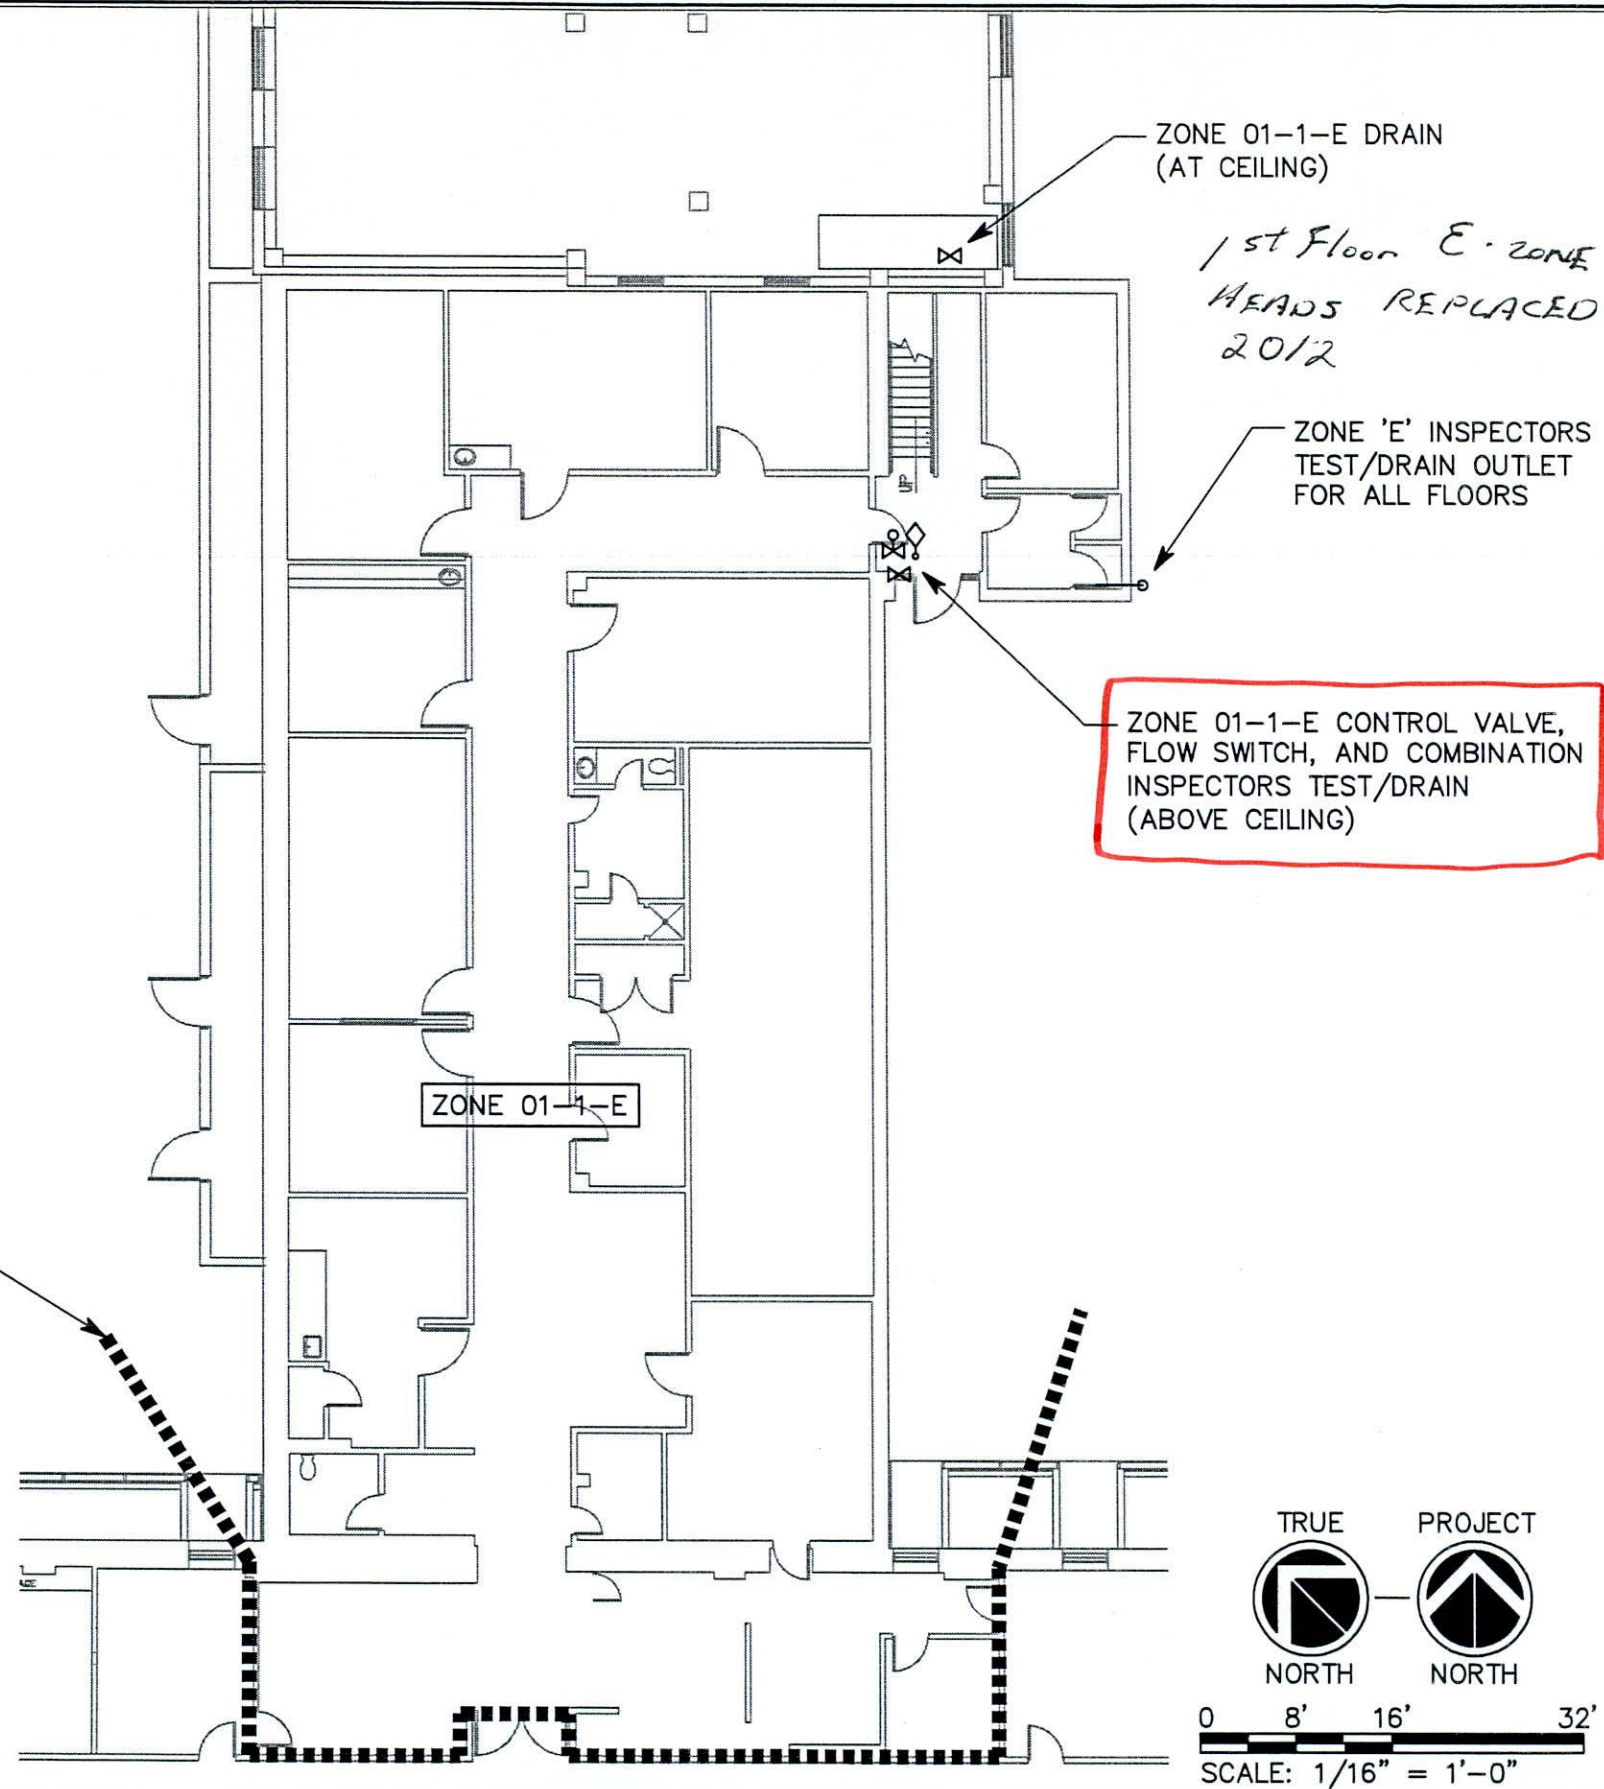

0 8' 16' 32'
SCALE: 1/16" = 1'-0"

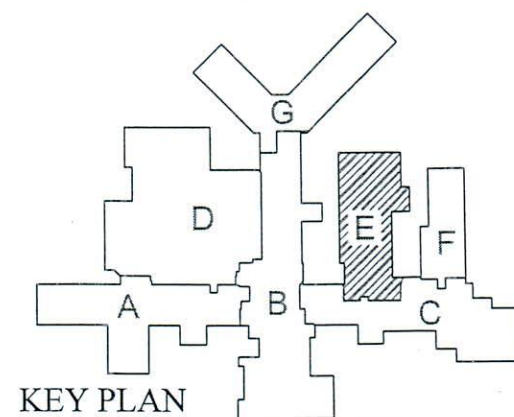

Revisions

Date
Date

Consultant



324 South State Street, Suite 400
Salt Lake City, Utah 84111
801.328.5151
800.678.7077
FAX 801.328.5155
www.spectrum-engineers.com

Project Title
CAMPUS WIDE FIRE SPRINKLING TEST STATION
MODIFICATION AND DEFICIENCIES STUDY

Consultant Project No. 20100195

Drawn BXW

Checked JDD

Drawing Title

BUILDING 1
FIRST LEVEL
ZONE E

Date
08.03.2010

Project No.
660-10-110

Building No.
1

DRAWING No.

F.01.2E

Drawn of XX



AS-BUILT RECORD DRAWINGS

Department of
Veterans Affairs