


File Name: P:\2010\20100195\Drawings\Bldg 1\3Sheet\95F.01.21.dwg Last Plotted: 2010/11/01 @ 12:28 PM By: jdd

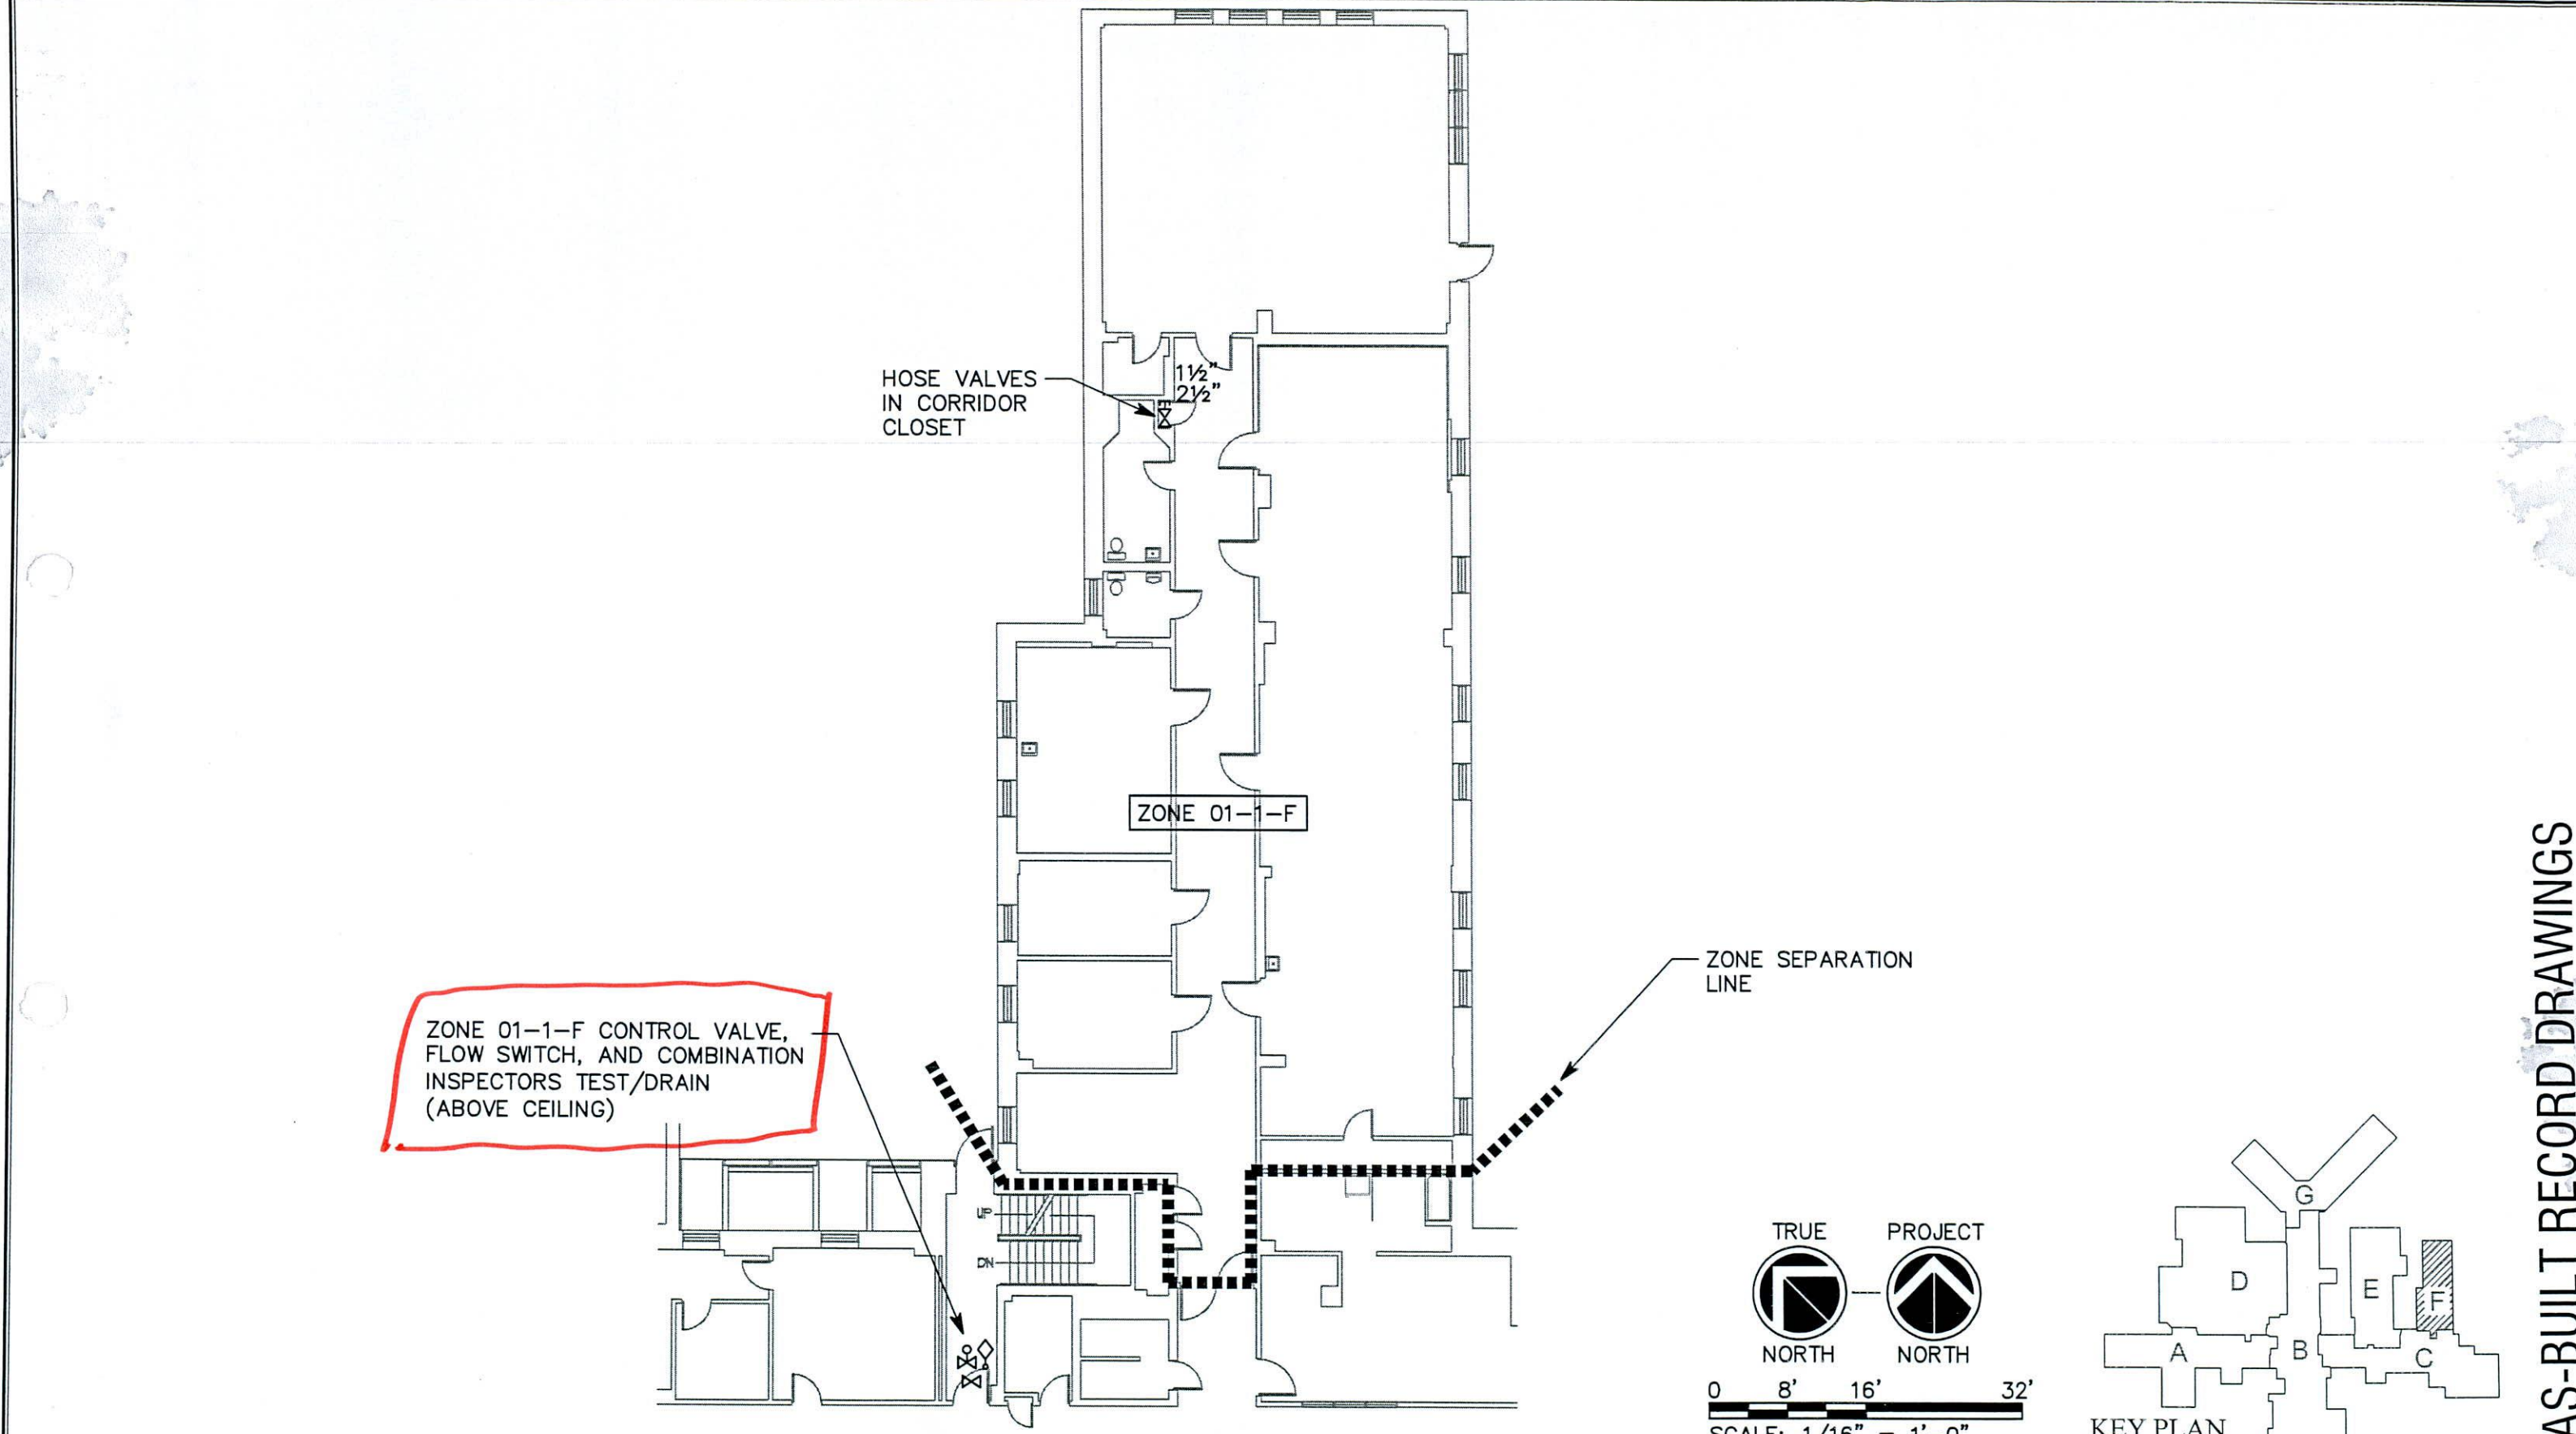

Revisions		<div>Consultant</div> <div><div>SPECTRUM ENGINEERS</div></div> <div>324 South State Street, Suite 400 Salt Lake City, Utah 84111 801.328.5151 800.678.7077 FAX 801.328.5155 www.spectrum-engineers.com</div>	Project Title CAMPUS WIDE FIRE SPRINKLING TEST STATION MODIFICATION AND DEFICIENCIES STUDY		Drawing Title BUILDING 1 FIRST LEVEL ZONE F	Date 08.03.2010	Project No. 660-10-110	Building No. 1	DRAWING No. F.01.2F Dep. of XX 	Department of Veterans Affairs
	Date		Consultant Project No. 20100195	Drawn BXW						
	Date									

AS-BUILT RECORD DRAWINGS