

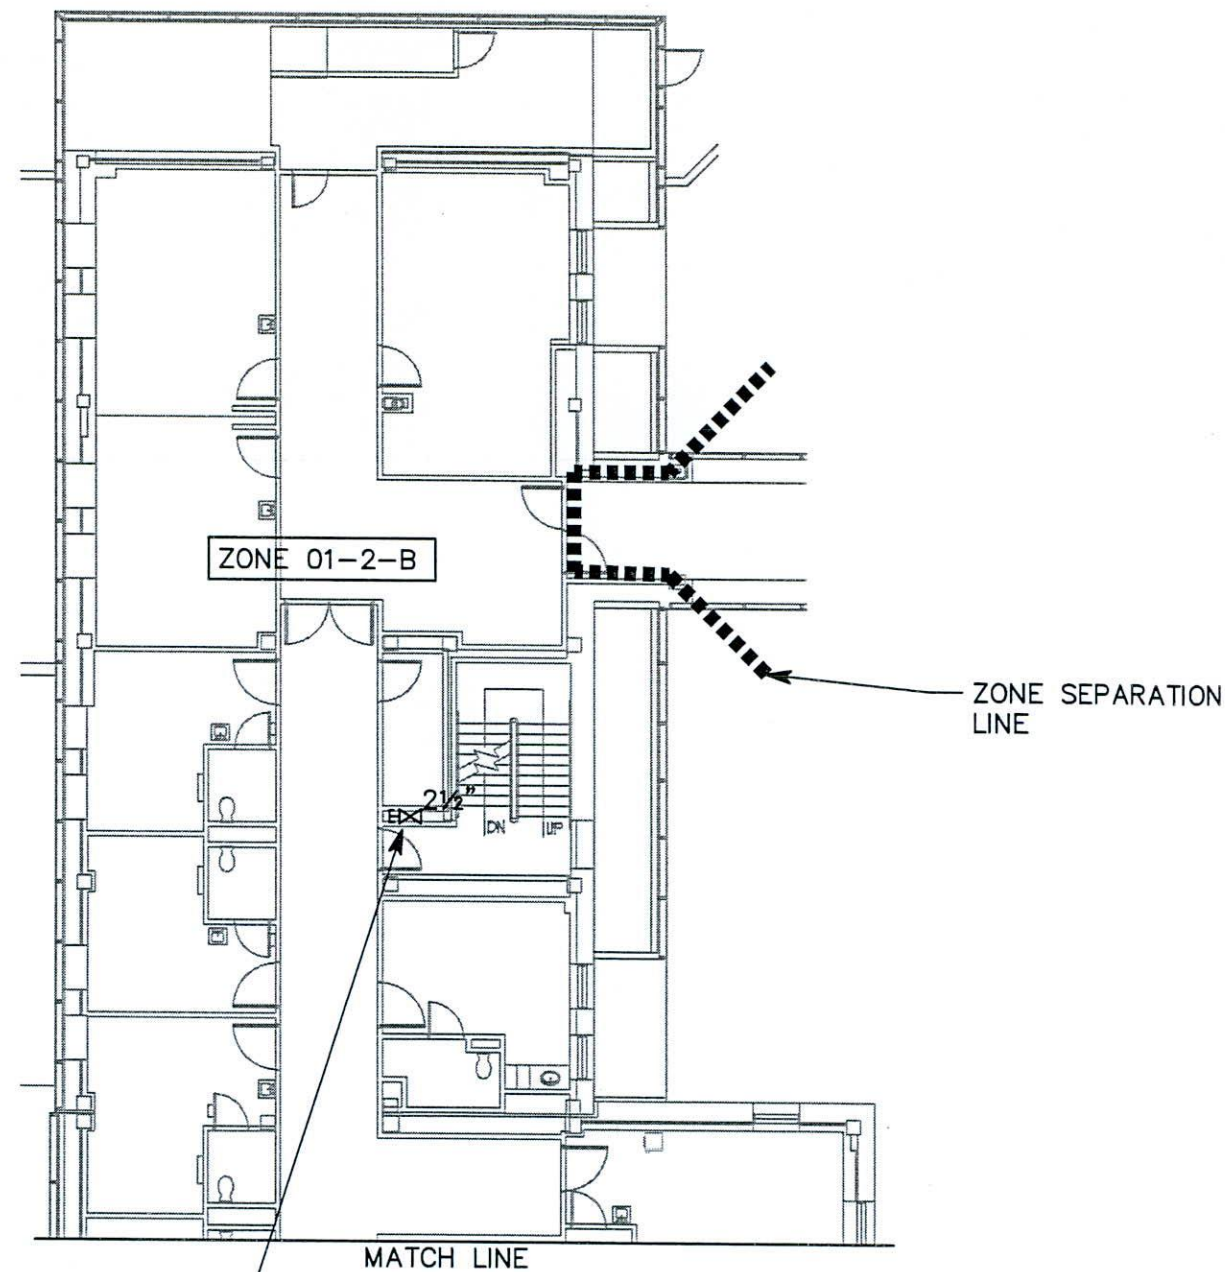
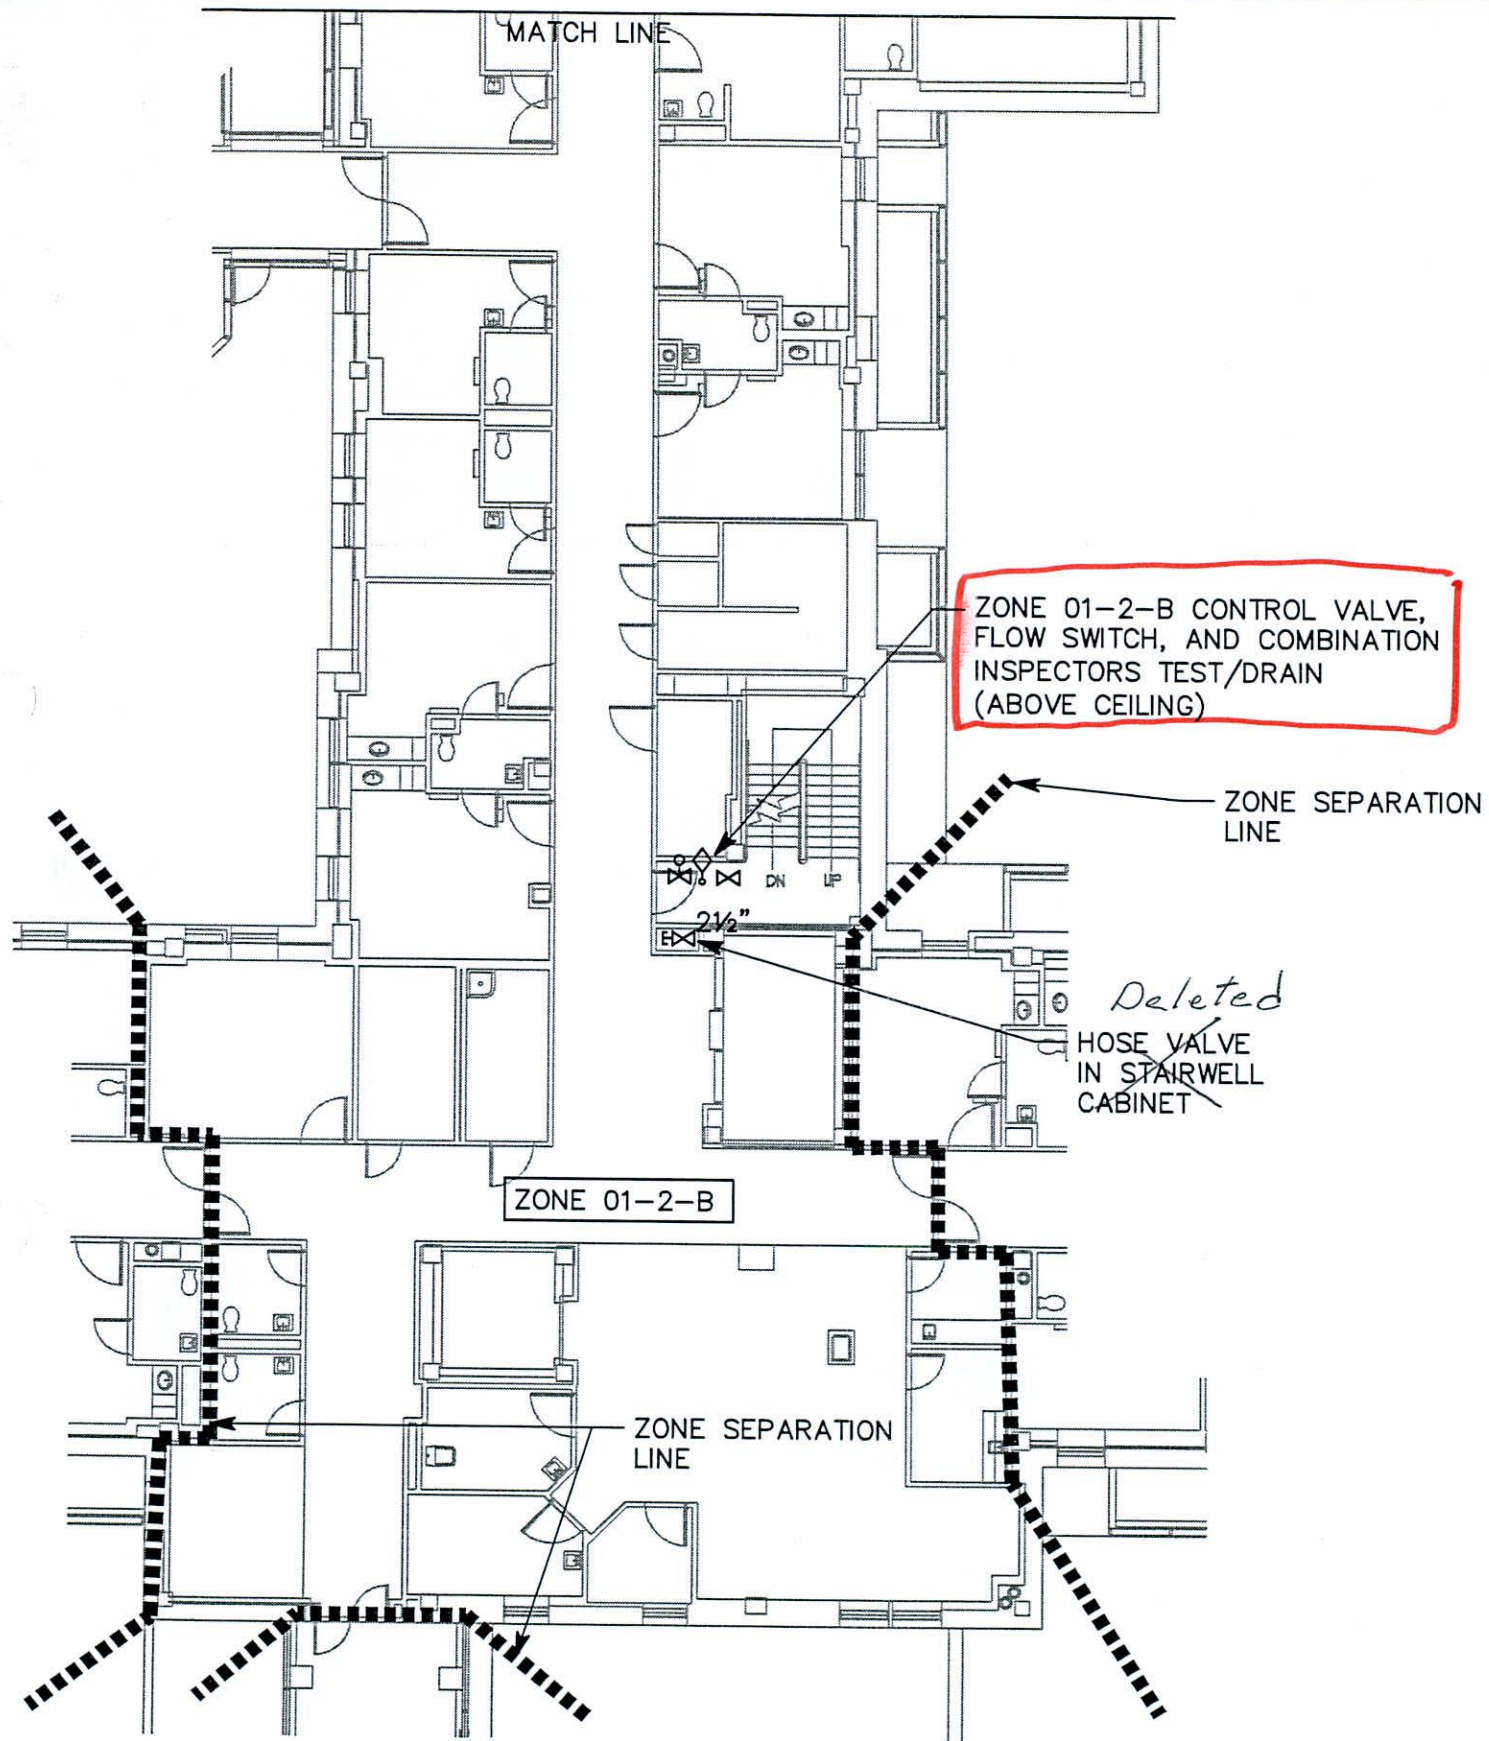


File Name: P:\2010\20100195\Drawings\Bldg 1\3Sheet\95F.01.3b.dwg Plot Date: 2010/11/01 12:28 PM By: jdd

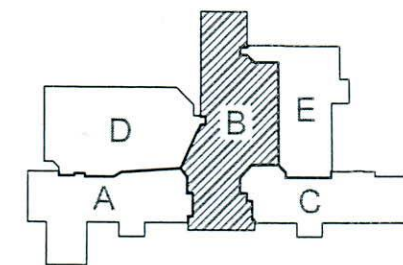

HOSE VALVE
(PRESSURE
REGULATING)
IN STAIRWELL
CABINET

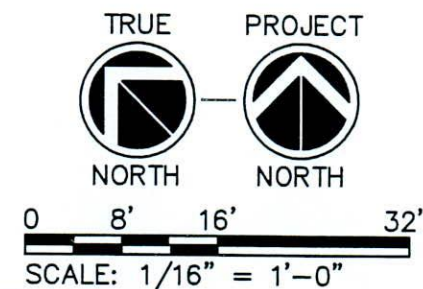

KEY PLAN

Revisions	Date



324 South State Street, Suite 400
Salt Lake City, Utah 84111
801.328.5151
800.678.7077
FAX 801.328.5155
www.spectrum-engineers.com

Project Title
CAMPUS WIDE FIRE SPRINKLING TEST STATION
MODIFICATION AND DEFICIENCIES STUDY

Consultant Project No. 20100195

Drawn BXW Checked JDD

Drawing Title
BUILDING 1
SECOND LEVEL
ZONE B

Date
08.03.2010

Project No.
660-10-110

Building No.
1

Drawing No.
F.01.3B

Dep. of XX

VAMC
TO QUALITY

Department of
Veterans Affairs

AS-BUILT RECORD DRAWINGS