
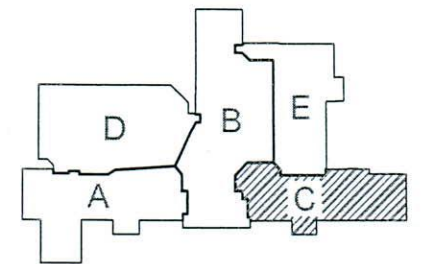
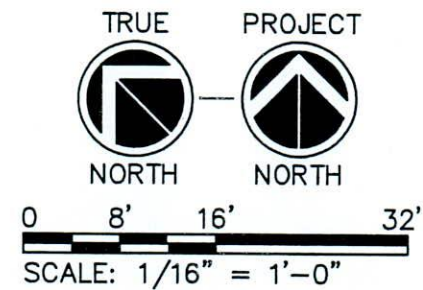


File Name: P:\2010\2010010195\1Drawings\Bldg 1\3Sheet\95F.01.3c.dwg Last Plotted: 2010/11/01 12:27 PM By: jdd

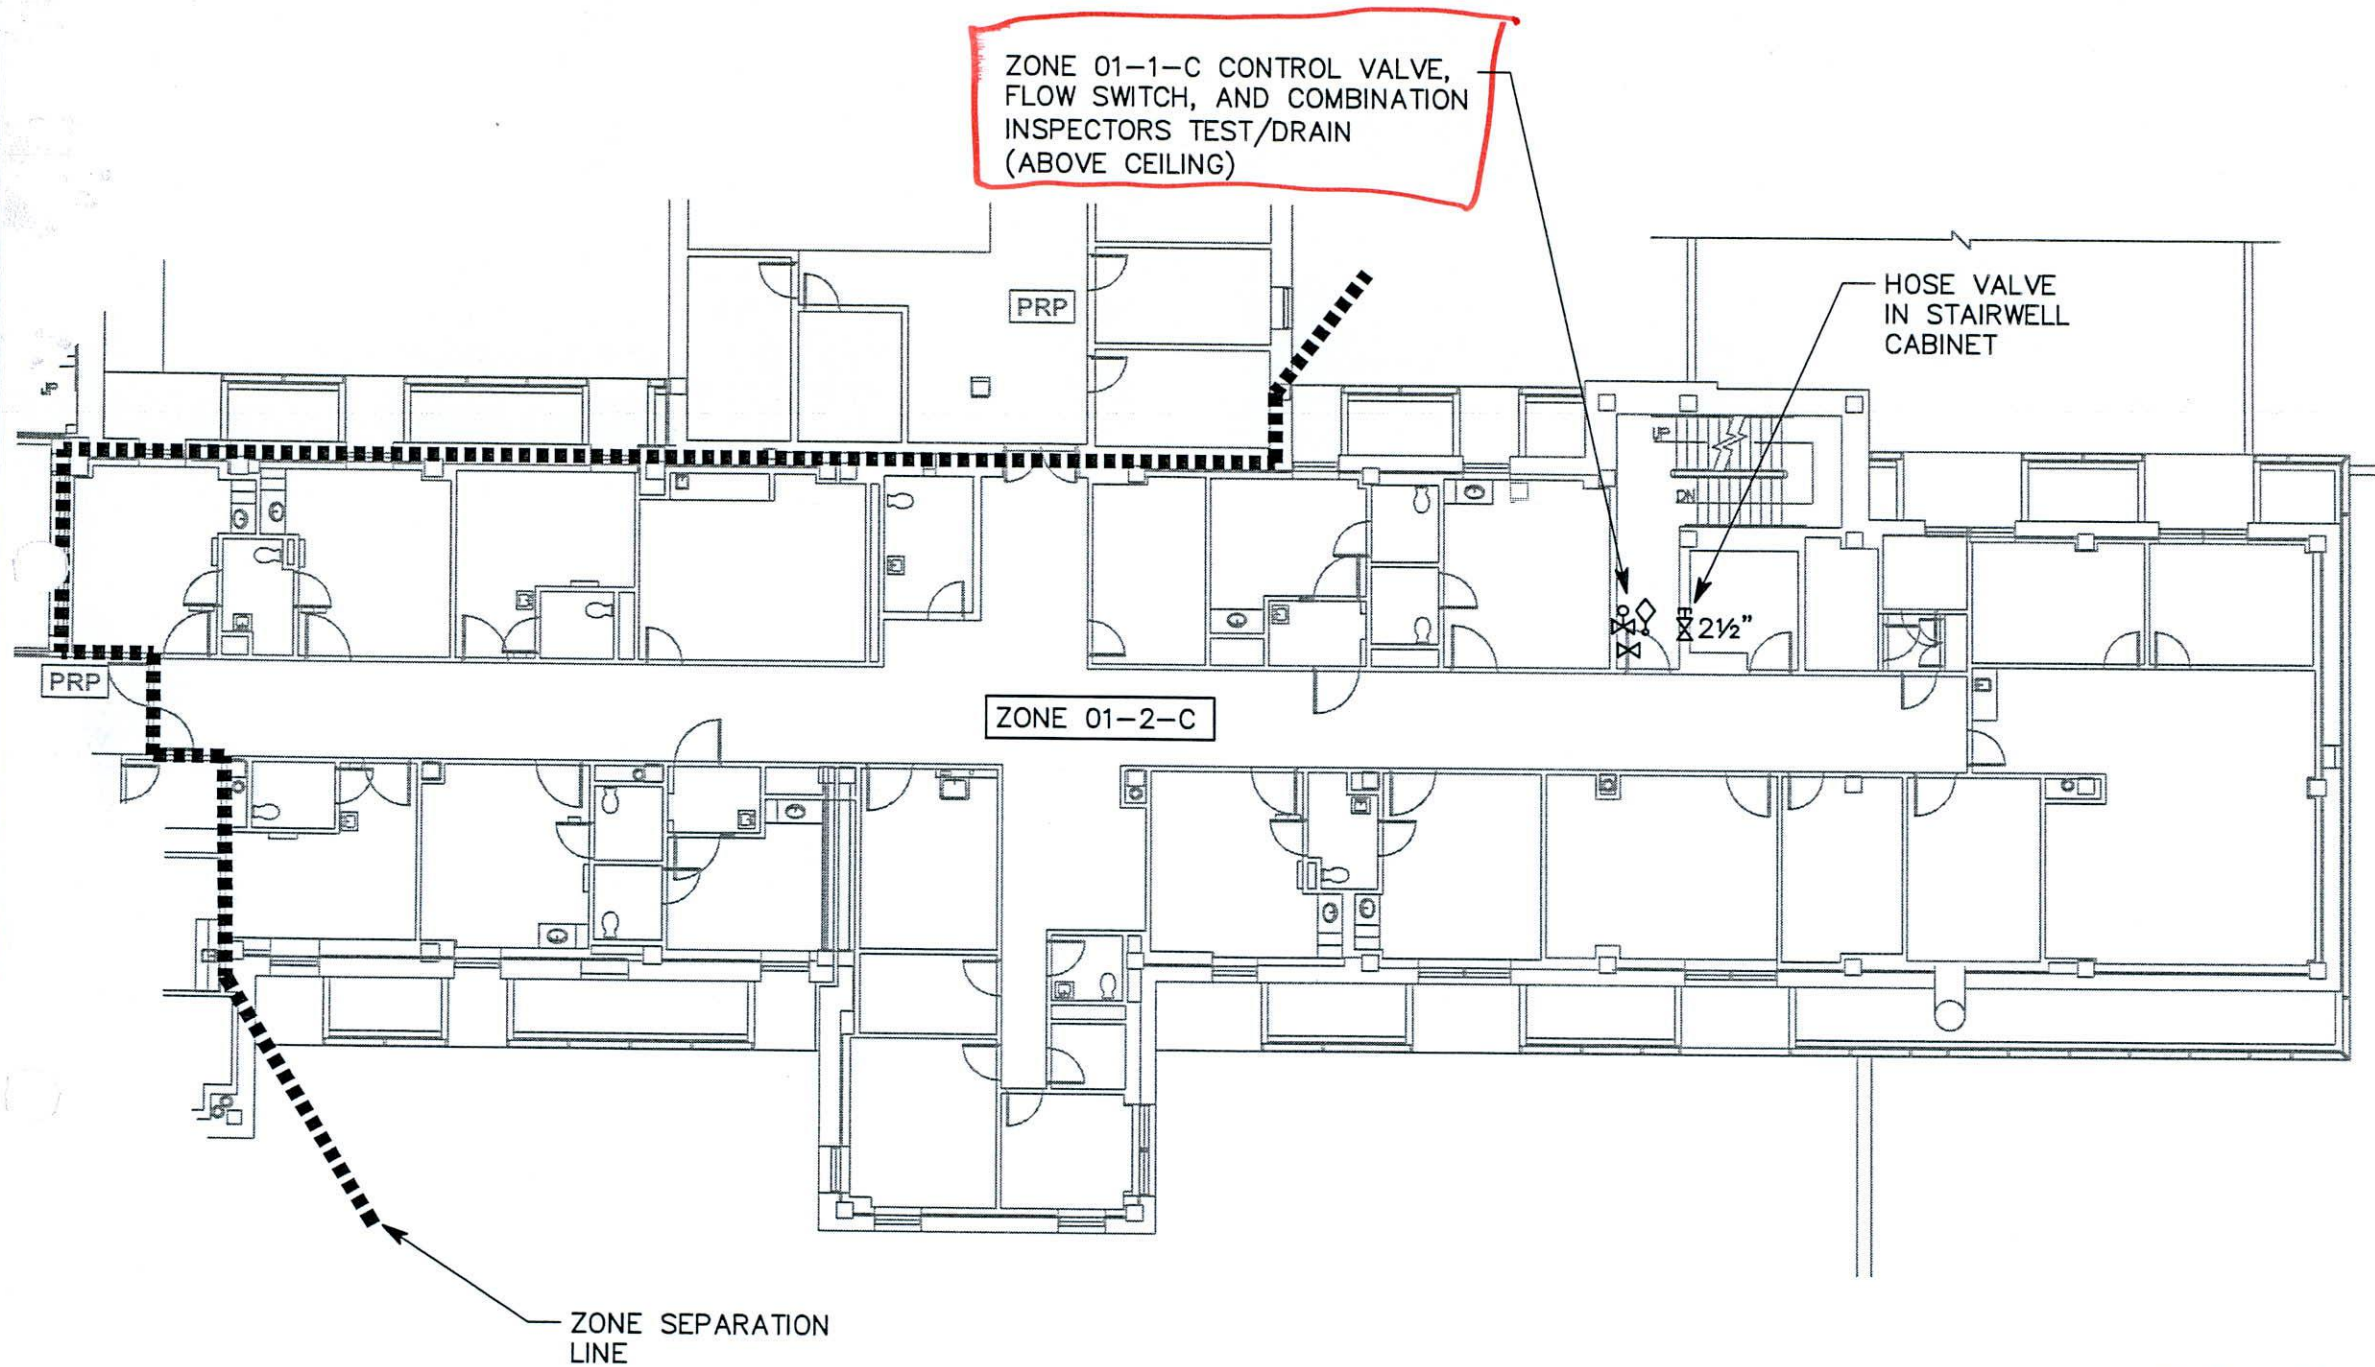

KEY PLAN

Revisions	Date

Consultant

324 South State Street, Suite 400
Salt Lake City, Utah 84111
801.328.5151
800.678.7077
FAX 801.328.5155
www.spectrum-engineers.com

Project Title
CAMPUS WIDE FIRE SPRINKLING TEST STATION
MODIFICATION AND DEFICIENCIES STUDY

Consultant Project No. 20100195

Drawn BXW Checked JDD

Drawing Title
BUILDING 1
SECOND LEVEL
ZONE C

Date
08.03.2010

Project No.
660-10-110

Building No.
1

DRAWING No.
F.01.3C

Dep. of XX



Department of
Veterans Affairs

AS-BUILT RECORD DRAWINGS