
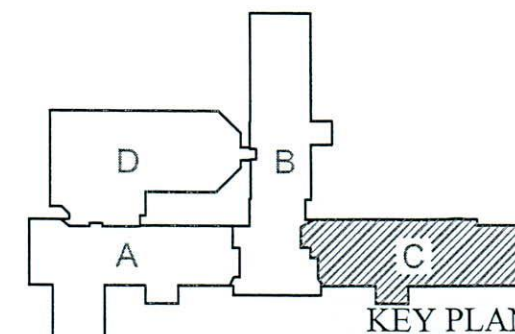


LEGEND	
	CONTROL VALVE
	FLOW SWITCH
	IT AND/OR DRAIN VALVE
	HOSE VALVE
	IT AND/OR DRAIN OUTLET
	POST INDICATOR VALVE

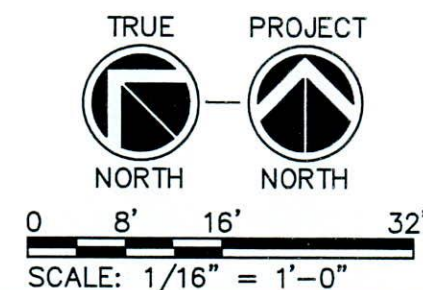

Revisions	Date

Consultant

 324 South State Street, Suite 400
 Salt Lake City, Utah 84111
 801.328.5151
 800.678.7077
 FAX 801.328.5155
 www.spectrum-engineers.com

Project Title
 CAMPUS WIDE FIRE SPRINKLING TEST STATION
 MODIFICATION AND DEFICIENCIES STUDY
 Consultant Project No. 20100195
 Drawn BXW
 Checked JDD

Drawing Title
 BUILDING 1
 THIRD LEVEL
 ZONE C

Date
 08.03.2010
 Project No.
 660-10-110
 Building No.
 1

DRAWING No.
 F.01.4C
 Dep. of XX

AS-BUILT RECORD DRAWINGS
 Department of Veterans Affairs