
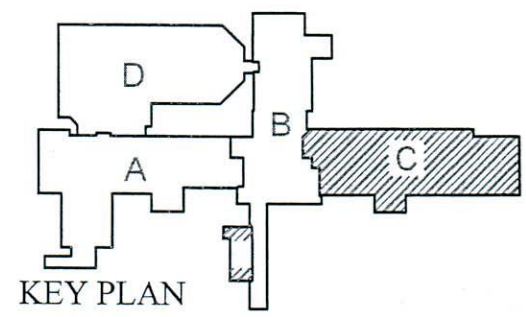
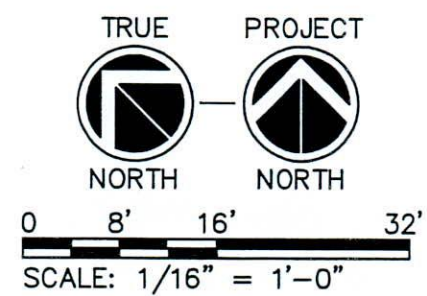


File Name: P:\2010\20100195\Drawings\Bldg 1\3Sheet\95F-01.5c.dwg Last Plotted: 2010/11/01 12:26 PM By: jdd

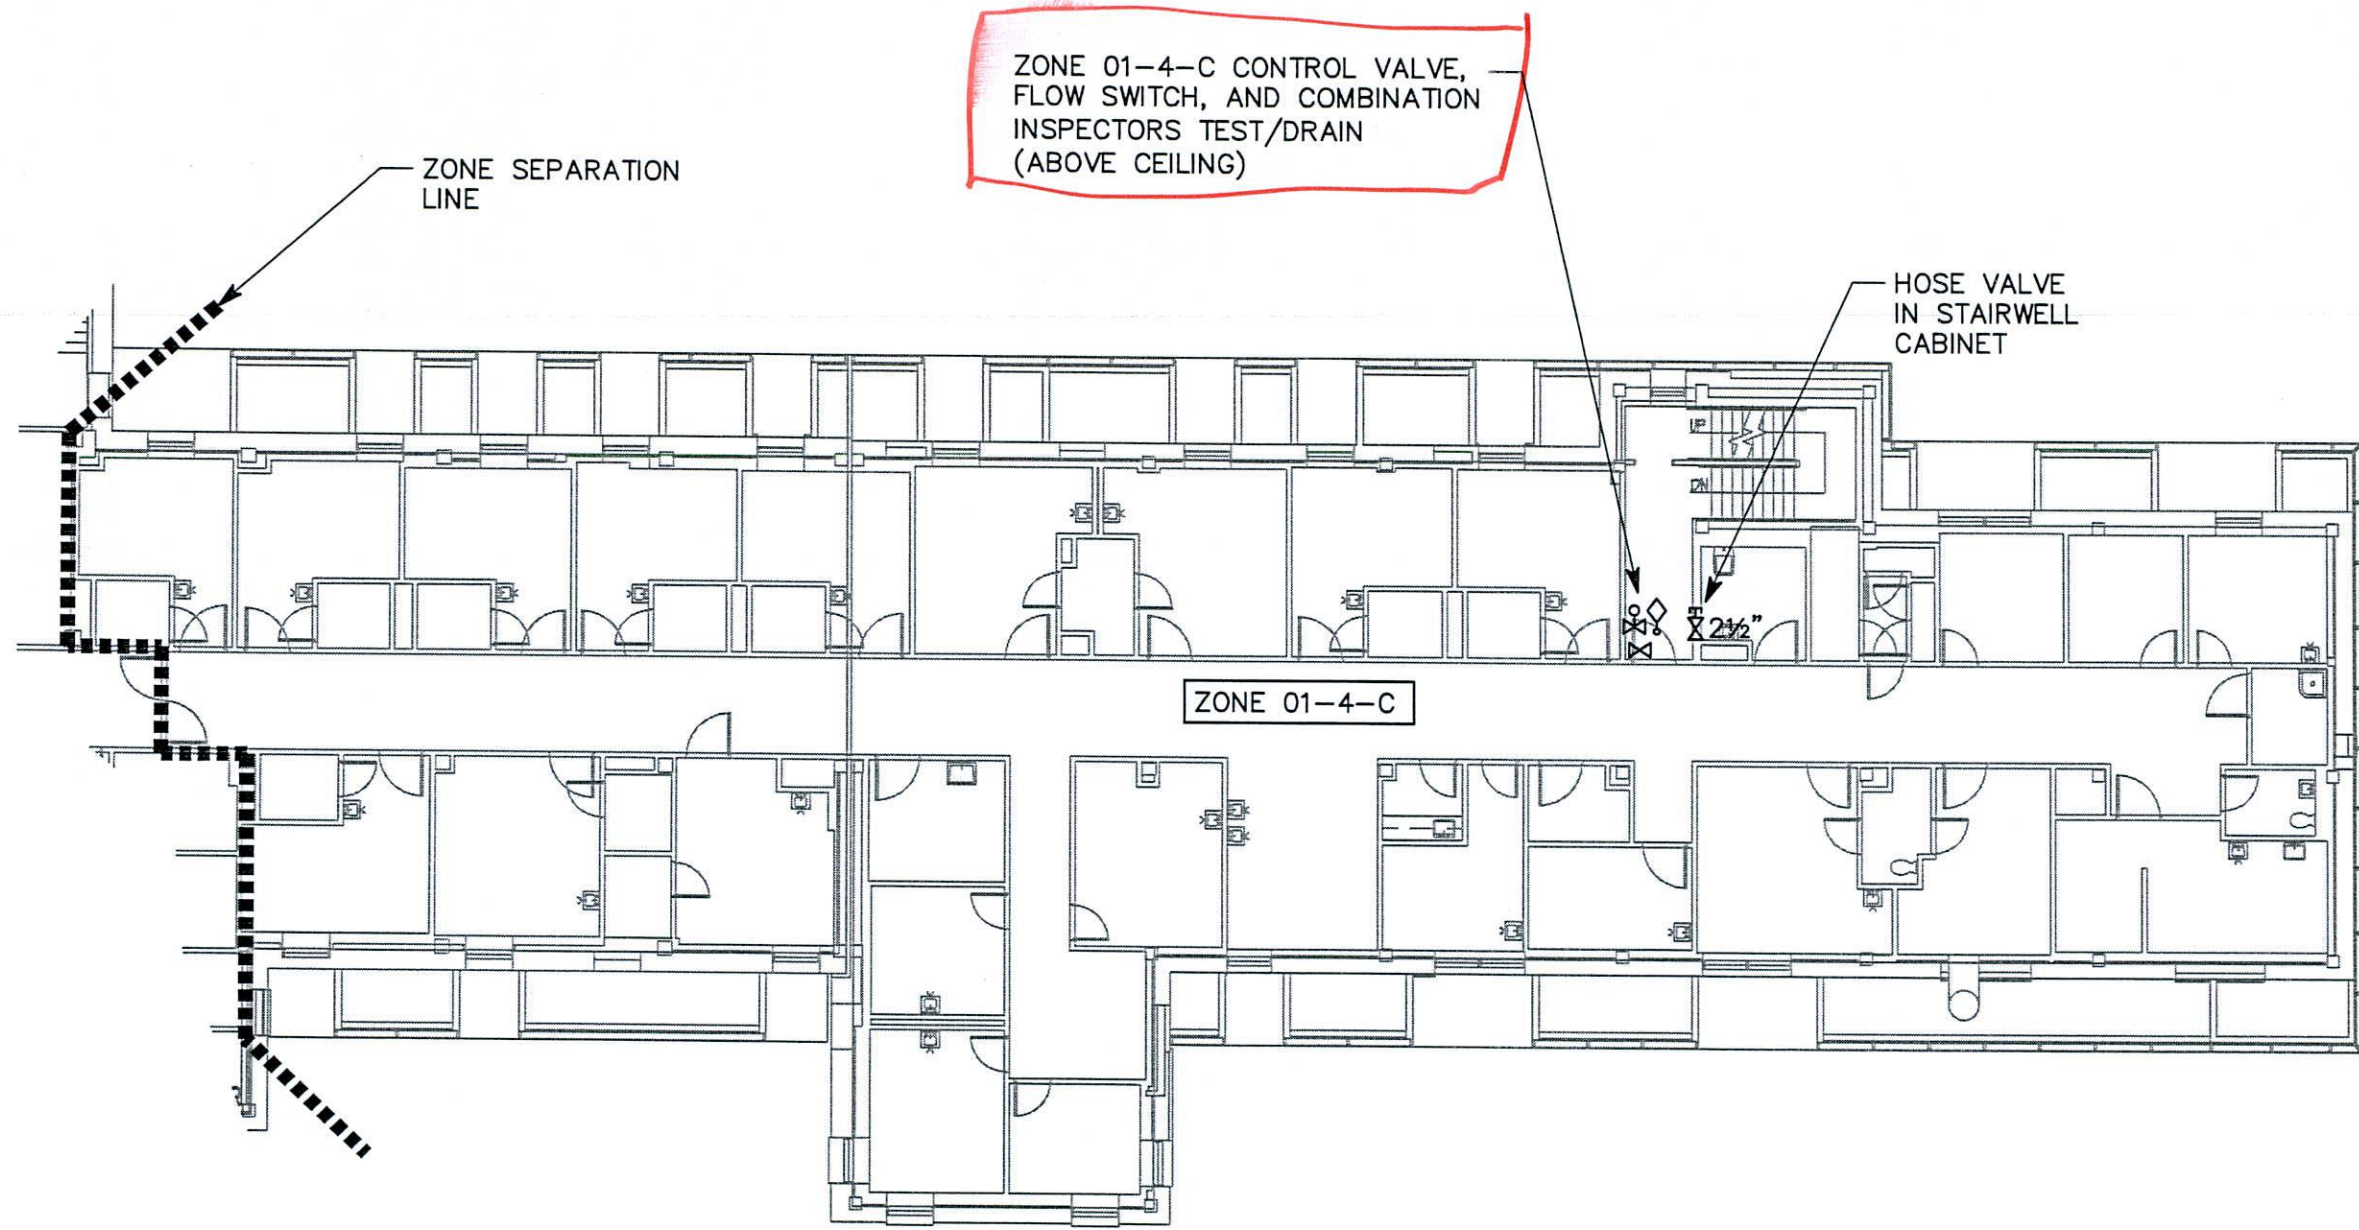

Revisions	
Date	

Consultant

SPECTRUM
ENGINEERS
324 South State Street, Suite 400
Salt Lake City, Utah 84111
801.328.5151
800.678.7077
FAX 801.328.5155
www.spectrum-engineers.com

Project Title
CAMPUS WIDE FIRE SPRINKLING TEST STATION
MODIFICATION AND DEFICIENCIES STUDY
Consultant Project No. 20100195
Drawn BXW
Checked JDD

Drawing Title
BUILDING 1
FOURTH LEVEL
ZONE C

Date
08.03.2010
Project No.
660-10-110
Building No.
1

DRAWING No.
F.01.5C
Dep. of XX


AS-BUILT RECORD DRAWINGS
Department of Veterans Affairs