


File Name: P:\2010\20100195\Drawings\Bldg 2\Sheet\95F.02.2a.dwg Last Plotted: 2010/11/01 @ 12:25 PM By: jdd



Revisions

Date  
Date

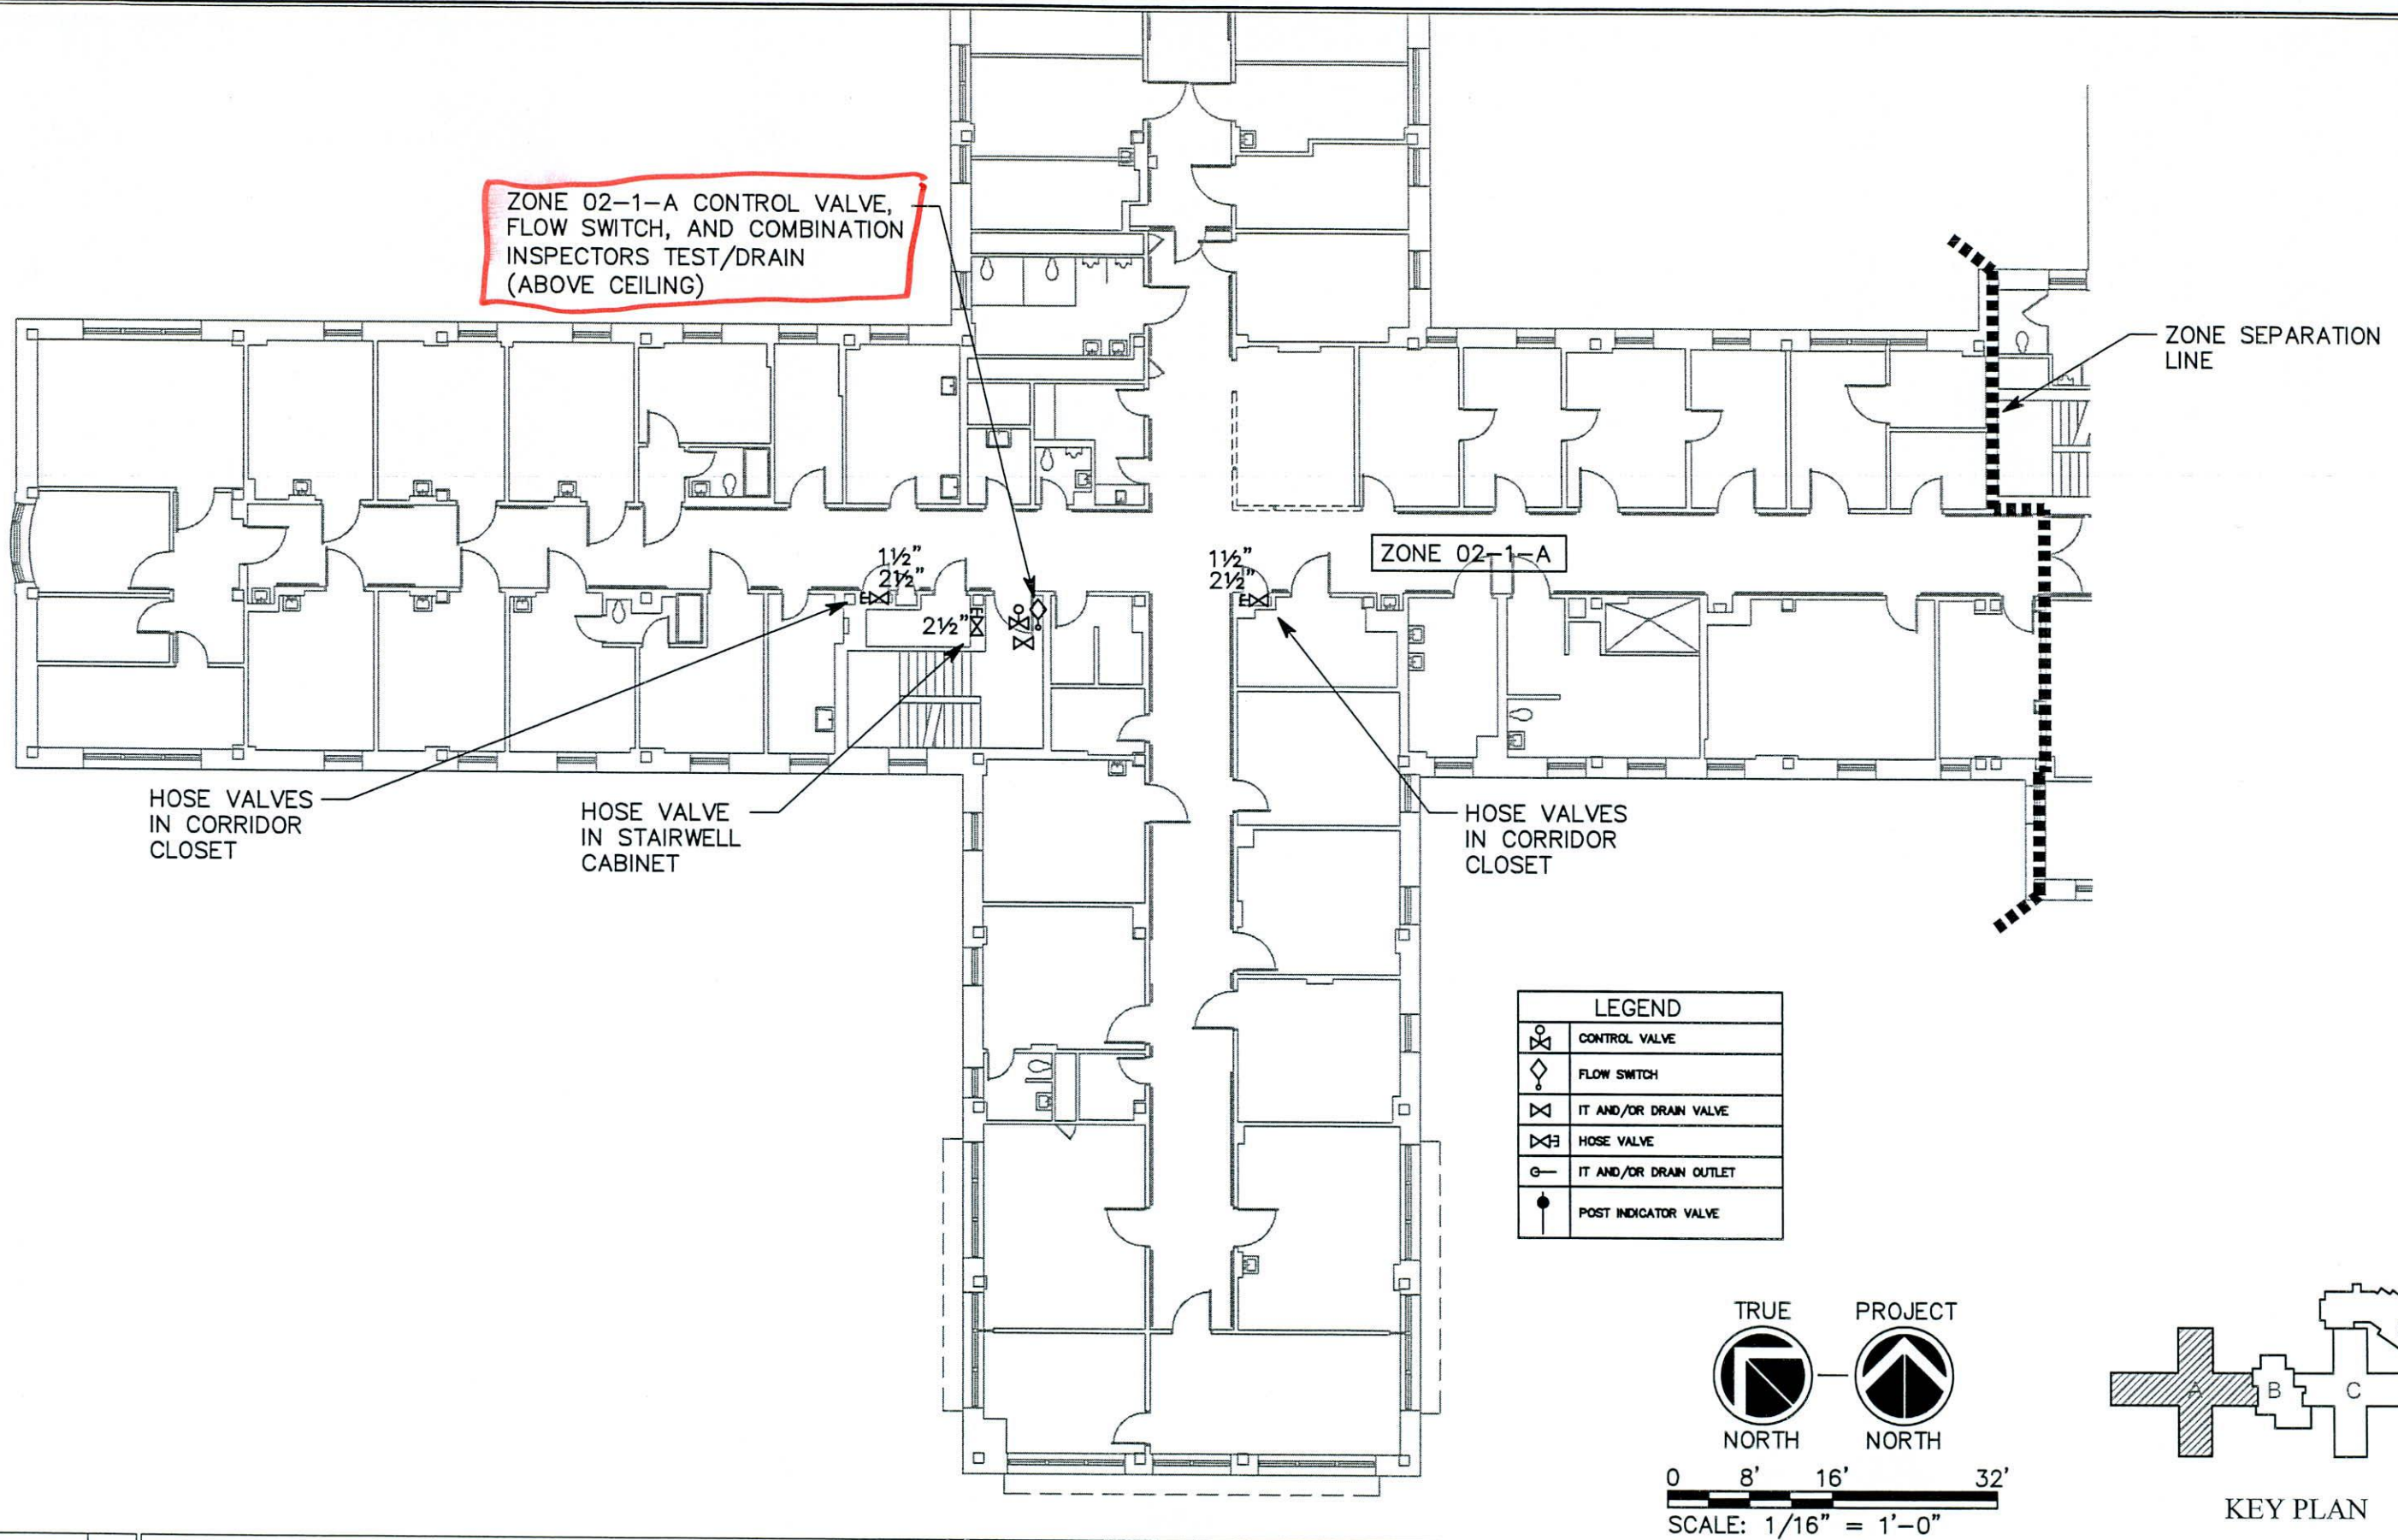

324 South State Street, Suite 400  
Salt Lake City, Utah 84111  
801.328.5151  
800.678.7077  
FAX 801.328.5155  
www.spectrum-engineers.com

Project Title  
CAMPUS WIDE FIRE SPRINKLING TEST STATION  
MODIFICATION AND DEFICIENCIES STUDY

Consultant Project No. 20100195

Drawn BXW

Checked JDD

Drawing Title  
BUILDING 2  
FIRST LEVEL  
ZONE A

Date  
08.03.2010  
Project No.  
660-10-110  
Building No.  
2



AS-BUILT RECORD DRAWINGS

Department of  
Veterans Affairs