

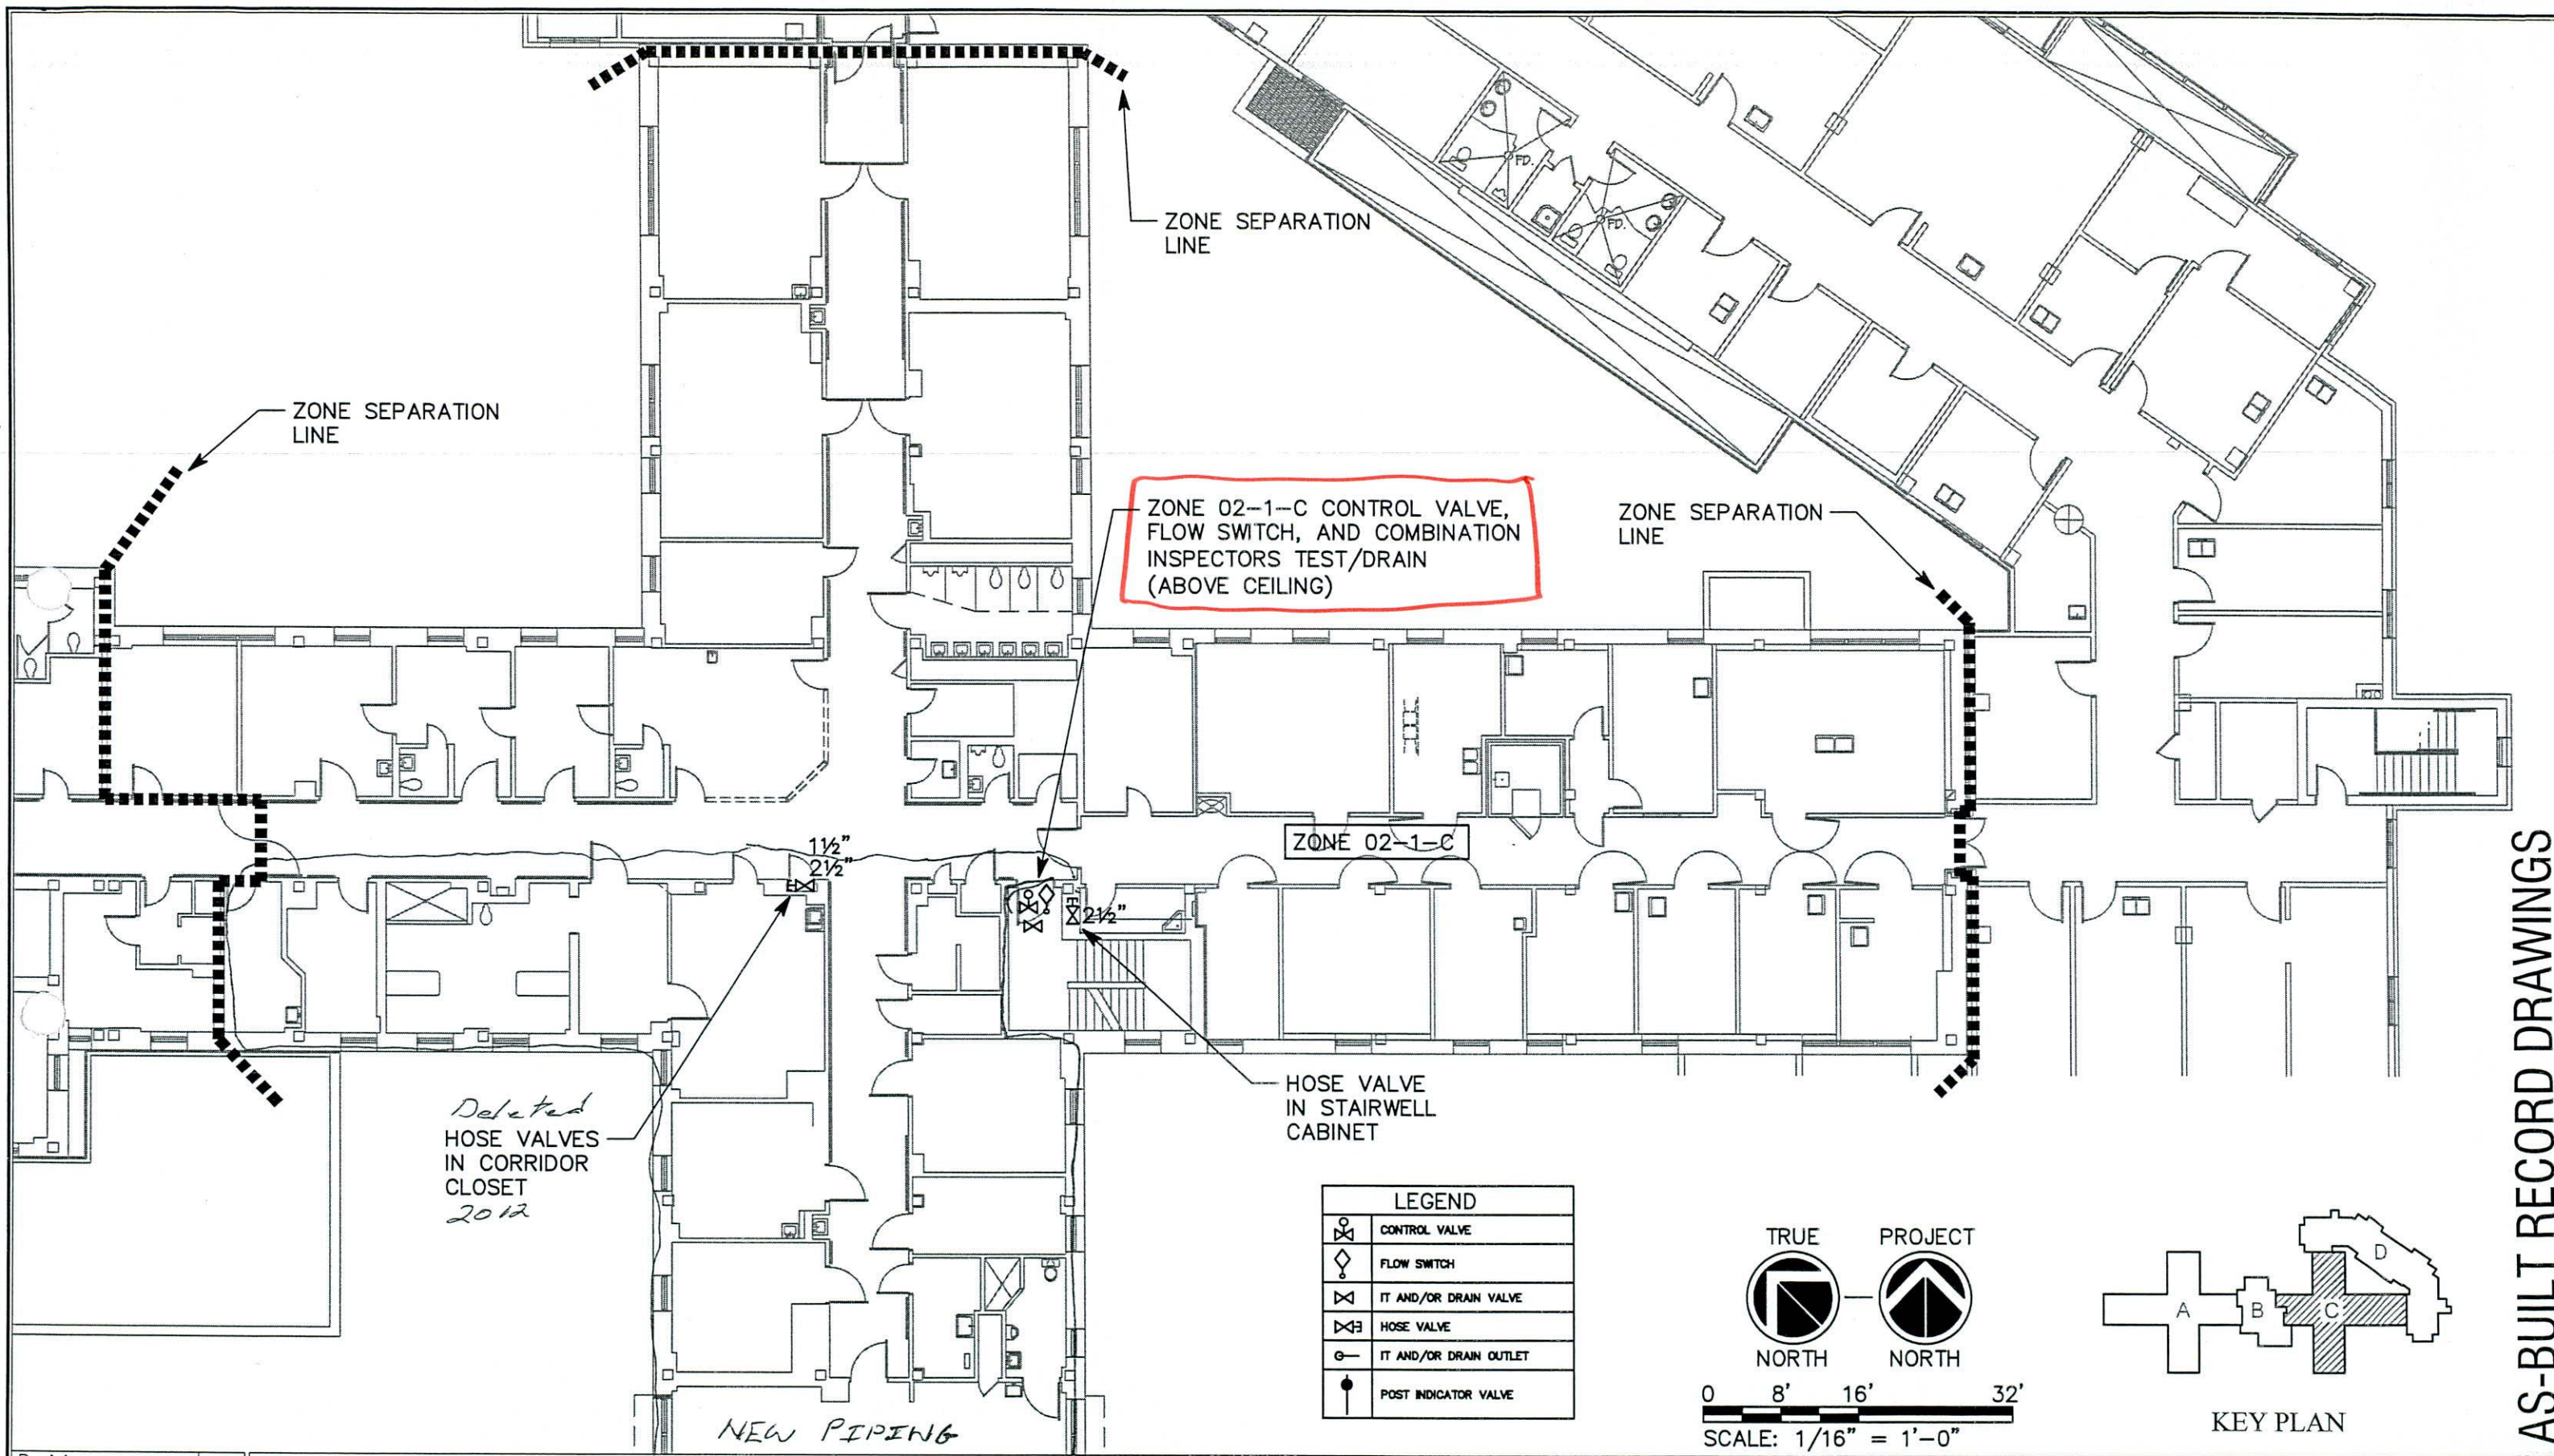


File Name: P:\2010\2010010195\Drawings\Bldg 2\3Sheet\95F.02.2c.dwg Last Plotted: 2010/11/01 12:25 PM By: jdd

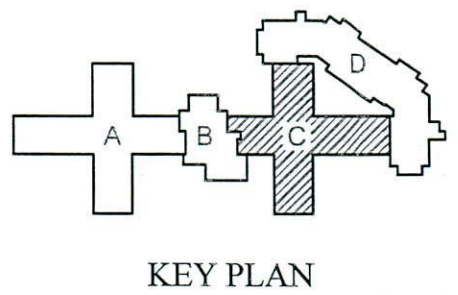

LEGEND	
	CONTROL VALVE
	FLOW SWITCH
	IT AND/OR DRAIN VALVE
	HOSE VALVE
	IT AND/OR DRAIN OUTLET
	POST INDICATOR VALVE

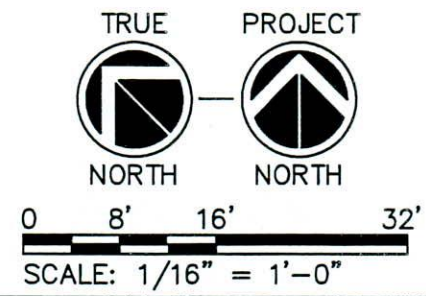

Revisions	
	Date
	Date

Consultant  
  
324 South State Street, Suite 400  
Salt Lake City, Utah 84111  
801.328.5151  
800.678.7077  
FAX 801.328.5155  
www.spectrum-engineers.com

Project Title CAMPUS WIDE FIRE SPRINKLING TEST STATION MODIFICATION AND DEFICIENCIES STUDY	
Consultant Project No. 20100195	
Drawn BXW	Checked JDD

Drawing Title BUILDING 2 FIRST LEVEL ZONE C	Date 08.03.2010	DRAWING No. <b>F.02.2C</b> Dep. of XX
	Project No. 660-10-110	
	Building No. <b>2</b>	
		Department of Veterans Affairs

AS-BUILT RECORD DRAWINGS