

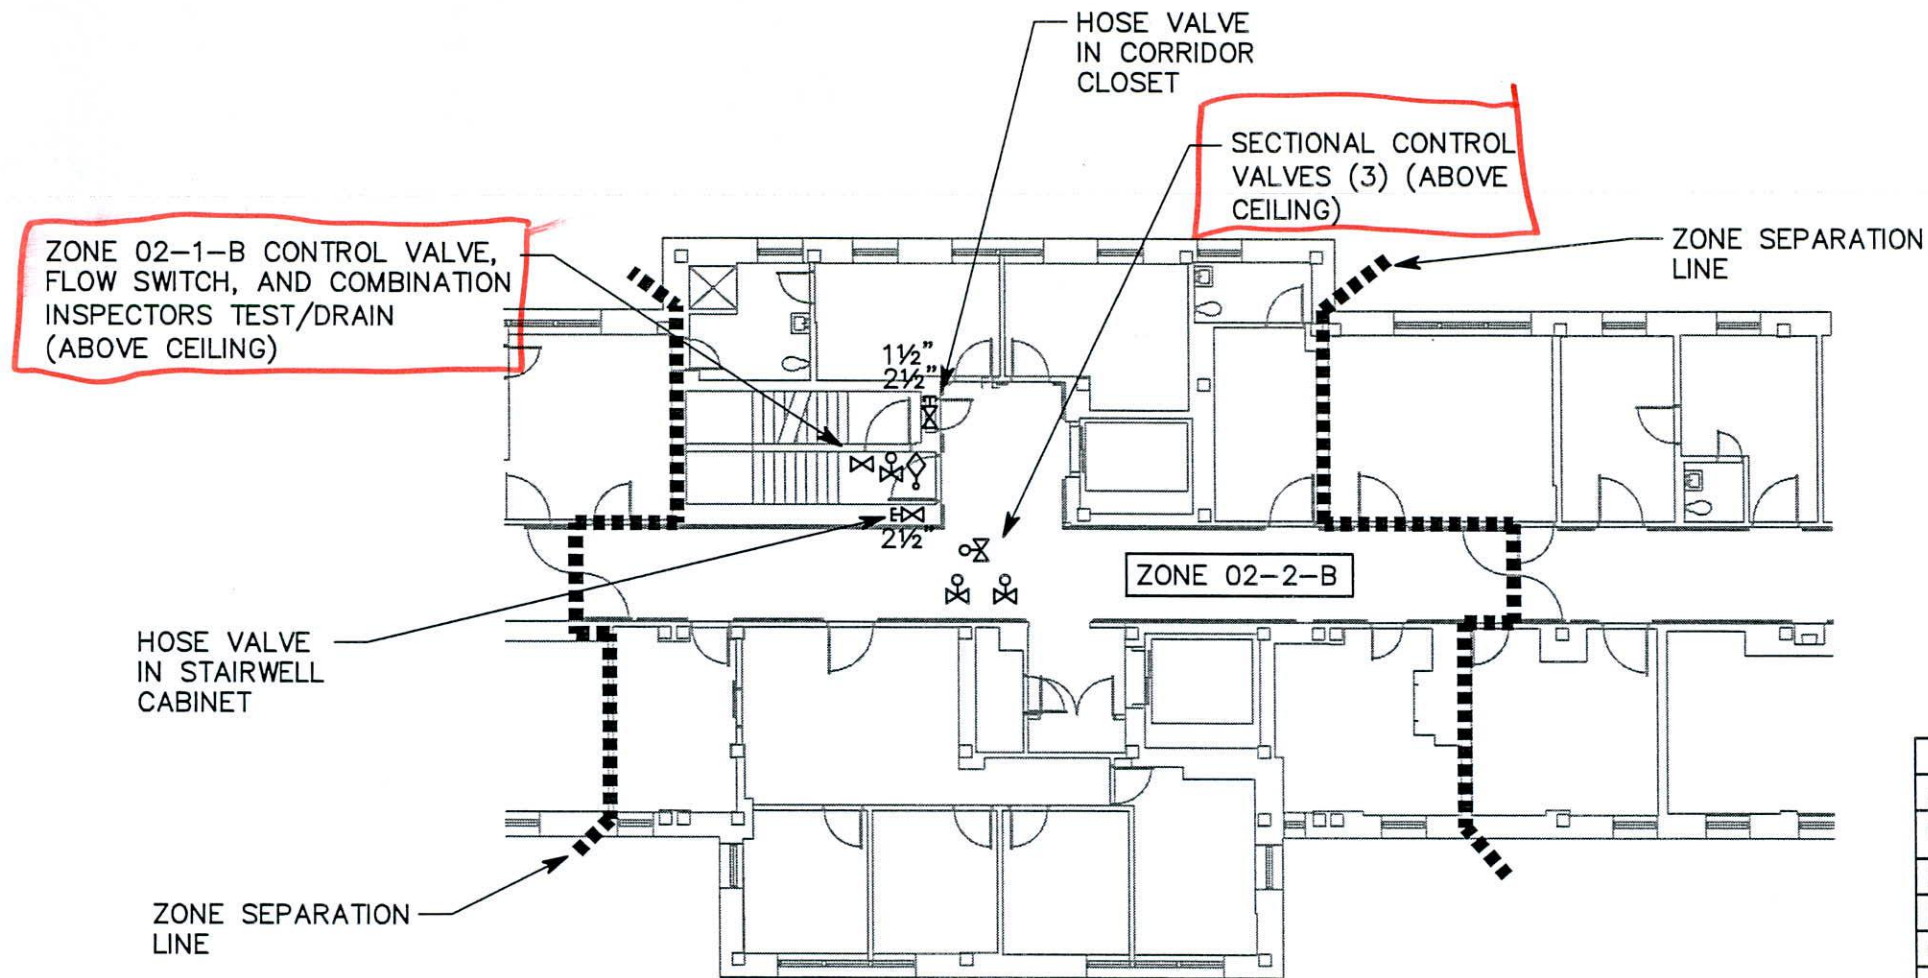


File Name: P:\2010\20100195\Drawings\Bldg 2\3Sheet\95F.02.3b.dwg Last Plotted: 2010/11/01 12:24 PM By: jdd

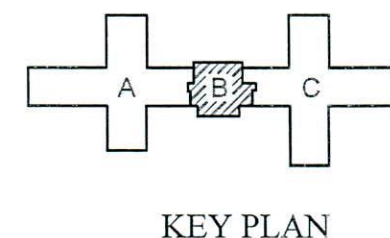

LEGEND	
	CONTROL VALVE
	FLOW SWITCH
	IT AND/OR DRAIN VALVE
	HOSE VALVE
	IT AND/OR DRAIN OUTLET
	POST INDICATOR VALVE

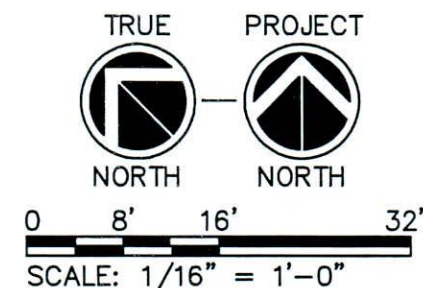

Revisions	Date

Consultant

324 South State Street, Suite 400
Salt Lake City, Utah 84111
801.328.5151
800.678.7077
FAX 801.328.5155
www.spectrum-engineers.com

Project Title CAMPUS WIDE FIRE SPRINKLING TEST STATION MODIFICATION AND DEFICIENCIES STUDY	
Consultant Project No. 20100195	
Drawn BXW	Checked JDD

Drawing Title BUILDING 2 SECOND LEVEL ZONE B	Date 08.03.2010
	Project No. 660-10-110
	Building No. 2

DRAWING No.
F.02.3B
Page 1 of 1

Department of Veterans Affairs

AS-BUILT RECORD DRAWINGS