



Name: P:\2010\20100195\Drawings\Bldg 3\Sheet\95F.03.1c.dwg Last Plotted: 2010/11/01 @ 12:24 PM By: jdd

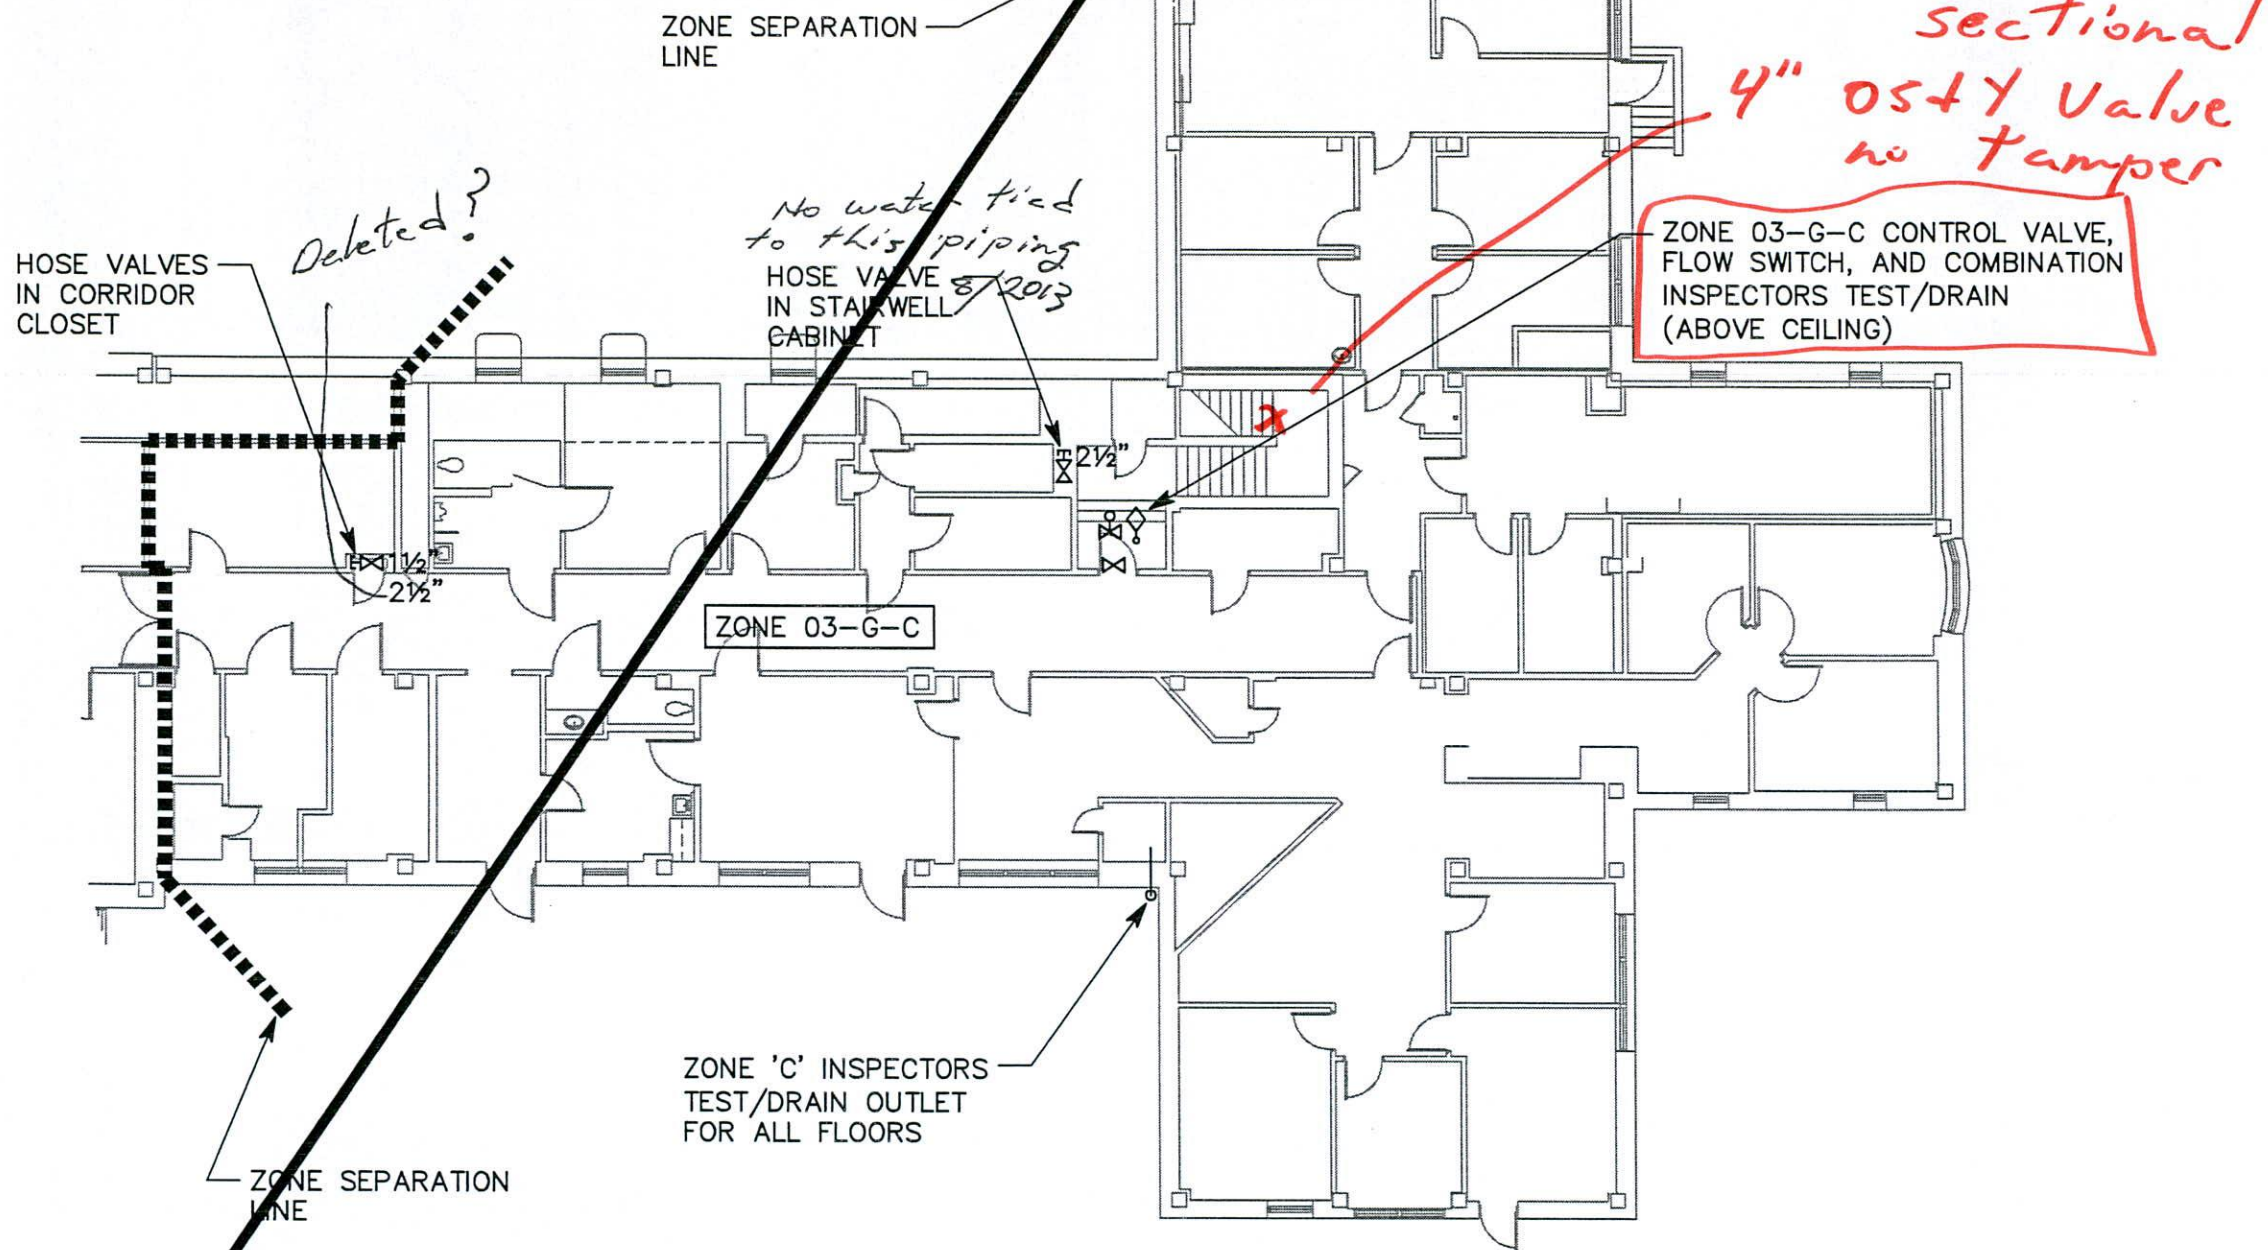

LEGEND	
	CONTROL VALVE
	FLOW SWITCH
	IT AND/OR DRAIN VALVE
	HOSE VALVE
	IT AND/OR DRAIN OUTLET
	POST INDICATOR VALVE

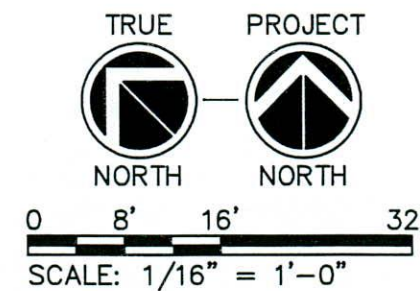

Revisions

Date
Date



324 South State Street, Suite 400
Salt Lake City, Utah 84111
801.328.5151
800.678.7077
FAX 801.328.5155
www.spectrum-engineers.com

Project Title
CAMPUS WIDE FIRE SPRINKLING TEST STATION
MODIFICATION AND DEFICIENCIES STUDY

Consultant Project No. 20100195

Drawn BXW

Checked JDD

Drawing Title
BUILDING 3
GROUND LEVEL
ZONE C

Date
08.03.2010
Project No.
660-10-110
Building No.
3



AS-BUILT RECORD DRAWINGS
Department of
Veterans Affairs