
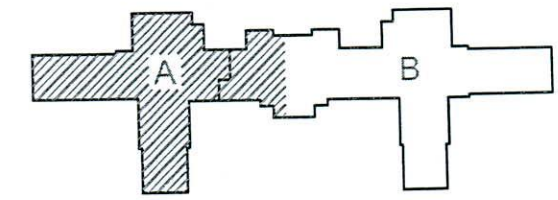
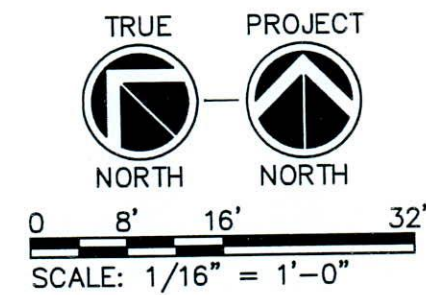


File Name: P:\2010\2010010195\Drawings\Bldg 4\Sheet\95F.04.2a.dwg Last Plotted: 2010/11/01 @ 12:23 PM By: jdd

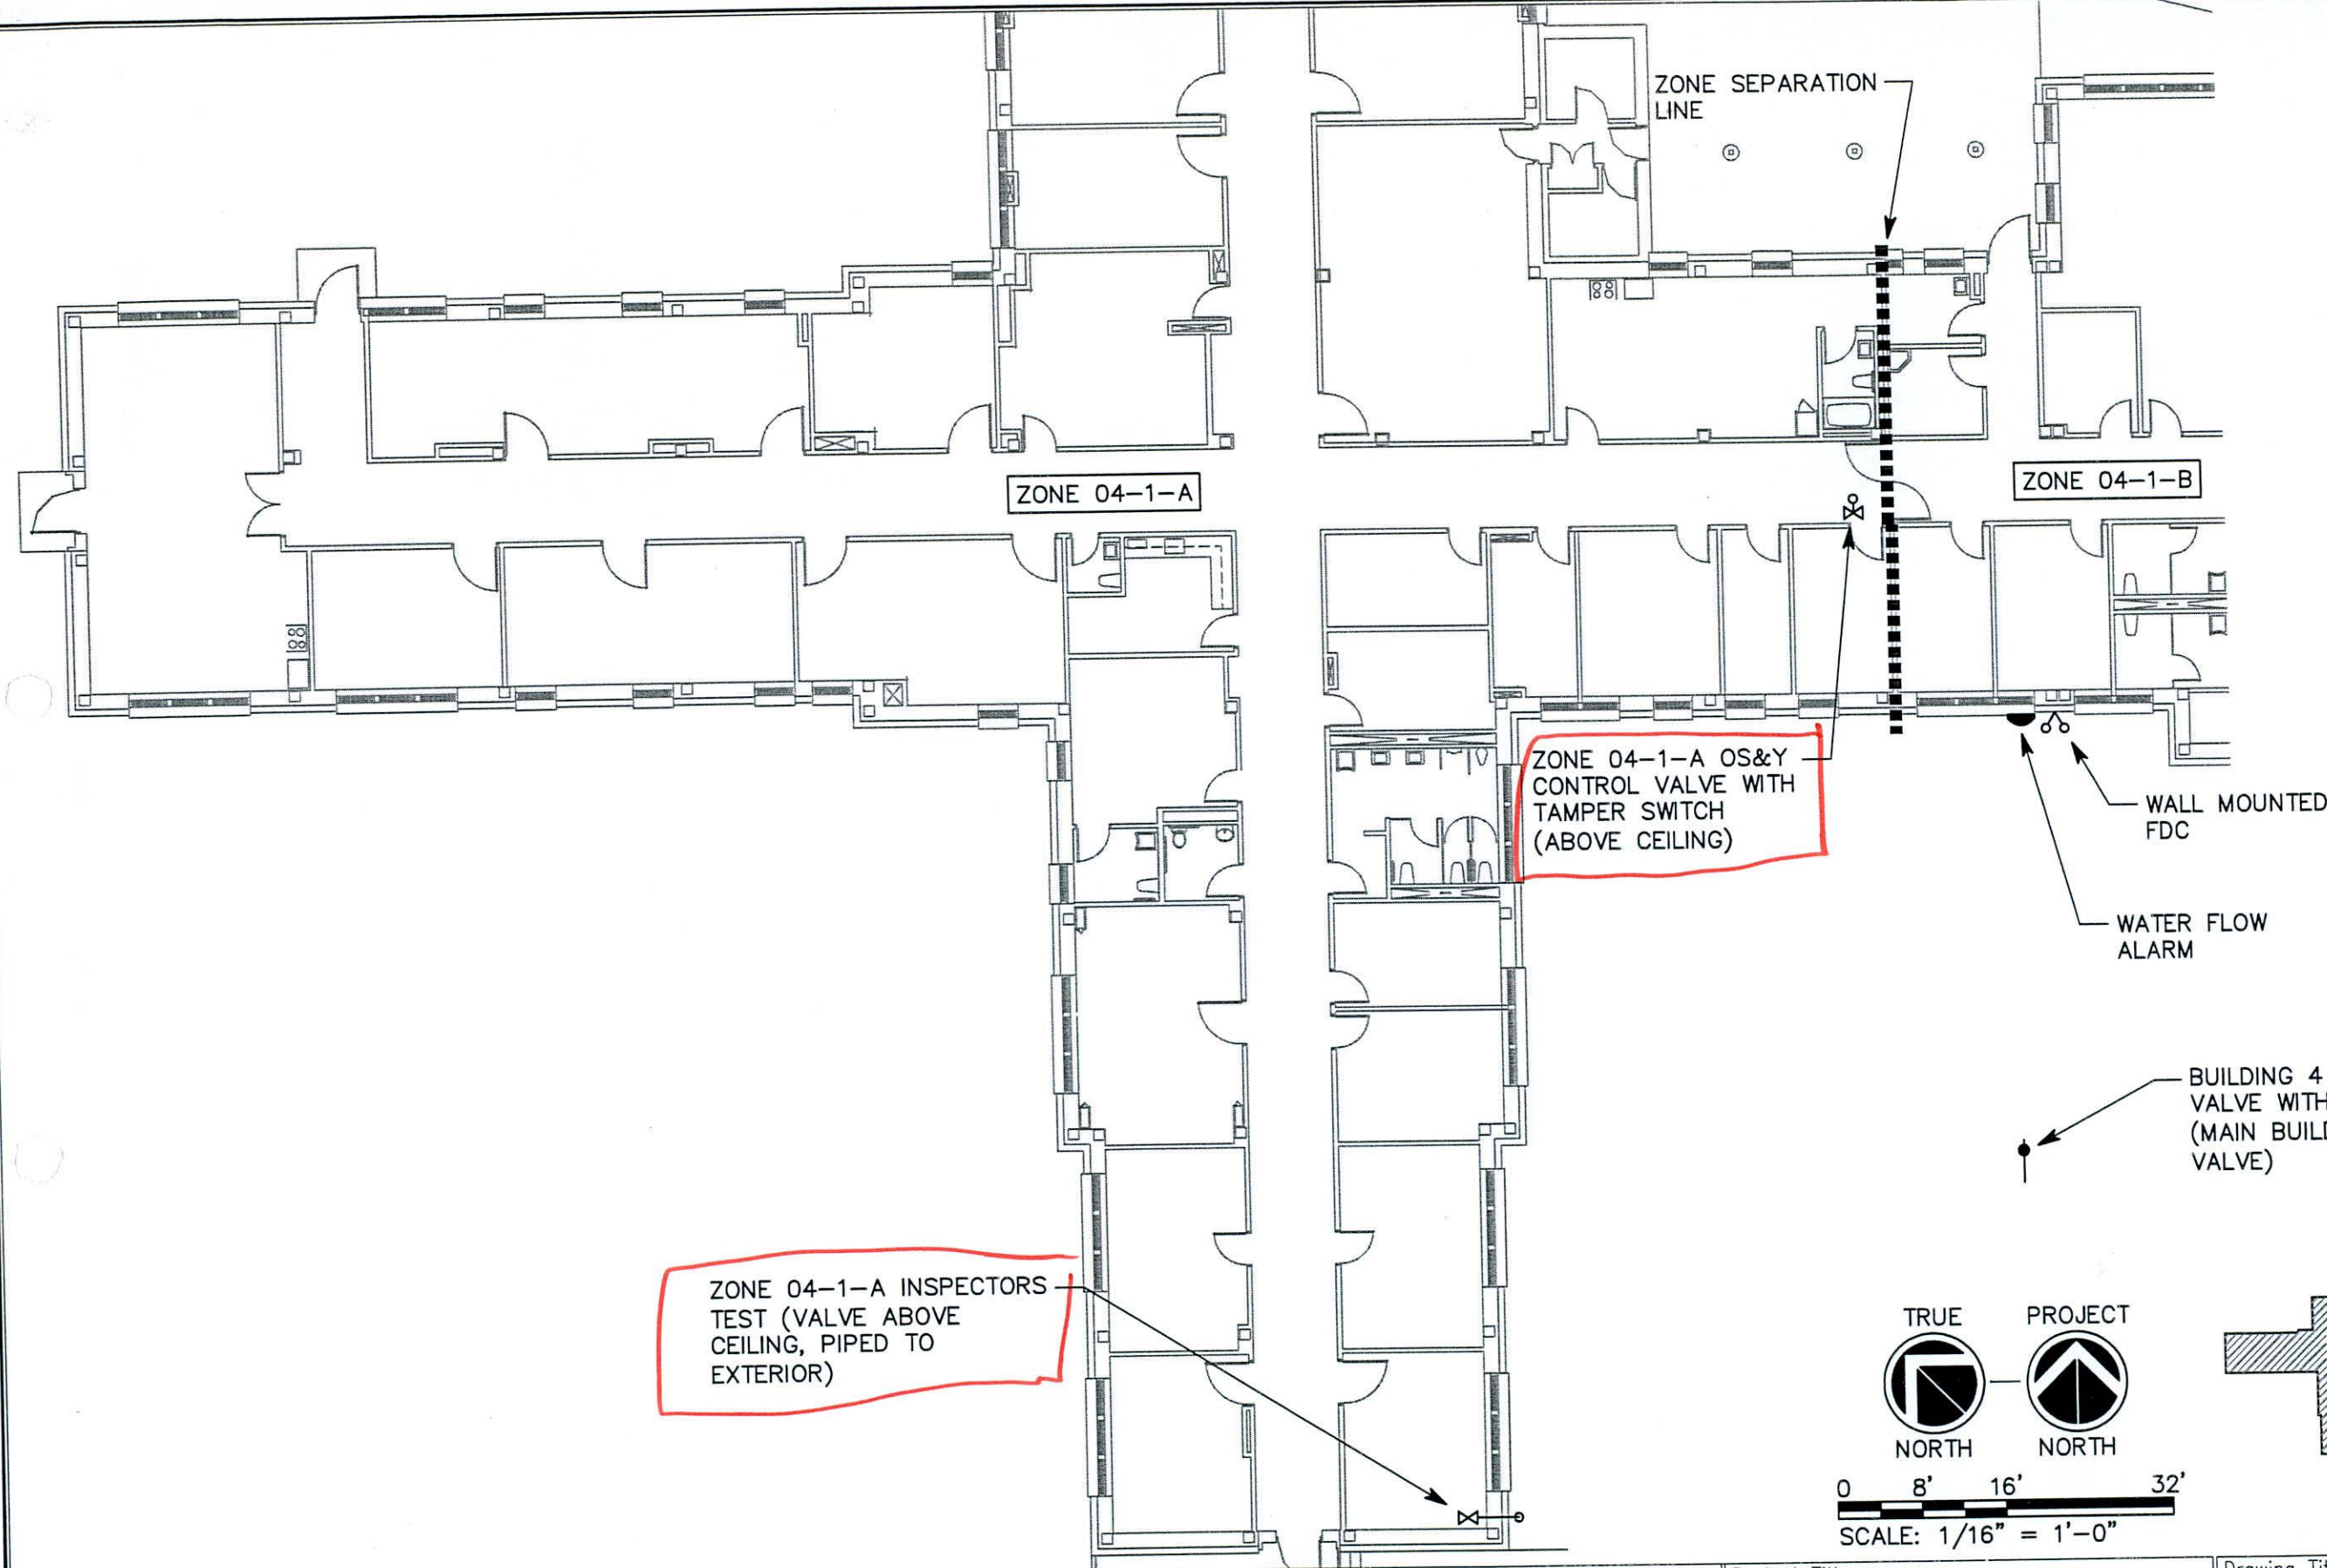

Revisions	Date

Consultant  
**SPECTRUM**  
ENGINEERS  
324 South State Street, Suite 400  
Salt Lake City, Utah 84111  
801.328.5151  
800.678.7077  
FAX 801.328.5155  
www.spectrum-engineers.com

Project Title  
CAMPUS WIDE FIRE SPRINKLING TEST STATION  
MODIFICATION AND DEFICIENCIES STUDY  
Consultant Project No. 20100195  
Drawn BXW  
Checked JDD

Drawing Title  
BUILDING 4  
FIRST LEVEL  
ZONE A

Date  
08.03.2010  
Project No.  
660-10-110  
Building No.  
4

DRAWING No.  
F.04.2A  
Dep. of XX  
  
Department of

AS-BUILT RECORD DRAWINGS