

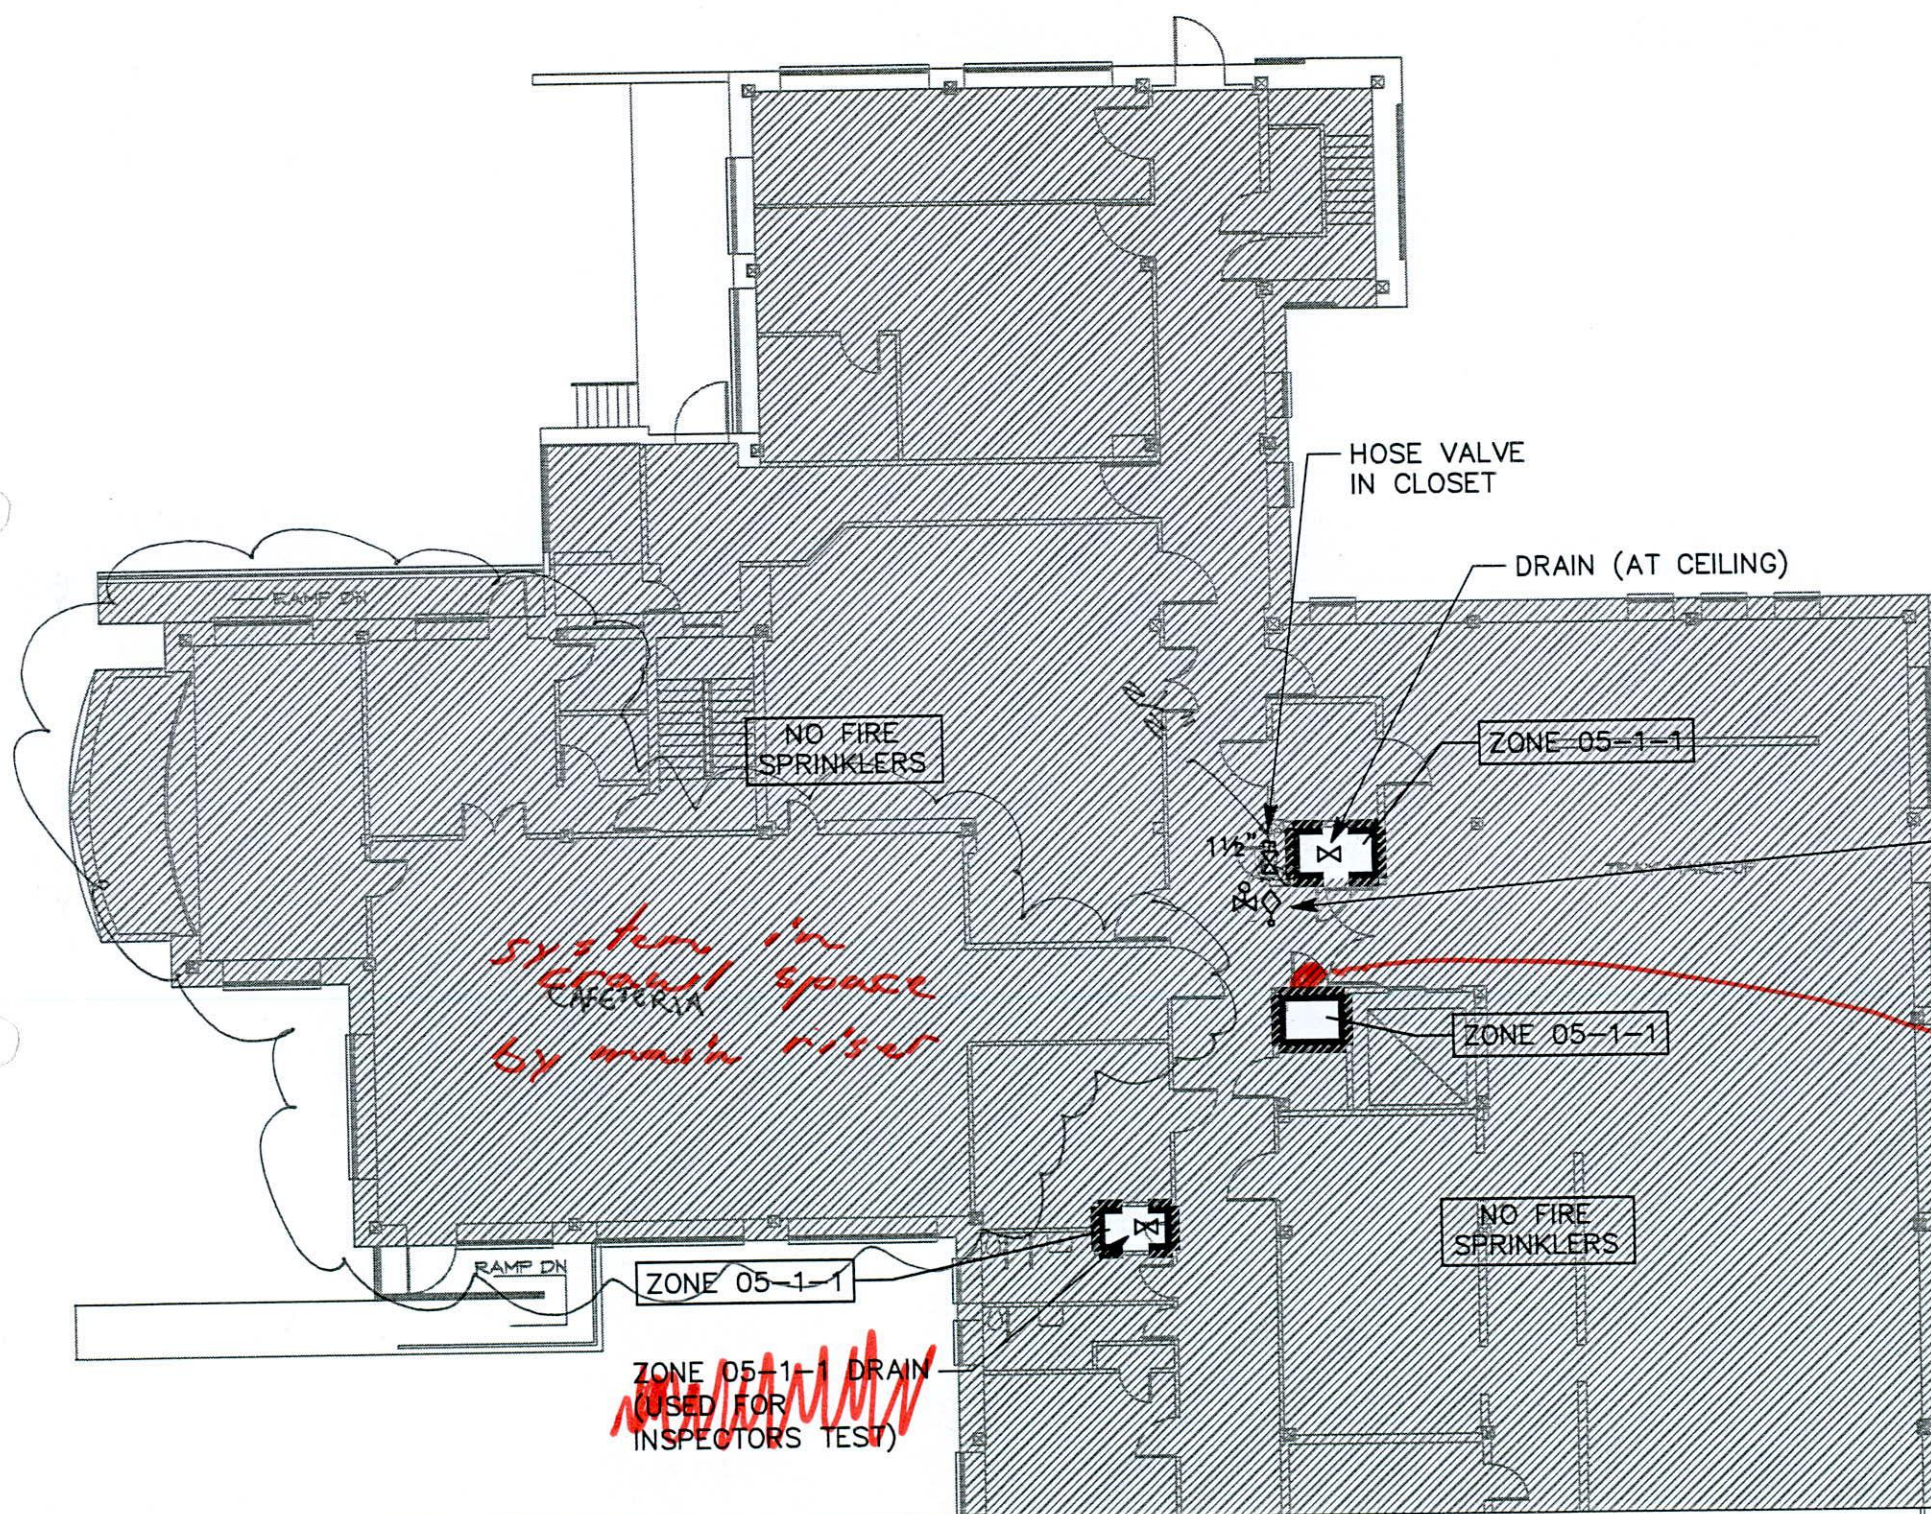


File Name: P:\2010\20100195\Drawings\Bldg 5\3Sheet\95F.05.2a.dwg Last Plotted: 2010/11/01 12:22 PM By: jdd

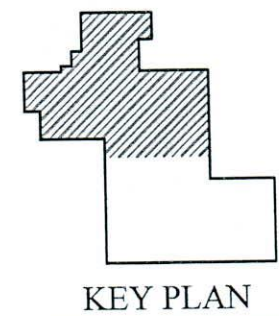

ZONE 05-1-1 OS&Y CONTROL VALVE WITH TAMPER SWITCH (IN CLOSET) AND FLOW SWITCH (ABOVE CEILING)

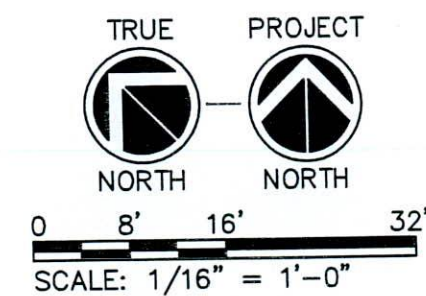

Revisions	Date

Consultant
**SPECTRUM ENGINEERS**
324 South State Street, Suite 400
Salt Lake City, Utah 84111
801.328.5151
800.678.7077
FAX 801.328.5155
www.spectrum-engineers.com

Project Title CAMPUS WIDE FIRE SPRINKLING TEST STATION MODIFICATION AND DEFICIENCIES STUDY	
Consultant Project No. 20100195	
Drawn BXW	Checked JDD

Drawing Title BUILDING 5 FIRST LEVEL ZONE 1
--

Date 08.03.2010
Project No. 660-10-110
Building No. 5

DRAWING No. **F.05.2A**
Dep. of **VAMC**
Department of

AS-BUILT RECORD DRAWINGS