

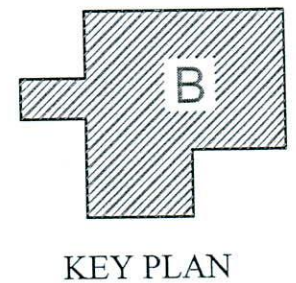


File Name: P:\2010\20100195\Drawings\Bldg 6\3Sheet\95F.06.0.dwg Last Plotted: 2010/11/01 12:22 PM By: jld

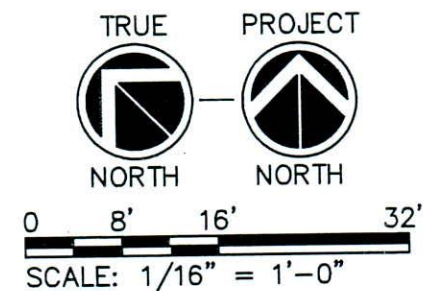

Revisions	Date
	Date

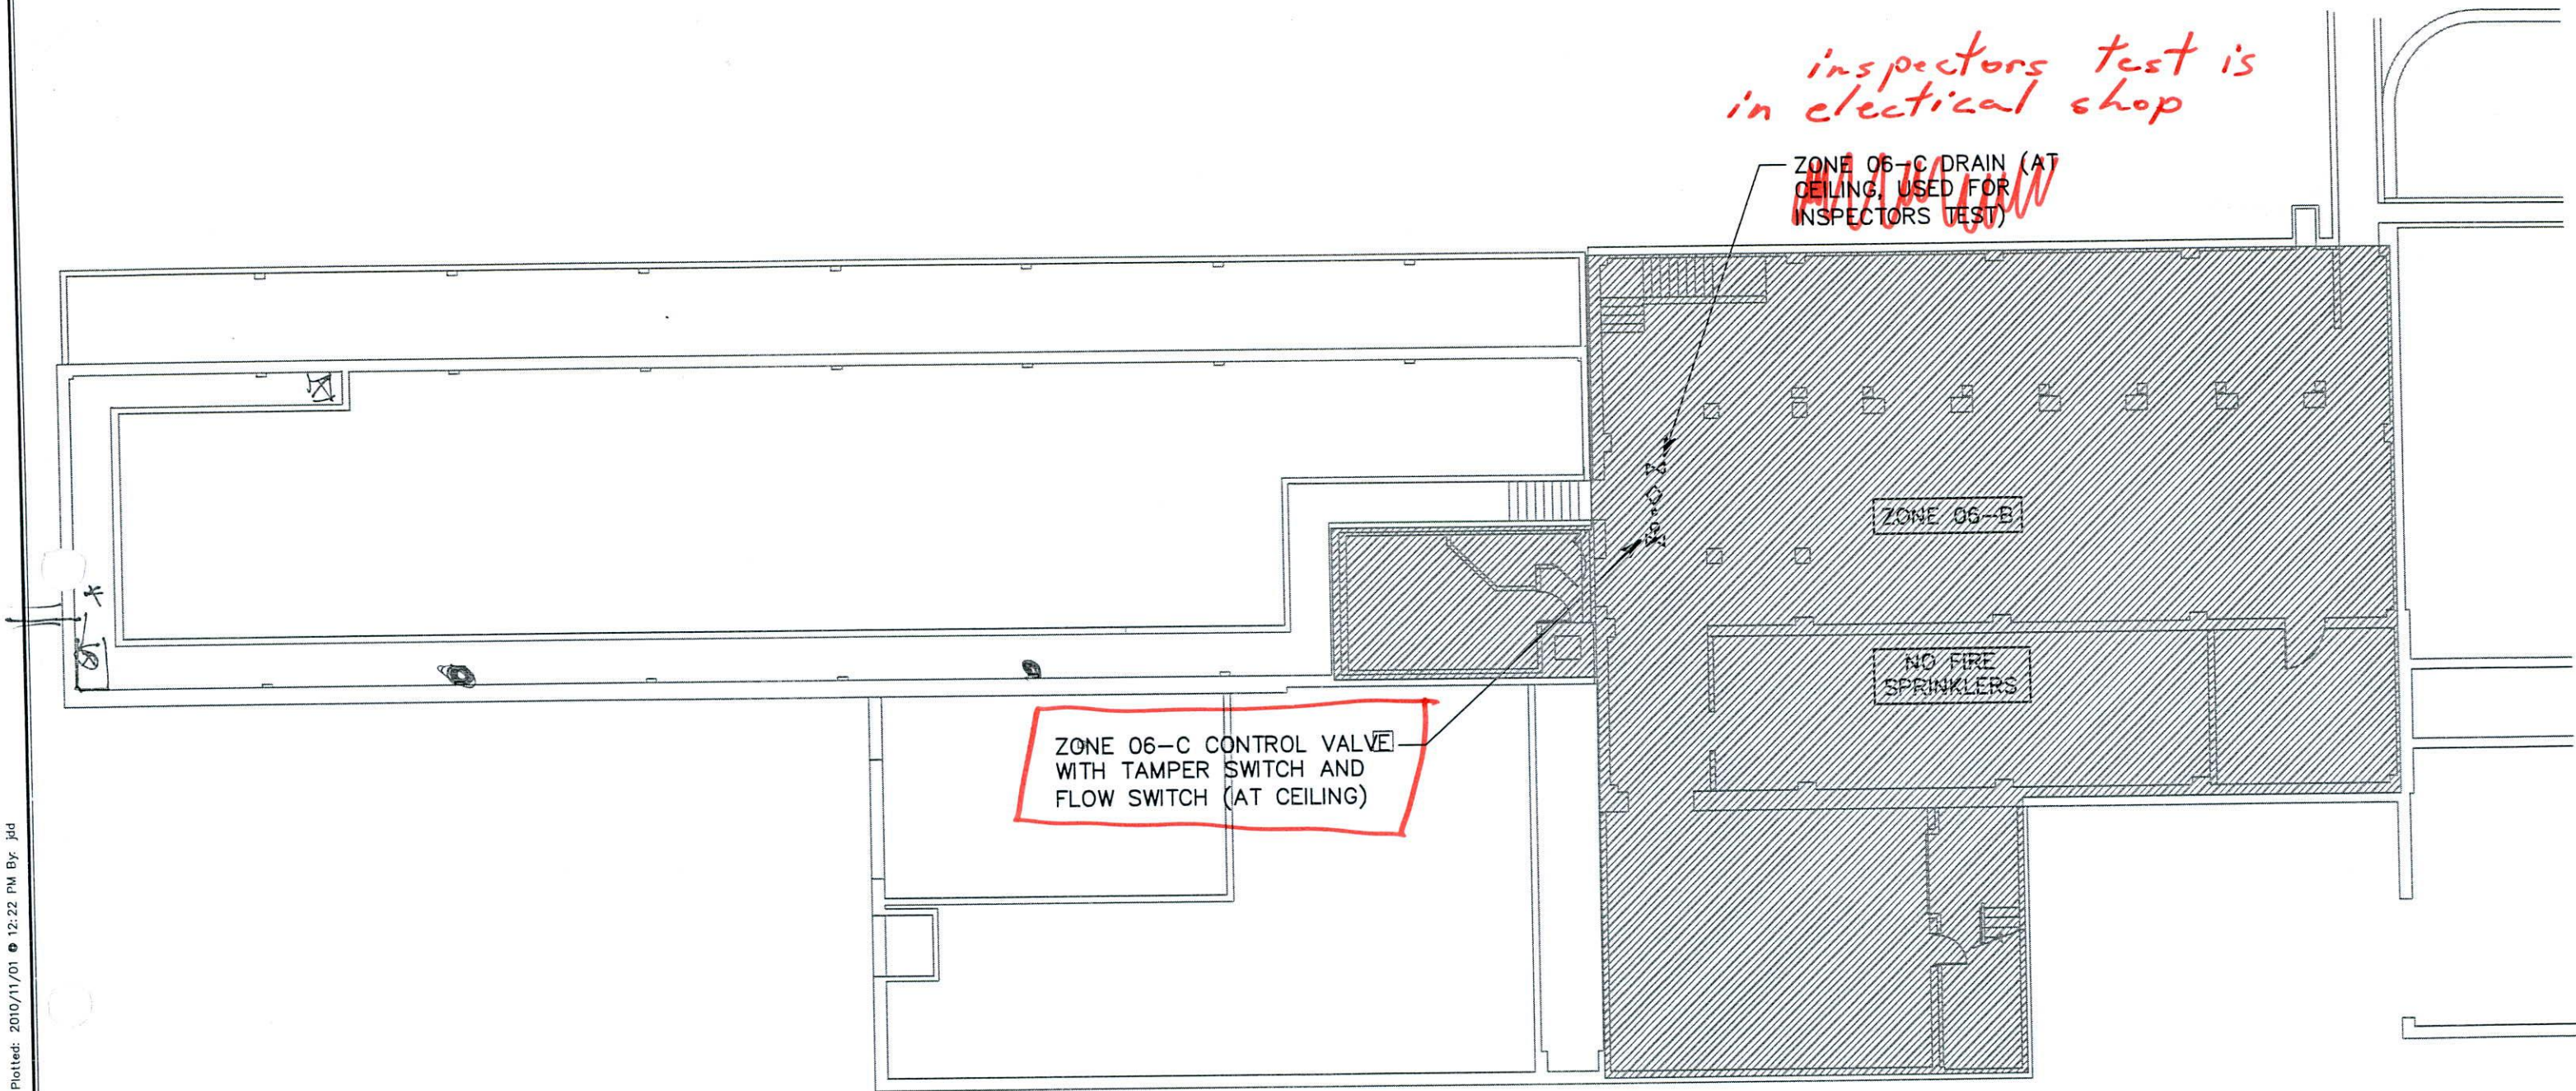

324 South State Street, Suite 400  
Salt Lake City, Utah 84111  
801.328.5151  
800.678.7077  
FAX 801.328.5155  
www.spectrum-engineers.com

Project Title CAMPUS WIDE FIRE SPRINKLING TEST STATION MODIFICATION AND DEFICIENCIES STUDY	
Consultant Project No. 20100195	
Drawn BXW	Checked JDD

Drawing Title  
BUILDING 6  
BASEMENT  
ZONE B

Date 08.03.2010  
Project No. 660-10-110  
Building No. 6

DRAWING No. F.06.0  
Dep. of XX  
VAMC  
TO QUALITY

AS-BUILT RECORD DRAWINGS