
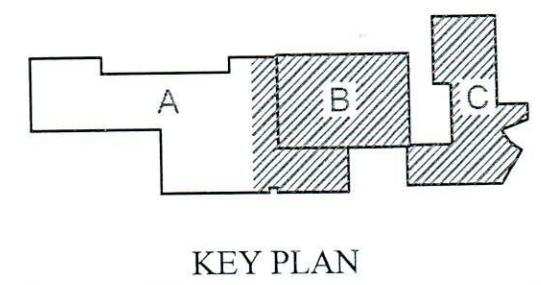
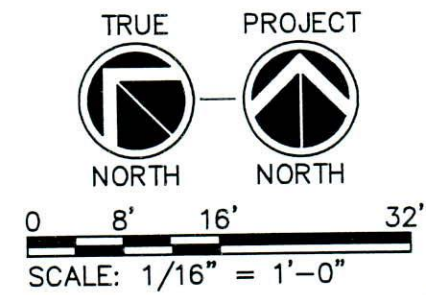


File Name: P:\2010\20100195\Drawings\Bldg 6\Sheet\95F.06.1b.dwg Last Plotted: 2010/11/01 @ 12:22 PM By: jdd

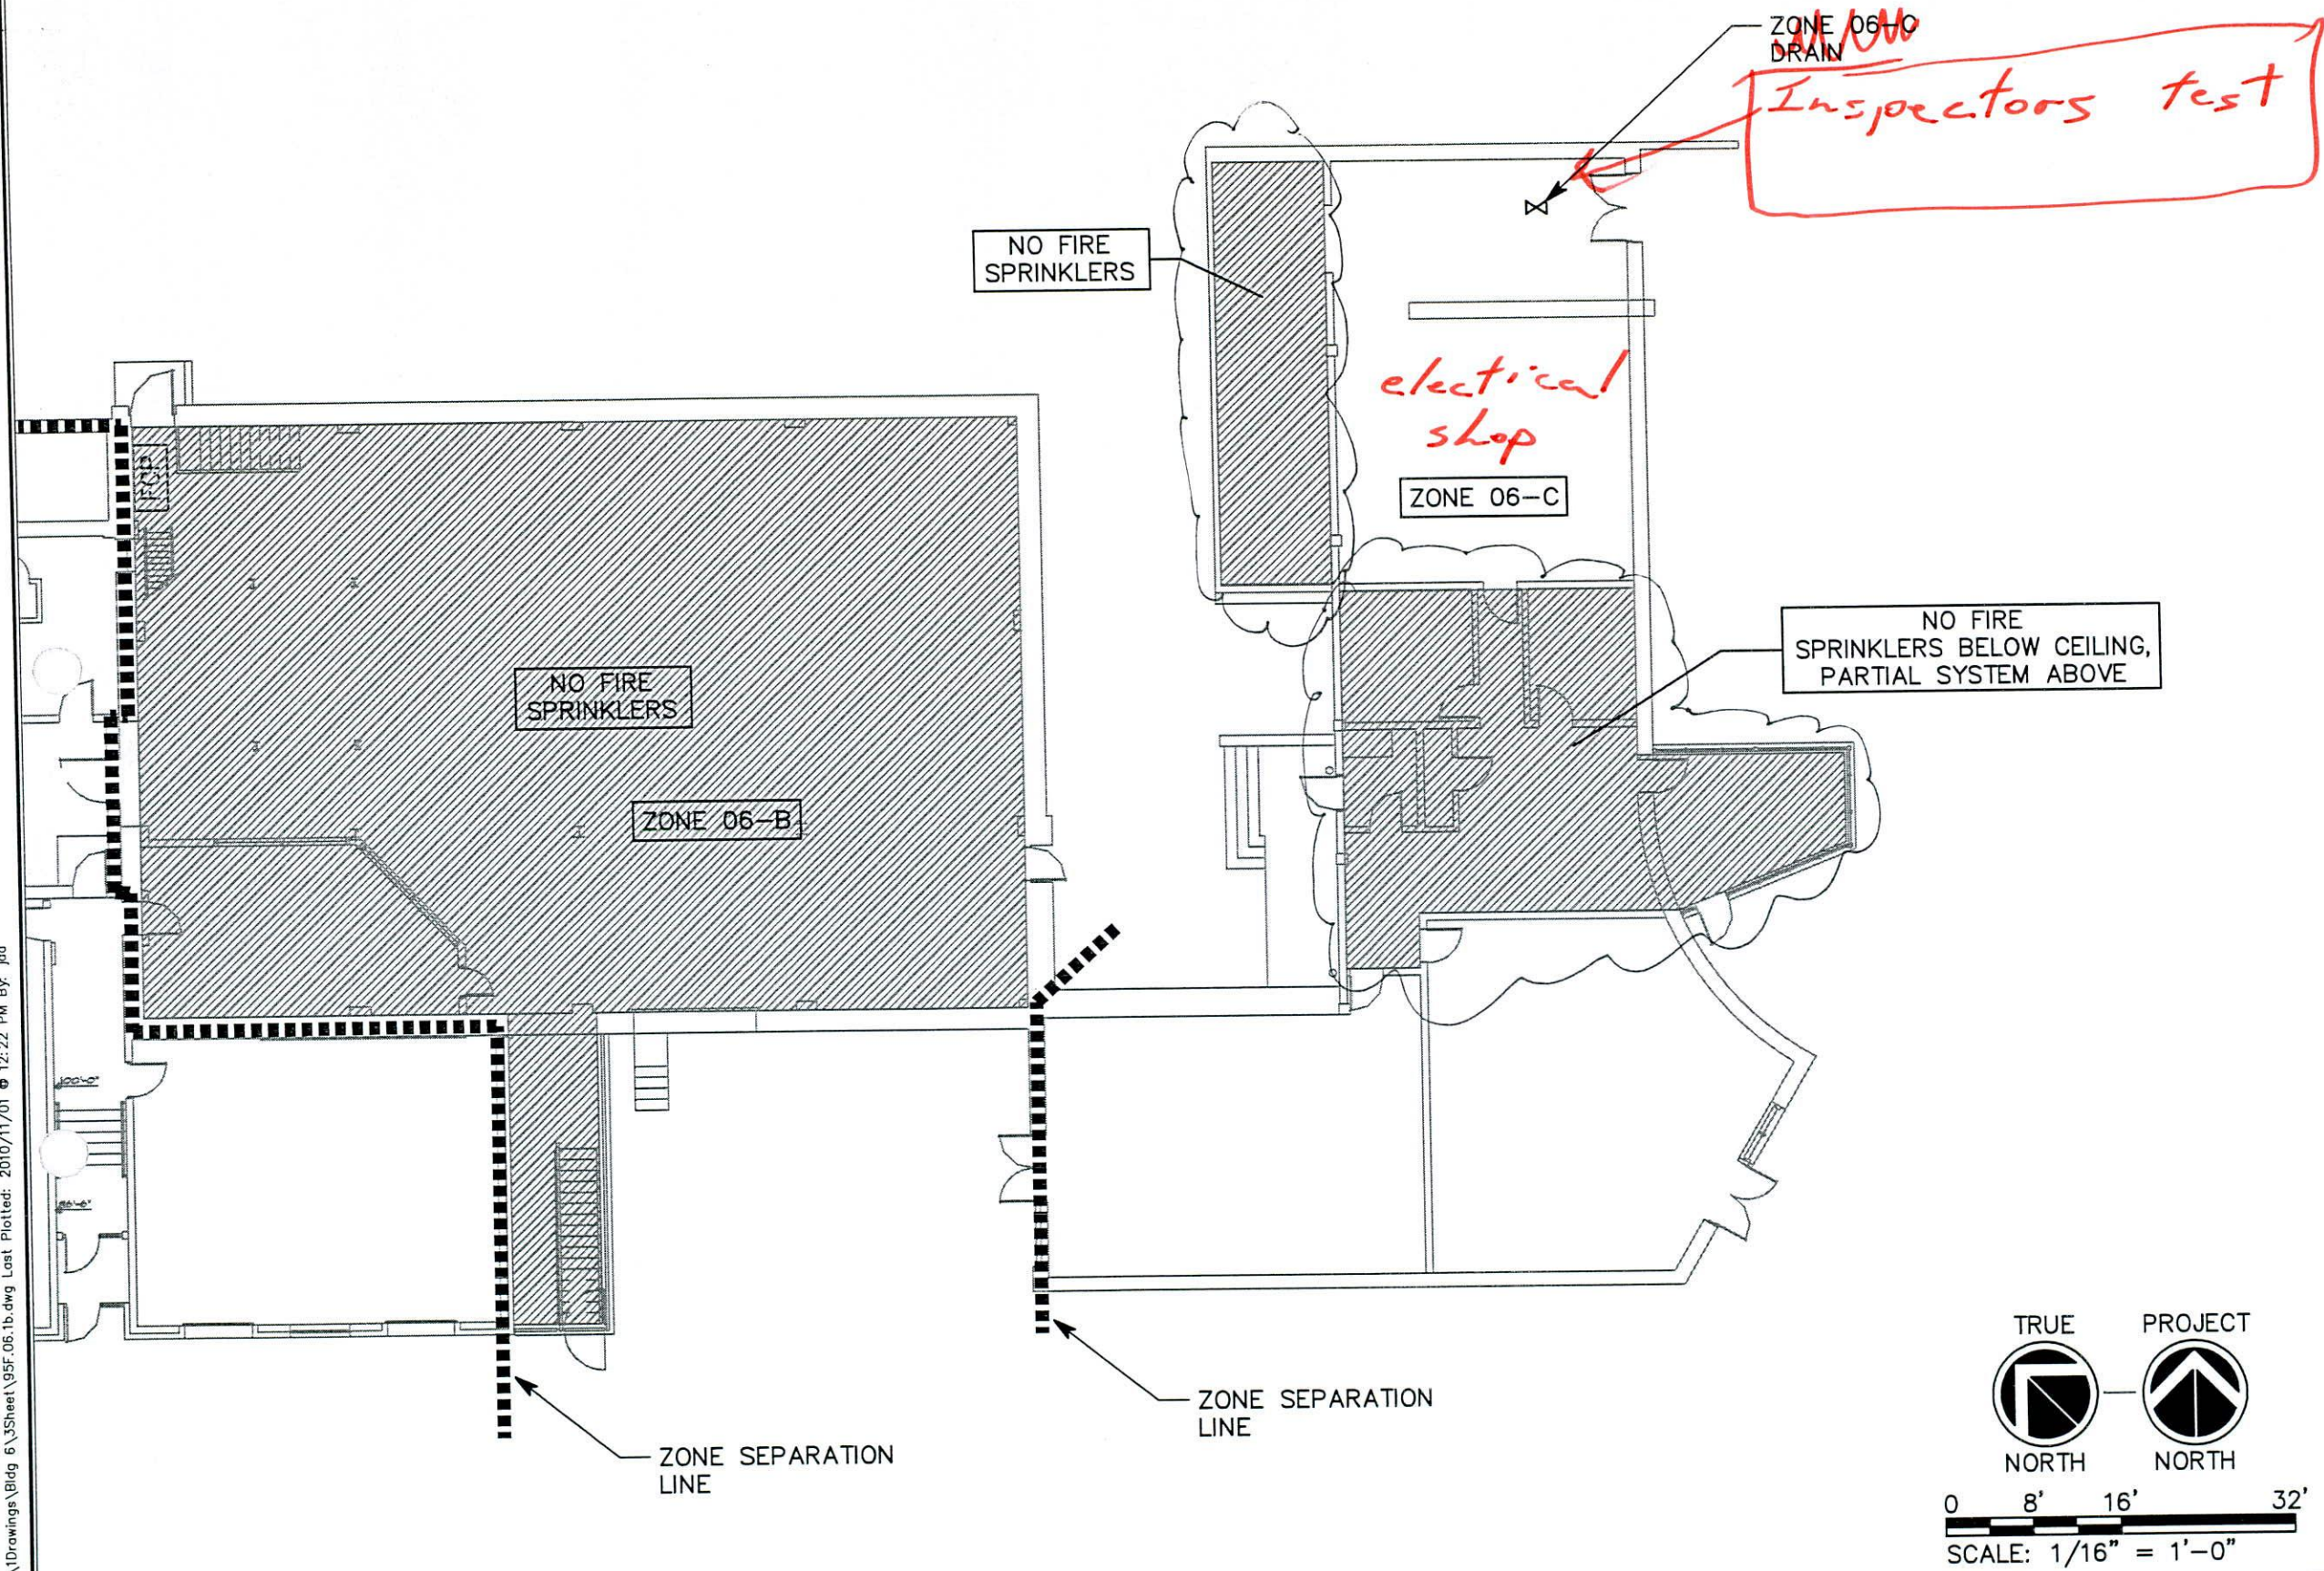

Revisions	Date

Consultant
**SPECTRUM**
ENGINEERS
324 South State Street, Suite 400
Salt Lake City, Utah 84111
801.328.5151
800.678.7077
FAX 801.328.5155
www.spectrum-engineers.com

Project Title CAMPUS WIDE FIRE SPRINKLING TEST STATION MODIFICATION AND DEFICIENCIES STUDY	
Consultant Project No. 20100195	
Drawn BXW	Checked JDD

Drawing Title BUILDING 6 FIRST LEVEL ZONE B & C
--

Date 08.03.2010
Project No. 660-10-110
Building No. 6

DRAWING No.
F.06.1B
of XX
**VAMC**
Department of

AS-BUILT RECORD DRAWINGS